
PLAT OF SURVEY

LOT 1, CERTIFIED SURVEY MAP NO. 3069, being a part of the Northwest ¼ of the Southwest ¼ of **Section** 33, Town 4 North, Range 16 East, Walworth County, Wisconsin.

Surveyed for: Dianne Krause

Survey address: N7406 Jackson Road

RECEIVED
JUN 29 2009
By

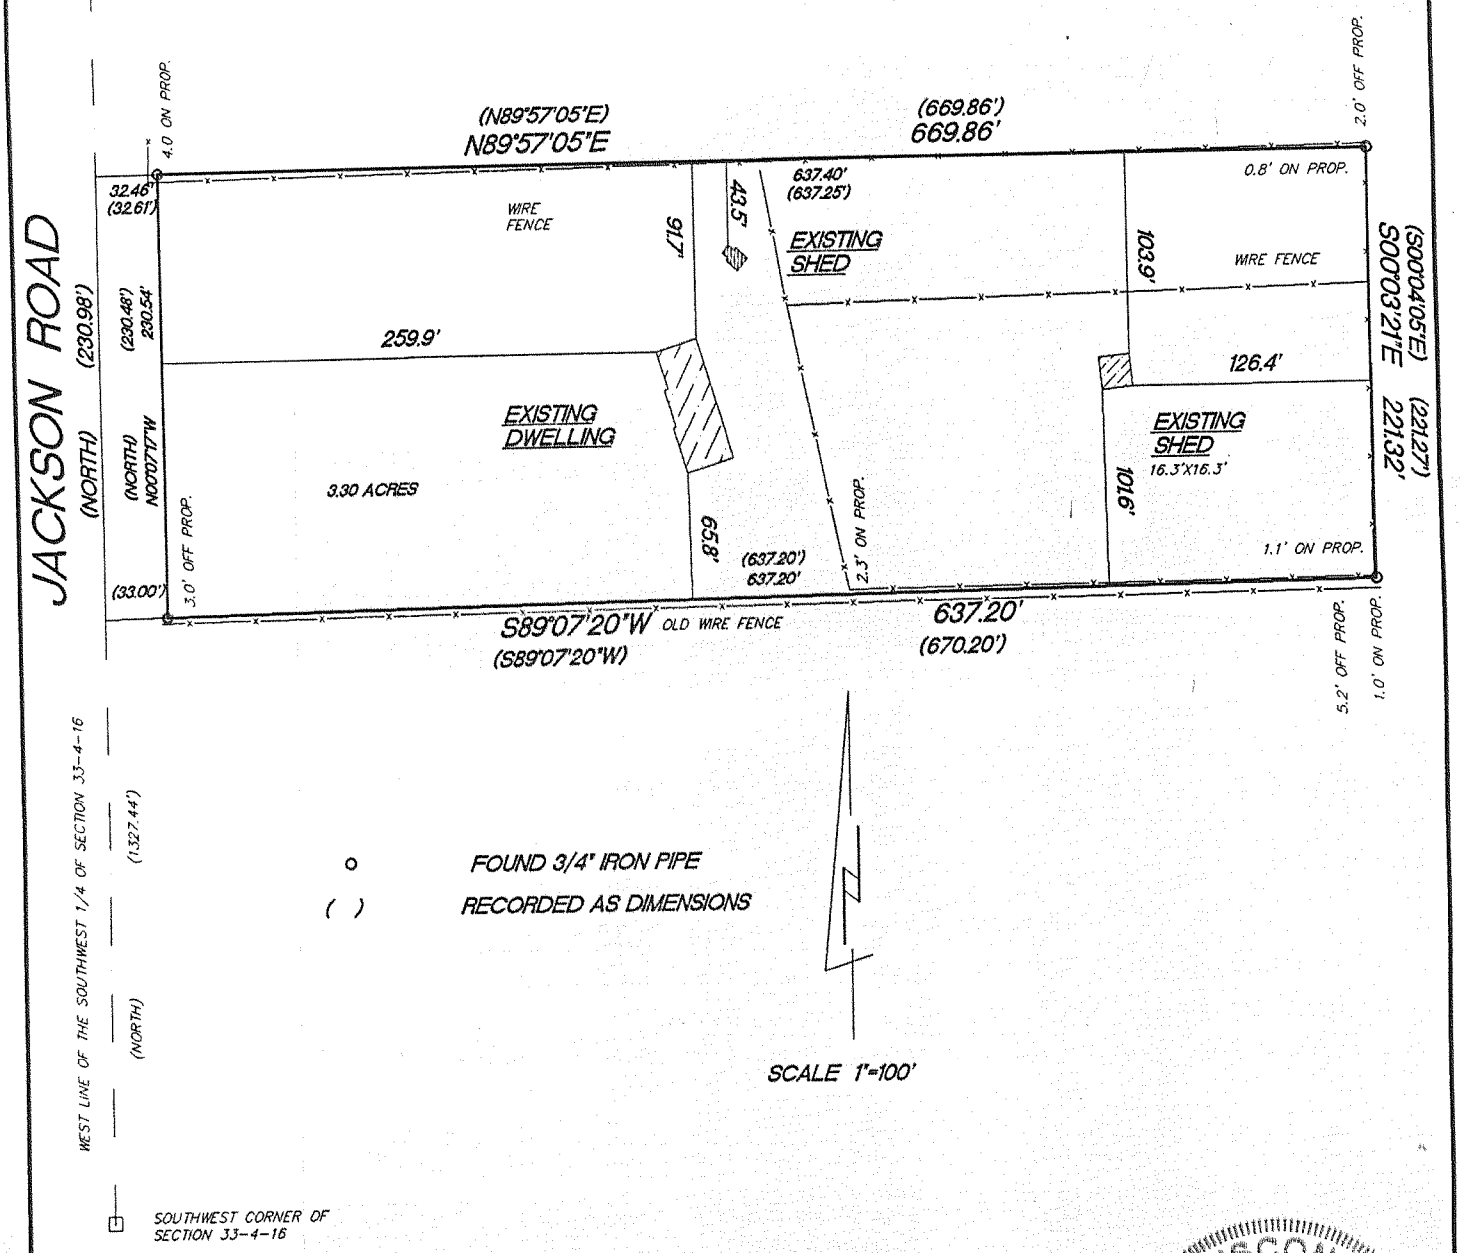

"I hereby certify that I have surveyed the above described property and that the above map is a true representation thereof and shows the size and location of the property, its exterior boundaries, the location of all visible structures and dimension of all principal buildings thereon, boundary fences, apparent easements, roadways and encroachments if any."

"This survey is made for the use of the present owners of the property, and also those who purchase, mortgage or guarantee the title thereto within one year from date hereof."

KETTLE MORAINE SURVEYING INC.
S75 W36245 Wilton Road
Eagle Wisconsin 53119
P.O. Box 357
(262) 594-3484
Terrance E. Pisarek R.L.S.

WISCONSIN
TERRANCE E. PISAREK
S-1930
EAGLE, WISCONSIN
LAND SURVEYOR

THIS IS NOT AN ORIGINAL SURVEY UNLESS THE SEAL IS RED.

REV. 6/10/09 11/26/02	TEP/DW	TEP	02154
DATE	FIELD WORK BY	DRAWN BY	JOB NUMBER

416-2407