
PREPARED FOR:
LE ROUX CONSTRUCTION
144 FOX LANE
WALWORTH, WI 53184

PLAT OF SURVEY

-OF-

LOT 5, BLOCK 1, GREEN LAKE PARK, A SUBDIVISION, LOCATED IN SECTION 26, T.4.N. , R.16.E, TOWN OF LAGRANGE, WALWORTH COUNTY, WISCONSIN. EXCEPTING THE WEST 8 FEET FOR USE OF RIGHT-OF-WAY WITH OTHER OWNERS OF THE PROPERTY IN GREEN LAKE PARK SUBDIVISION.

KROTT SURVEYING INC.
N3705 WILLOW BEND LANE
LAKE GENEVA WI. 53147
PHONE # (262)248-3697
FAX # (262)249-0639

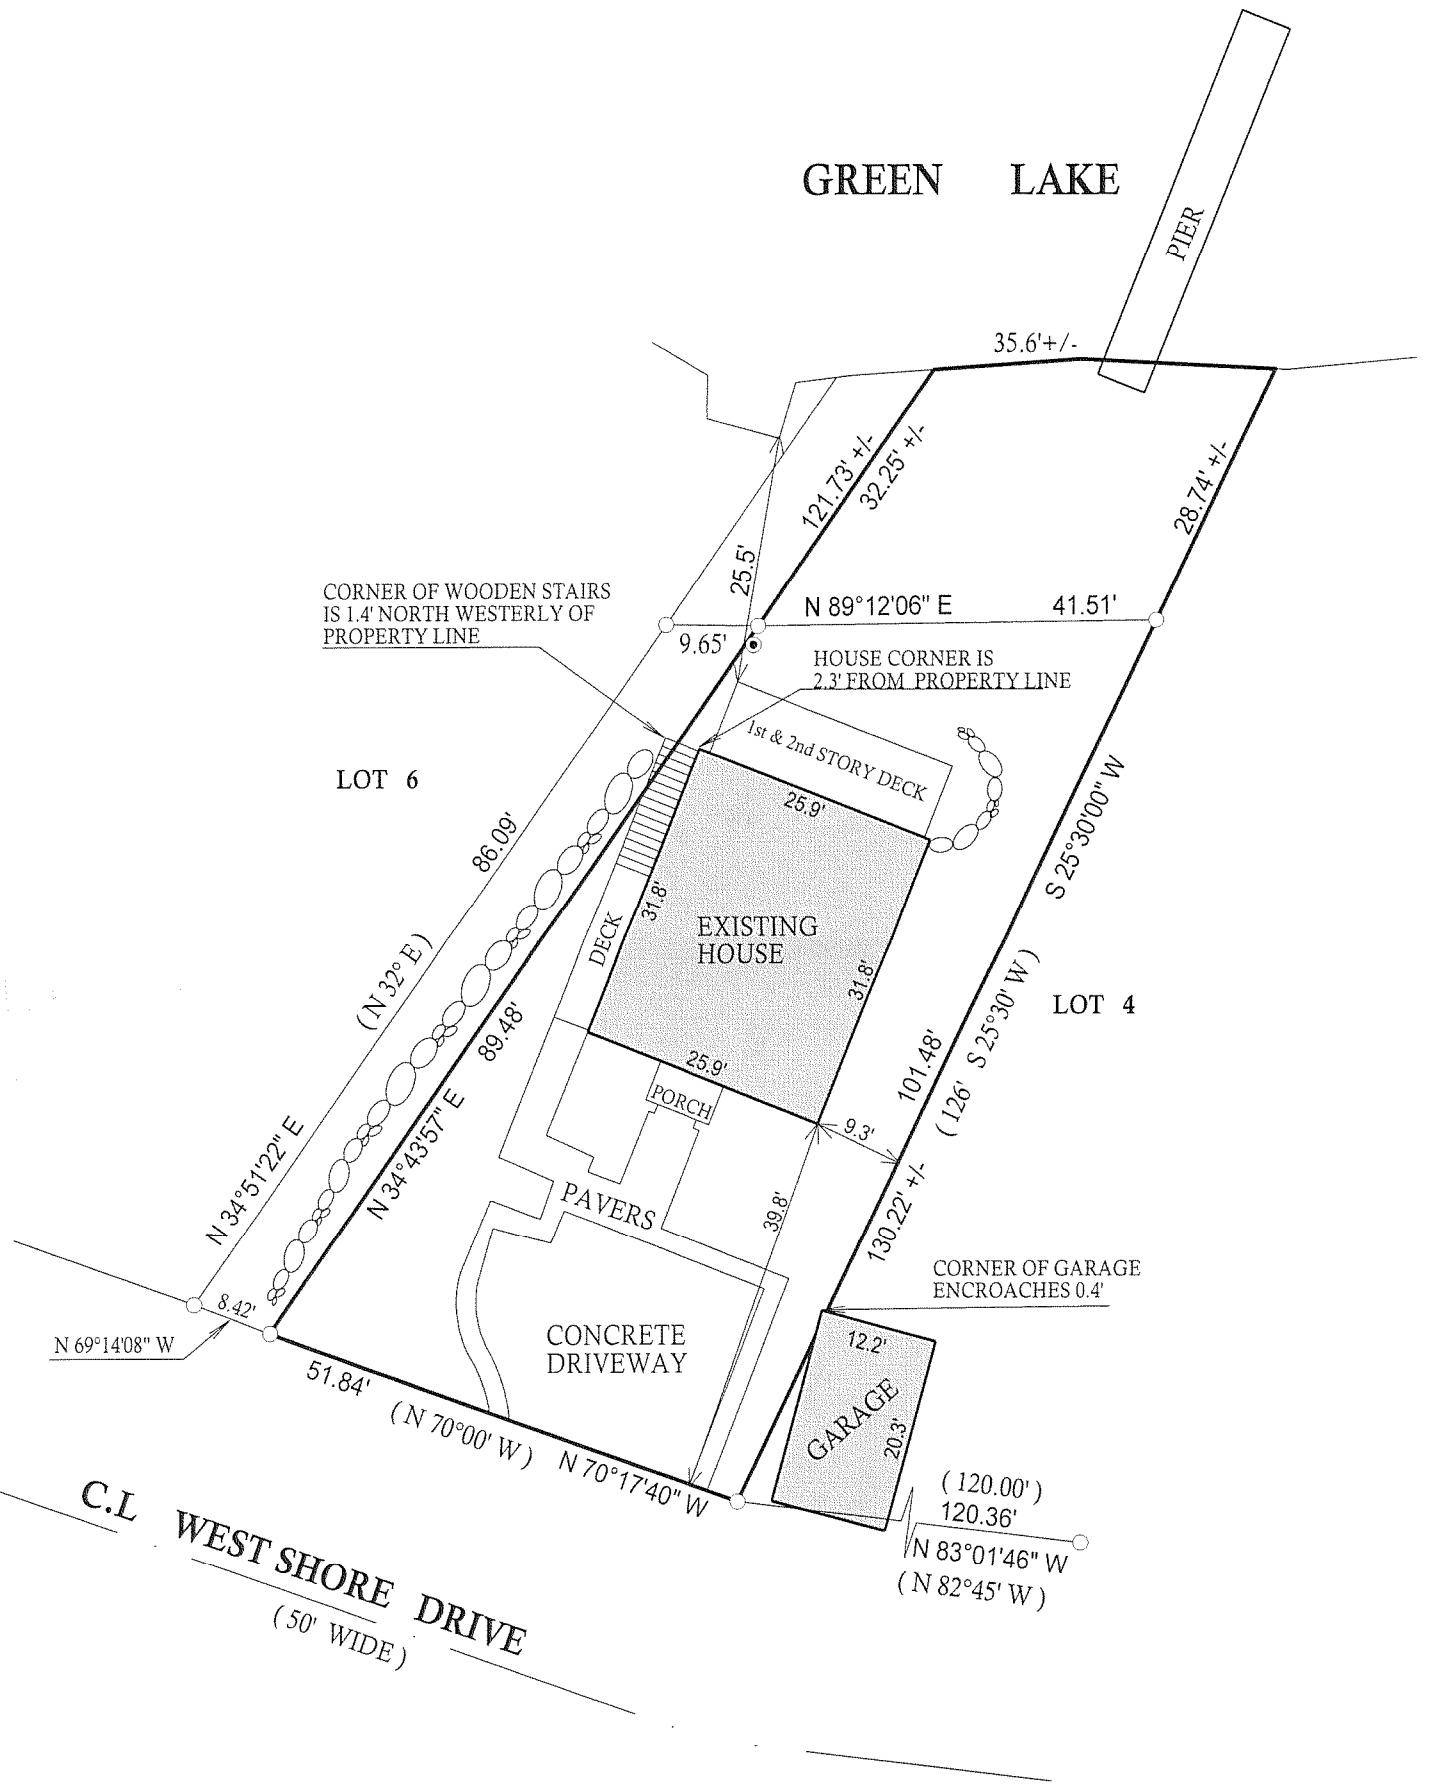

LEGEND

STONE RETAINING WALL


WELL

FOUND IRON PIPE

FOUND IRON BAR

SET IRON BAR

(XX) RECORDED AS

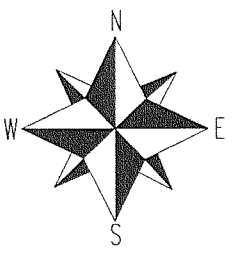

SCALE 1" = 20'

RECEIVED
AUG 24 2009
By

WISCONSIN
JOHN P.
KROTT
S-2258
LAKE GENEVA
WIS.
LAND SURVEYOR

DATED THIS 1st, DAY OF JUNE, 2009

JOHN KROTT S - 2258
Wisconsin Registered Land Surveyor
(original if signed in red)

"I hereby certify that I have surveyed the above described property and that the above map is a true representation thereof and shows the size and location of all visible structures, apparent easements and encroachments if any."
This survey is made for the present owners of the property, and those who purchase, mortgage, or guarentee the title thereto, within one year from the date hereof.

JOB # 09-067 TAX ID # HGP00005

416-2411