

Plat of Survey

Lot 2 of Certified Survey Map No. 3533,
recorded in Vol. 20 of Certified Survey Maps of Walworth County on
Page 315 and located in the Northeast 1/4 of Section 14, T1N, R10E,
Southwest 1/4 of North, Range 16 East, Town of LaGrange, Walworth
County, Wisconsin.

Survey for: Inigo Manglano-Ovalle
1295 North Rockwell
Chicago, Illinois 60622

Lot 4
C.S.M. 3533



Lot 4
Parker Pines

Outlot 1

C.S.M. 3532

Lot 1
C.S.M. 3533

Lot 3
C.S.M. 3533

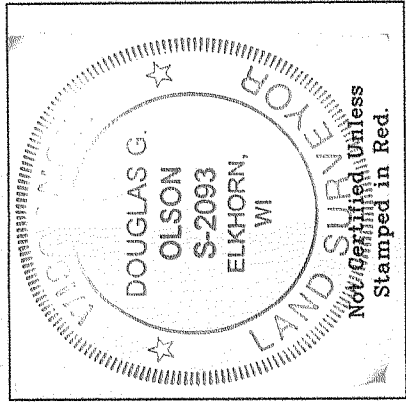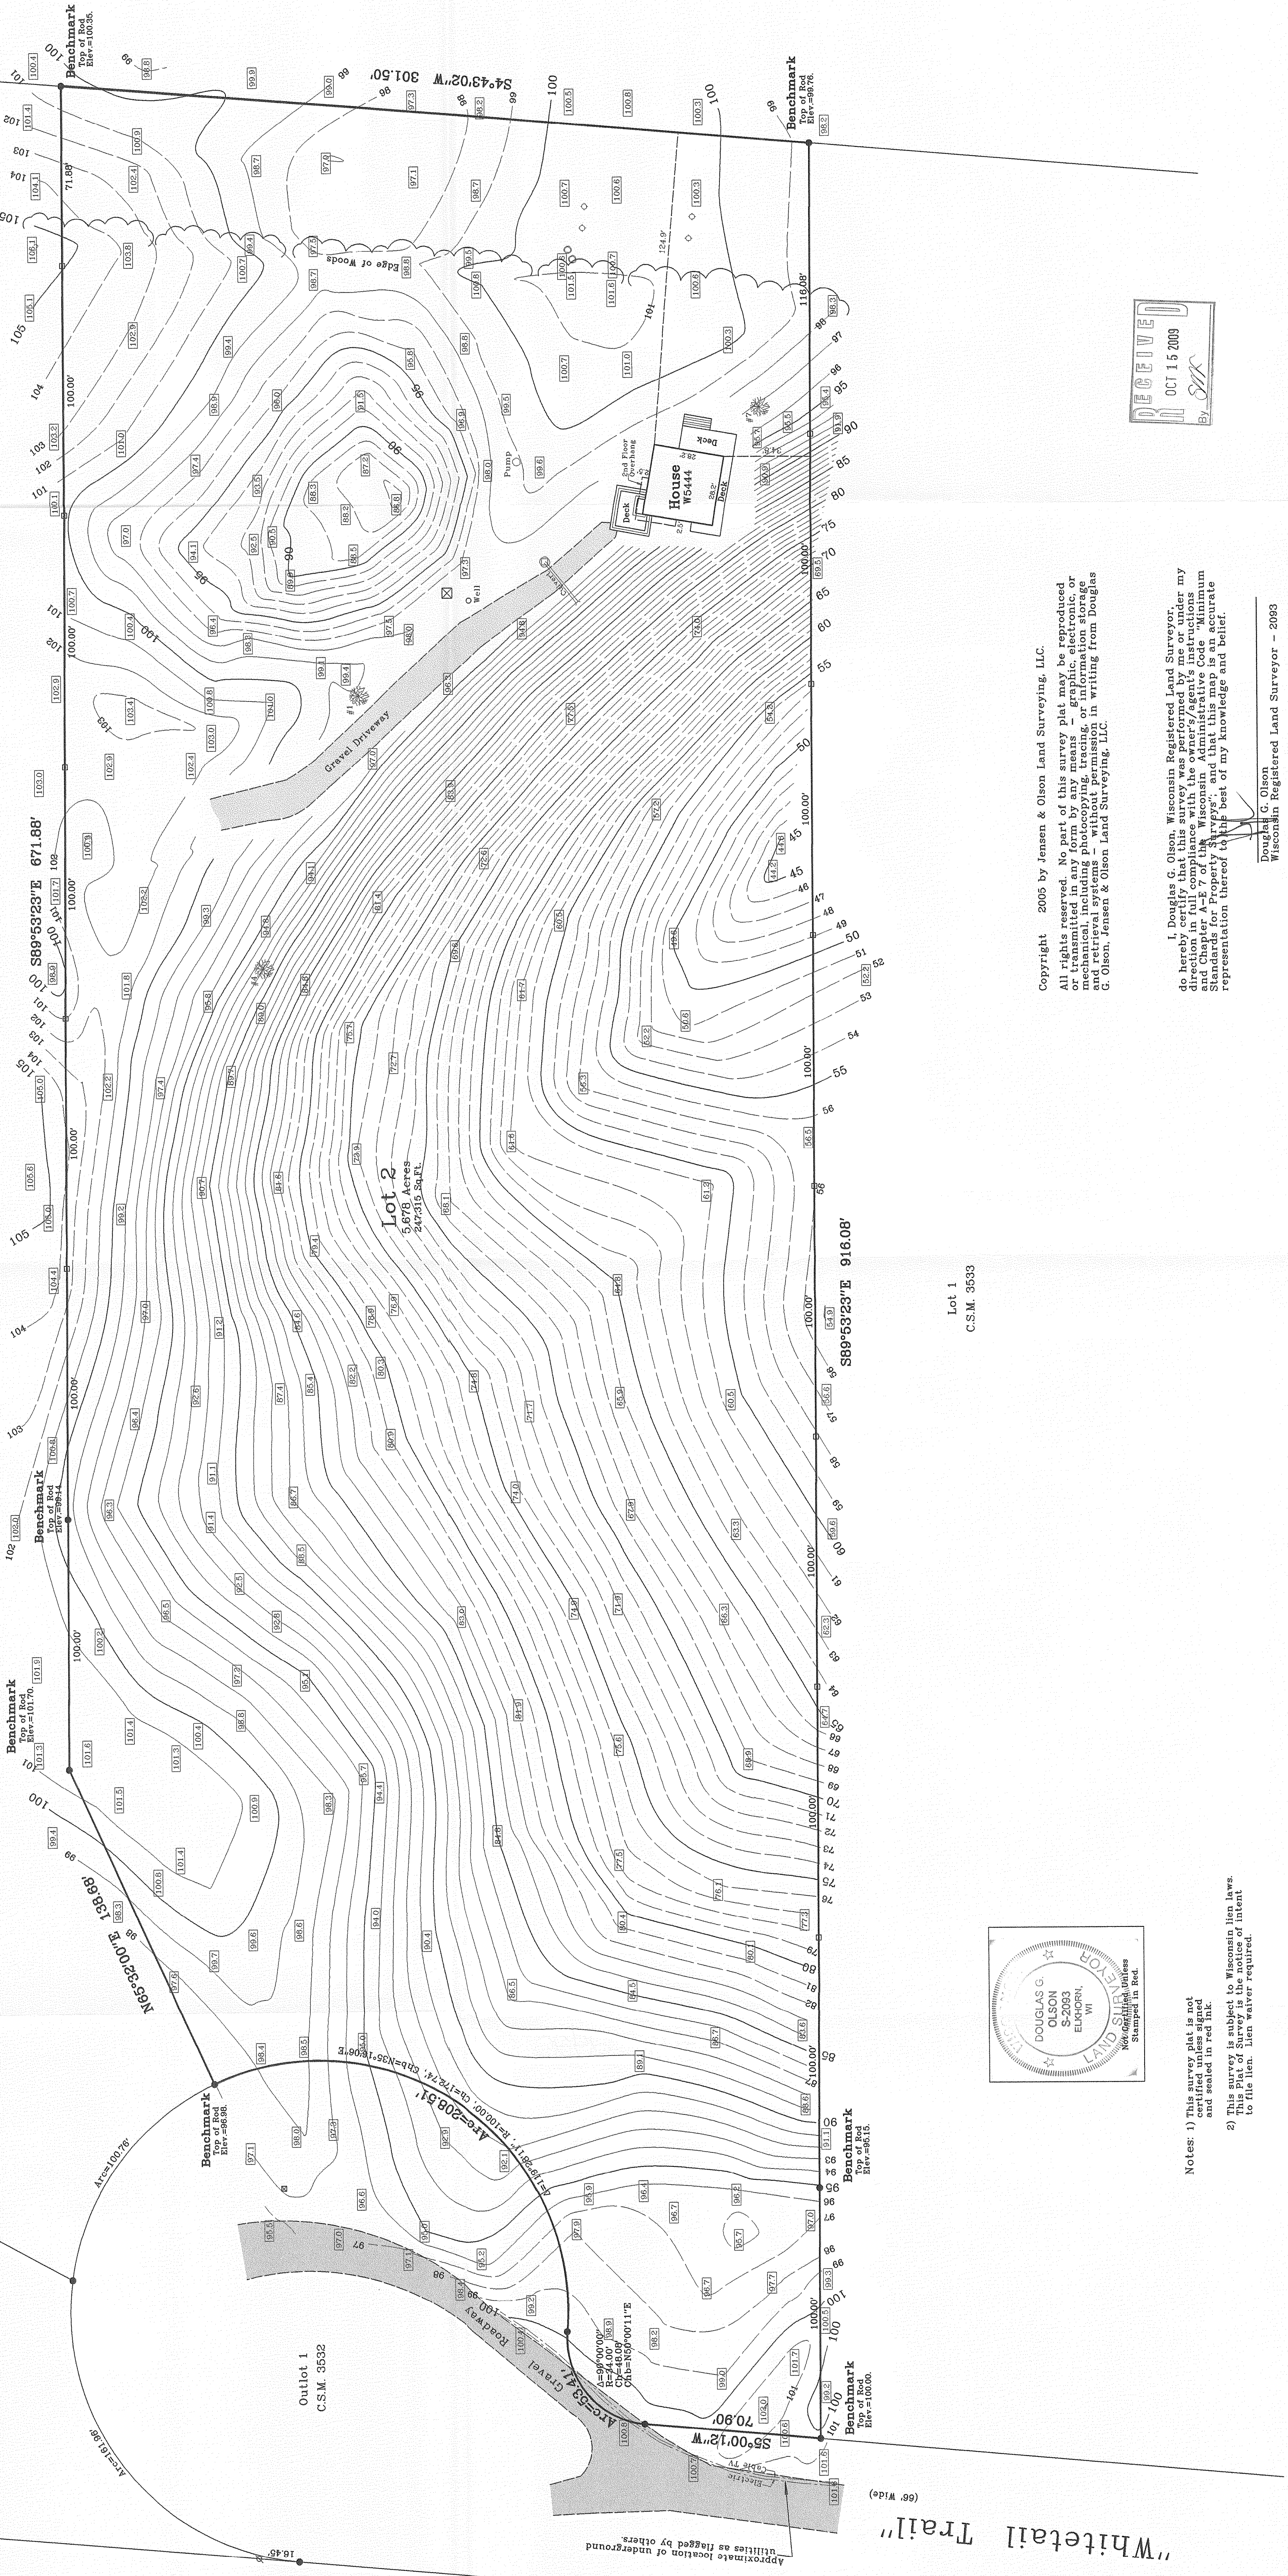


Notes: 1) This survey plat is not
and sealed in red ink.
2) This survey is subject to Wisconsin lien laws.
This Plat of Survey is the notice of intent
to file lien. Lien waiver required.

Copyright 2005 by Jensen & Olson Land Surveying, LLC.
All rights reserved. No part of this survey plat may be reproduced
or transmitted in any form by any means - graphic, electronic, or
mechanical, including photocopying, recording, or by any information
storage and retrieval system, without permission in writing from Douglas
G. Olson, Jensen & Olson Land Surveying, LLC.

I, Douglas G. Olson, Wisconsin Registered Land Surveyor,
do hereby certify that this survey was performed by me or under my
direction in full compliance with the owner's/agent's instructions
representation thereof to the best of my knowledge and belief.

Douglas G. Olson
Wisconsin Registered Land Surveyor - 2093

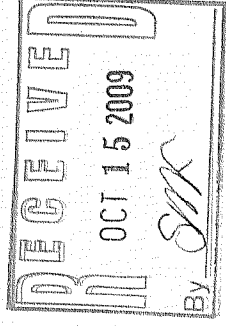

Jensen & Olson Land Surveying, LLC
45 South Wisconsin Street * P.O. Box 322 * Elkhorn, Wisconsin, 53121
Telephone: (262) 723-3434 * Facsimile: (262) 723-8044
Email: jensen.olson@elknet.net


- Legend
- Found Iron Pipe
 - Recorded Information
 - Gravel Surface
 - Spot Elevation
 - Tree Marked by Owner
 - Utility Box or Pedestal
 - Concrete Cover
 - PVC Pipe
 - Storm Drain

Job Reference Number
2009.062
Sheet 1 of 1 Sheets
Drawing Name: Hs16-200902-2009062 Plats

2009.062

Scale in Feet
1" = 30'
0 15 30 60 90

Survey date: April 7, 2005.
Revisions: No. 1 - House Location

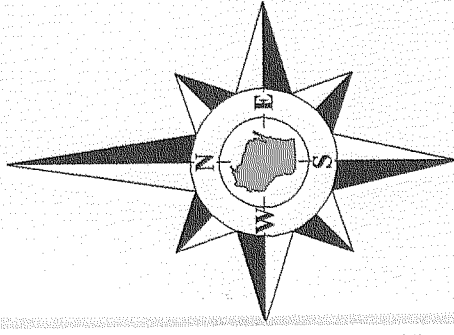

Readings reference to the Wisconsin State
Plane Coordinate System, South Zone.

HA3533-2

416-2490