
PLAT OF SURVEY

LOTS 6 THRU 8 OF BLOCK 2 OF COOPERS MID LAKES SUBDIVISION

LOCATED IN PART OF SECTION 35, TOWN 4 NORTH, RANGE 16 EAST, WALWORTH COUNTY, WISCONSIN

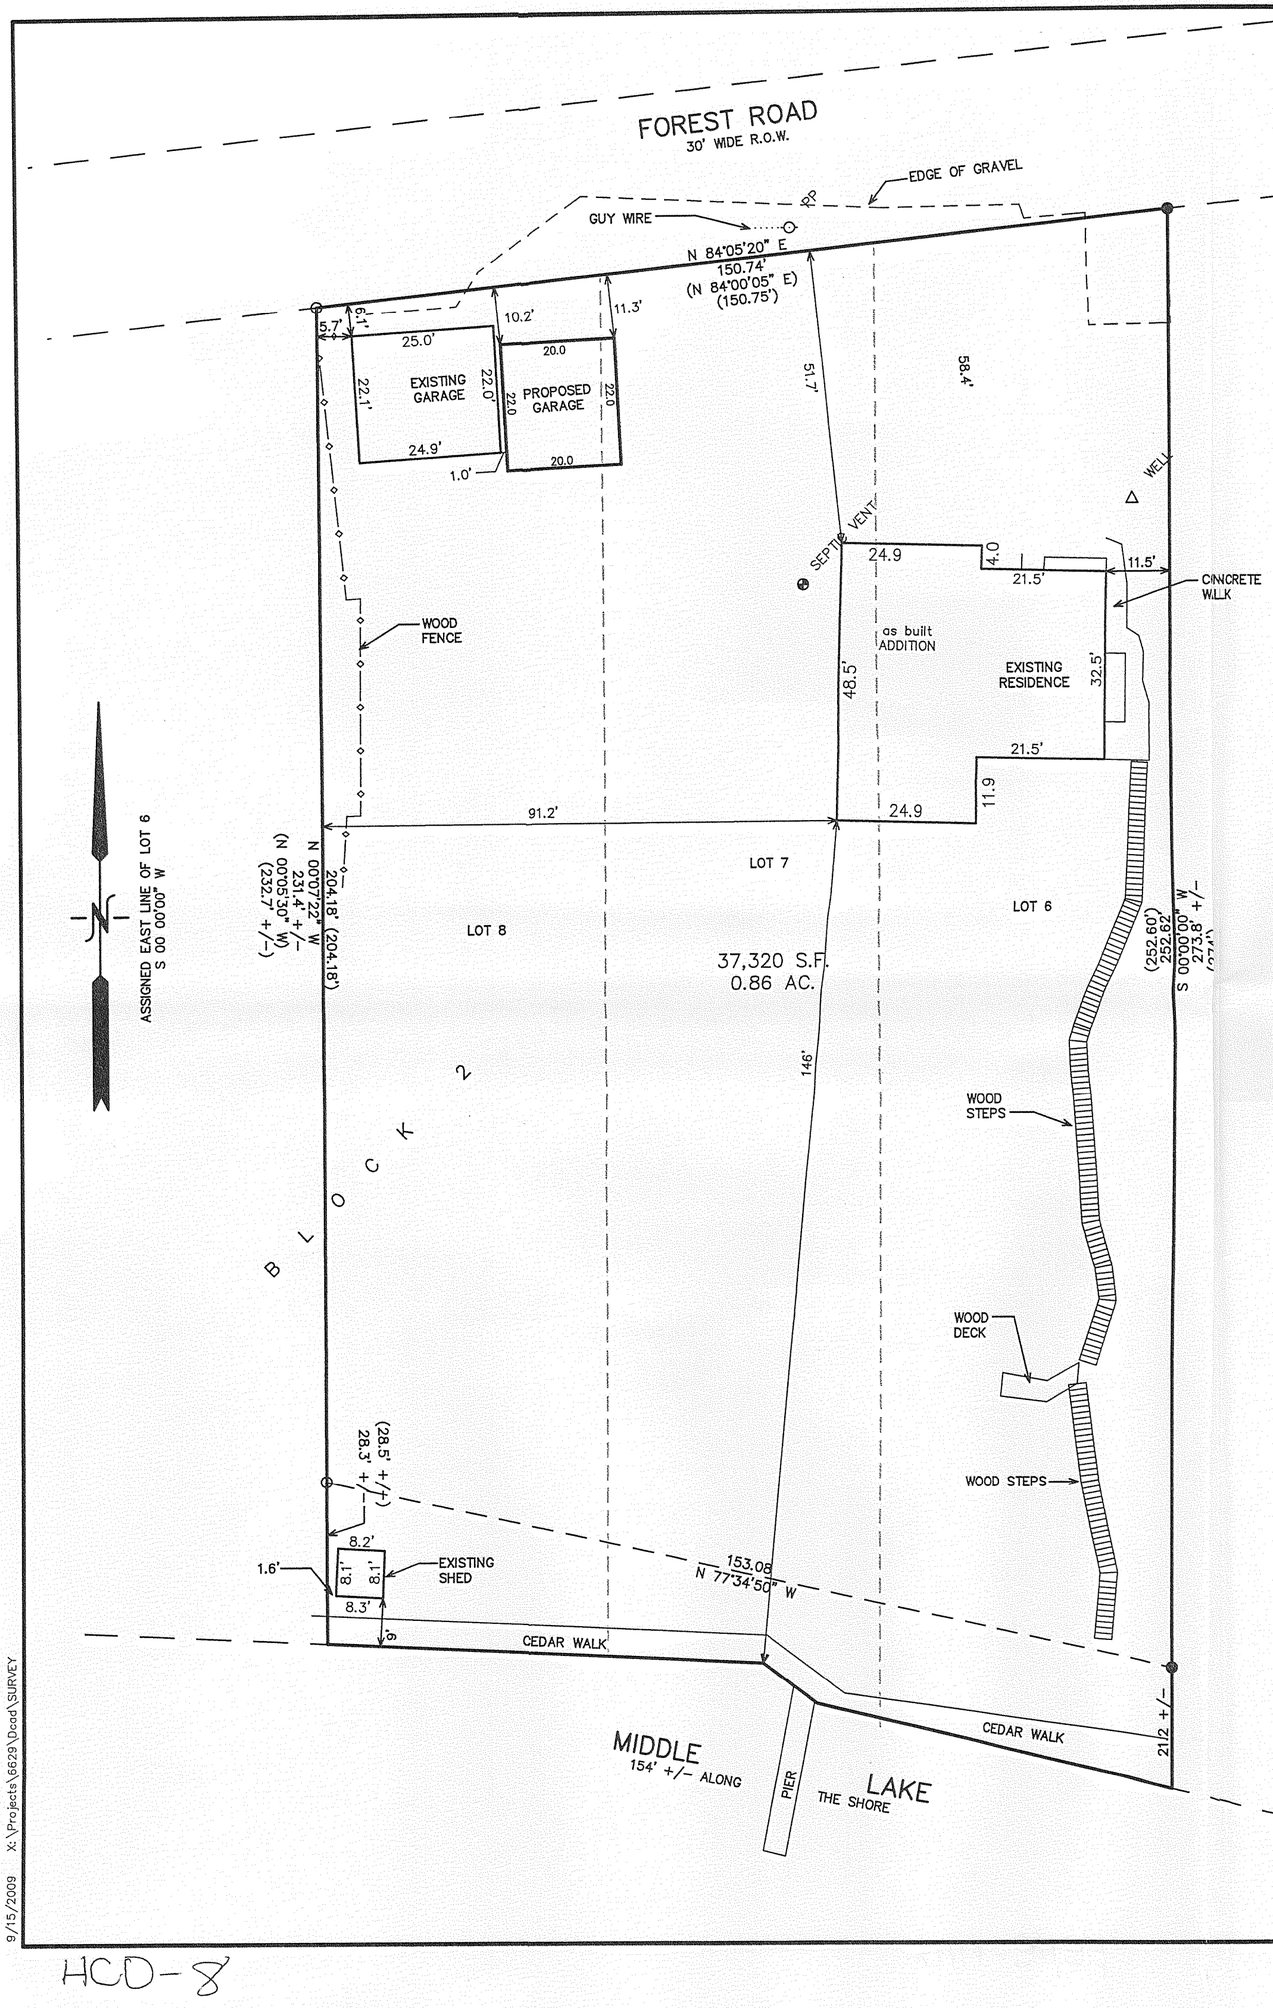

LEGEND

○ = FOUND IRON PIPE STAKE

● = FOUND IRON REBAR STAKE

(XXX) = RECORDED AS

RECEIVED
OCT 19 2009
By

NOTE: COPIES OF THIS MAP TO WHICH THE FOLLOWING CERTIFICATE WILL APPLY SHOW THE SURVEYOR'S ORIGINAL SEAL AND SIGNATURE IN RED INK. COPIES BY ANY OTHER MEANS MAY HAVE ALTERATIONS WHICH DO NOT REPRESENT THE SURVEYOR'S WORK PRODUCT.

I HEREBY CERTIFY THAT THE ABOVE DESCRIBED PROPERTY HAS BEEN SURVEYED UNDER MY DIRECTION AND THAT THE ABOVE MAP IS A TRUE REPRESENTATION THEREOF AND SHOWS THE SIZE AND LOCATION OF THE PROPERTY AND ITS EXTERIOR BOUNDARIES. THIS SURVEY IS MADE FOR THE USE OF THE PRESENT OWNERS OF THE PROPERTY, AND ALSO THOSE WHO PURCHASE, MORTGAGE, OR GUARANTEE THE TITLE THERETO WITHIN ONE YEAR FROM THE DATE HEREOF.

DATED: SEPTEMBER 7, 2004

REVISED 11-07-2005
TO SHOW SIZE & LOCATION OF PROPOSED ADDITION

REVISED 09-15-2009
TO SHOW AS BUILT ADDITION & PROPOSED GARAGE

PETER S. GORDON R.L.S. 2101

WISCONSIN
PETER S. GORDON
S-2101
ELKHORN, WI
LAND SURVEYOR

10 5 0 10 20 30 40 50 60 70 80 90 100

MAP SCALE IN FEET ORIGINAL 1" = 20'

– WORK ORDERED BY –
ROBERT CRAPPLE
5691 FORREST ROAD
ELKHORN, WI 53121

FARRIS, HANSEN & ASSOCIATES, INC.
ENGINEERING – ARCHITECTURE – SURVEYING
7 RIDGWAY COURT P.O. BOX 437
ELKHORN, WISCONSIN 53121
OFFICE: (262) 723-2098 FAX: (262) 723-5886

REVISIONS

PROJECT NO. 6629

DATE: 09/07/04

SHEET NO. 1 OF 1

9/15/2009 X:\Projects\6629\Dcad\SURVEY

HCD-8

416-2424