
Plat of Survey


of

Unit 47 of Lauderdale Shores
A Recreational Vehicle Condominium,

located in the Northwest 1/4 of Section 25, Town 4 North, Range 16 East, Town of LaGrange, Walworth County, Wisconsin.

Surveyed for: **Kenneth Jewell**
4310 Wilmette Avenue
Rolling Meadows, Illinois. 60008

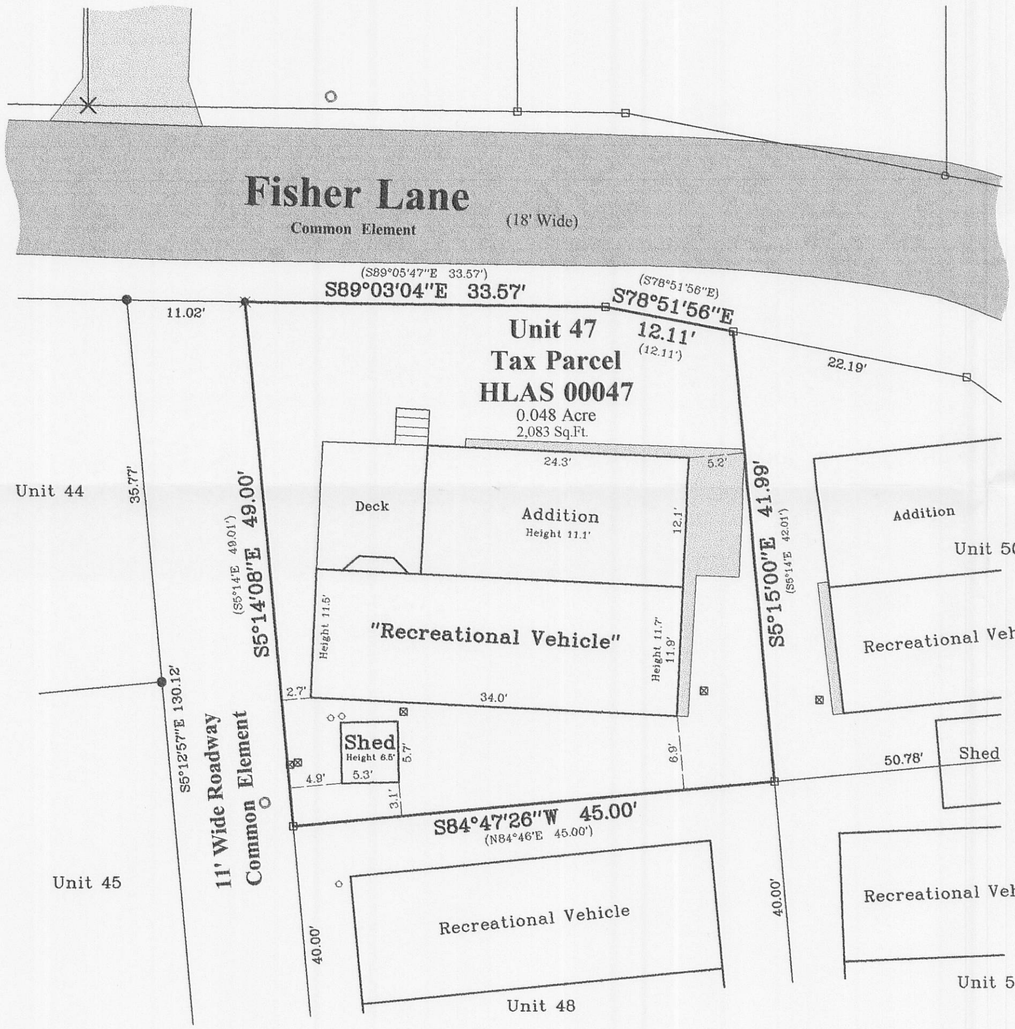

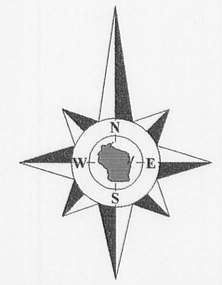

Bearings reference to the plat of Lauderdale Shores A Recreational Vehicle Condominium.



Professional Seal Stamped in Red.

Notes:

1) This survey plat is not certified unless signed and sealed in red ink.
2) This survey is subject to Wisconsin lien laws. This Plat of Survey is the notice of intent to file lien. Lien waiver required.

Copyright 2009 by Jensen & Olson Land Surveying, LLC.

All rights reserved. No part of this survey plat may be reproduced or transmitted in any form by any means - graphic, electronic, or mechanical, including photocopying, tracing, or information storage and retrieval systems - without permission in writing from Douglas G. Olson, Jensen & Olson Land Surveying, LLC.

I, Douglas G. Olson, Wisconsin Registered Land Surveyor, do hereby certify that this survey was performed by me, or under my direction in full compliance with the owner's/agent's instructions and Chapter A-E 7 of the Wisconsin Administrative Code "Minimum Standards for Property Surveys"; and that this map is an accurate representation thereof to the best of my knowledge and belief.

Douglas G. Olson
Wisconsin Registered Land Surveyor - 2093

RECEIVED
MAY 11 2010
By

Survey Date: November 19, 2009
Revisions:

Scale in Feet
1" = 10'
0' 5' 10' 20'

Jensen & Olson Land Surveying, LLC
45 South Wisconsin Street * P.O. Box 322 * Elkhorn, Wisconsin. 53121
Telephone: (262) 723-3434 * Facsimile: (262) 723-8044
Email: jensen.olson@elknet.net

Legend
- Found Iron Rod
- Found Railroad Spike
- Found Mag Nail
- Set Iron Rod, 3/4 " dia.
- Recorded Information
- Utility Box or Pedestal
- Water Shut-off
- Asphalt Surface
- Concrete Surface
- Manhole
- PVC Pipe

Sheet 1 of 1 Sheets
Drawing Name: t4n16e-2009103Plat.scj
Job Reference Number
2009.103
2009.103

HLAS-47

416-2469