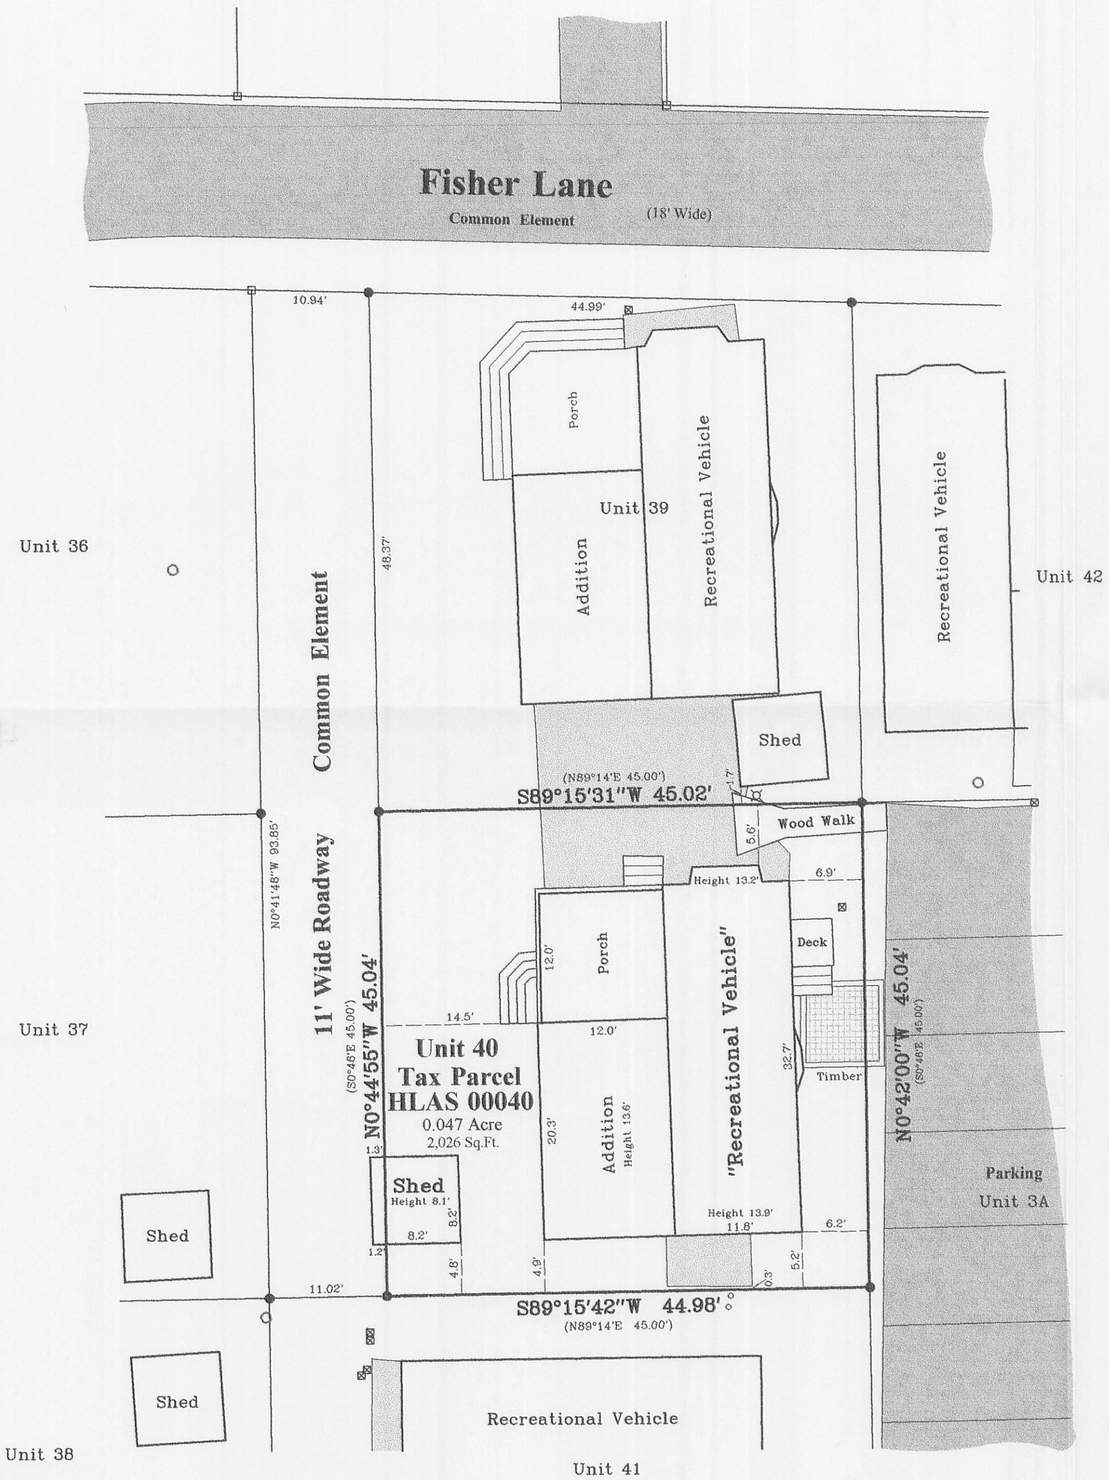

Plat of Survey

of

Unit 40 of Lauderdale Shores
A Recreational Vehicle Condominium,

located in the Northwest 1/4 of Section 25, Town 4 North, Range 16 East, Town of LaGrange, Walworth County, Wisconsin.

Surveyed for: **John & Mary Churillo**
26W091 Quail Run Drive
Wheaton, Illinois. 60187

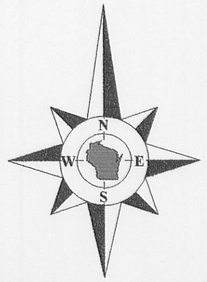

RECEIVED
MAY 1 1 2010
By SMK

Bearings reference to the plat of Lauderdale Shores A Recreational Vehicle Condominium.

WISCONSIN
DOUGLAS
OLSON
S-2093
ELKHORN,
WI
LAND SURVEYOR
Not Valid Unless
Stamped in Red.

Notes:

1) This survey plat is not certified unless signed and sealed in red ink.

2) This survey is subject to Wisconsin lien laws. This Plat of Survey is the notice of intent to file lien. Lien waiver required.

Copyright 2009 by Jensen & Olson Land Surveying, LLC.

All rights reserved. No part of this survey plat may be reproduced or transmitted in any form by any means - graphic, electronic, or mechanical, including photocopying, tracing, or information storage and retrieval systems - without permission in writing from Douglas G. Olson, Jensen & Olson Land Surveying, LLC.

I, Douglas G. Olson, Wisconsin Registered Land Surveyor, do hereby certify that this survey was performed by me, or under my direction in full compliance with the owner's/agent's instructions and Chapter A-E 7 of the Wisconsin Administrative Code "Minimum Standards for Property Surveys"; and that this map is an accurate representation thereof to the best of my knowledge and belief.

Douglas G. Olson
Wisconsin Registered Land Surveyor - 2093

Survey Date: November 19, 2009.
Revisions: No. 1 – Ped.

Scale in Feet
1" = 10'
0' 5' 10' 20'

Jensen & Olson Land Surveying, LLC
45 South Wisconsin Street * P.O. Box 322 * Elkhorn, Wisconsin. 53121
Telephone: (262) 723-3434 * Facsimile: (262) 723-8044
Email: jensen.olson@elknet.net

Legend
- Found Iron Rod
- Set Iron Rod, 3/4" dia.
- Set Railroad Spike
- Recorded Information
- Utility Box or Pedestal
- Asphalt Surface
- Concrete Surface
- Pavers or Stone
- Manhole
- Light

Sheet 1 of 1 Sheets
Drawing Name: (4ar16c-2009\09-2009\09Plat.sig)
Job Reference Number
2009.099

2009.099

HLAS-40

416-2471