
PLAT OF SURVEY

PREPARED FOR:
JERRY KROUPA
KEEFE REAL ESTATE
ELKHORN, WI.

- OF -

LOT 6 OAK PARK SUBDIVISION, LOCATED IN SECTION26, TOWN 4 NORTH, RANGE 16 EAST OF THE FOURTH PRINCIPAL MERIDIAN, TOWN OF LAGRANGE, COUNTY OF WALWORTH AND STATE OF WISCONSIN.

PATHFINDER SURVEYING INC.
(formerly)
J.K. SURVEYING INC.
N3705 WILLOWBEND LANE
LAKE GENEVA, WI, 53147
262-248-8303

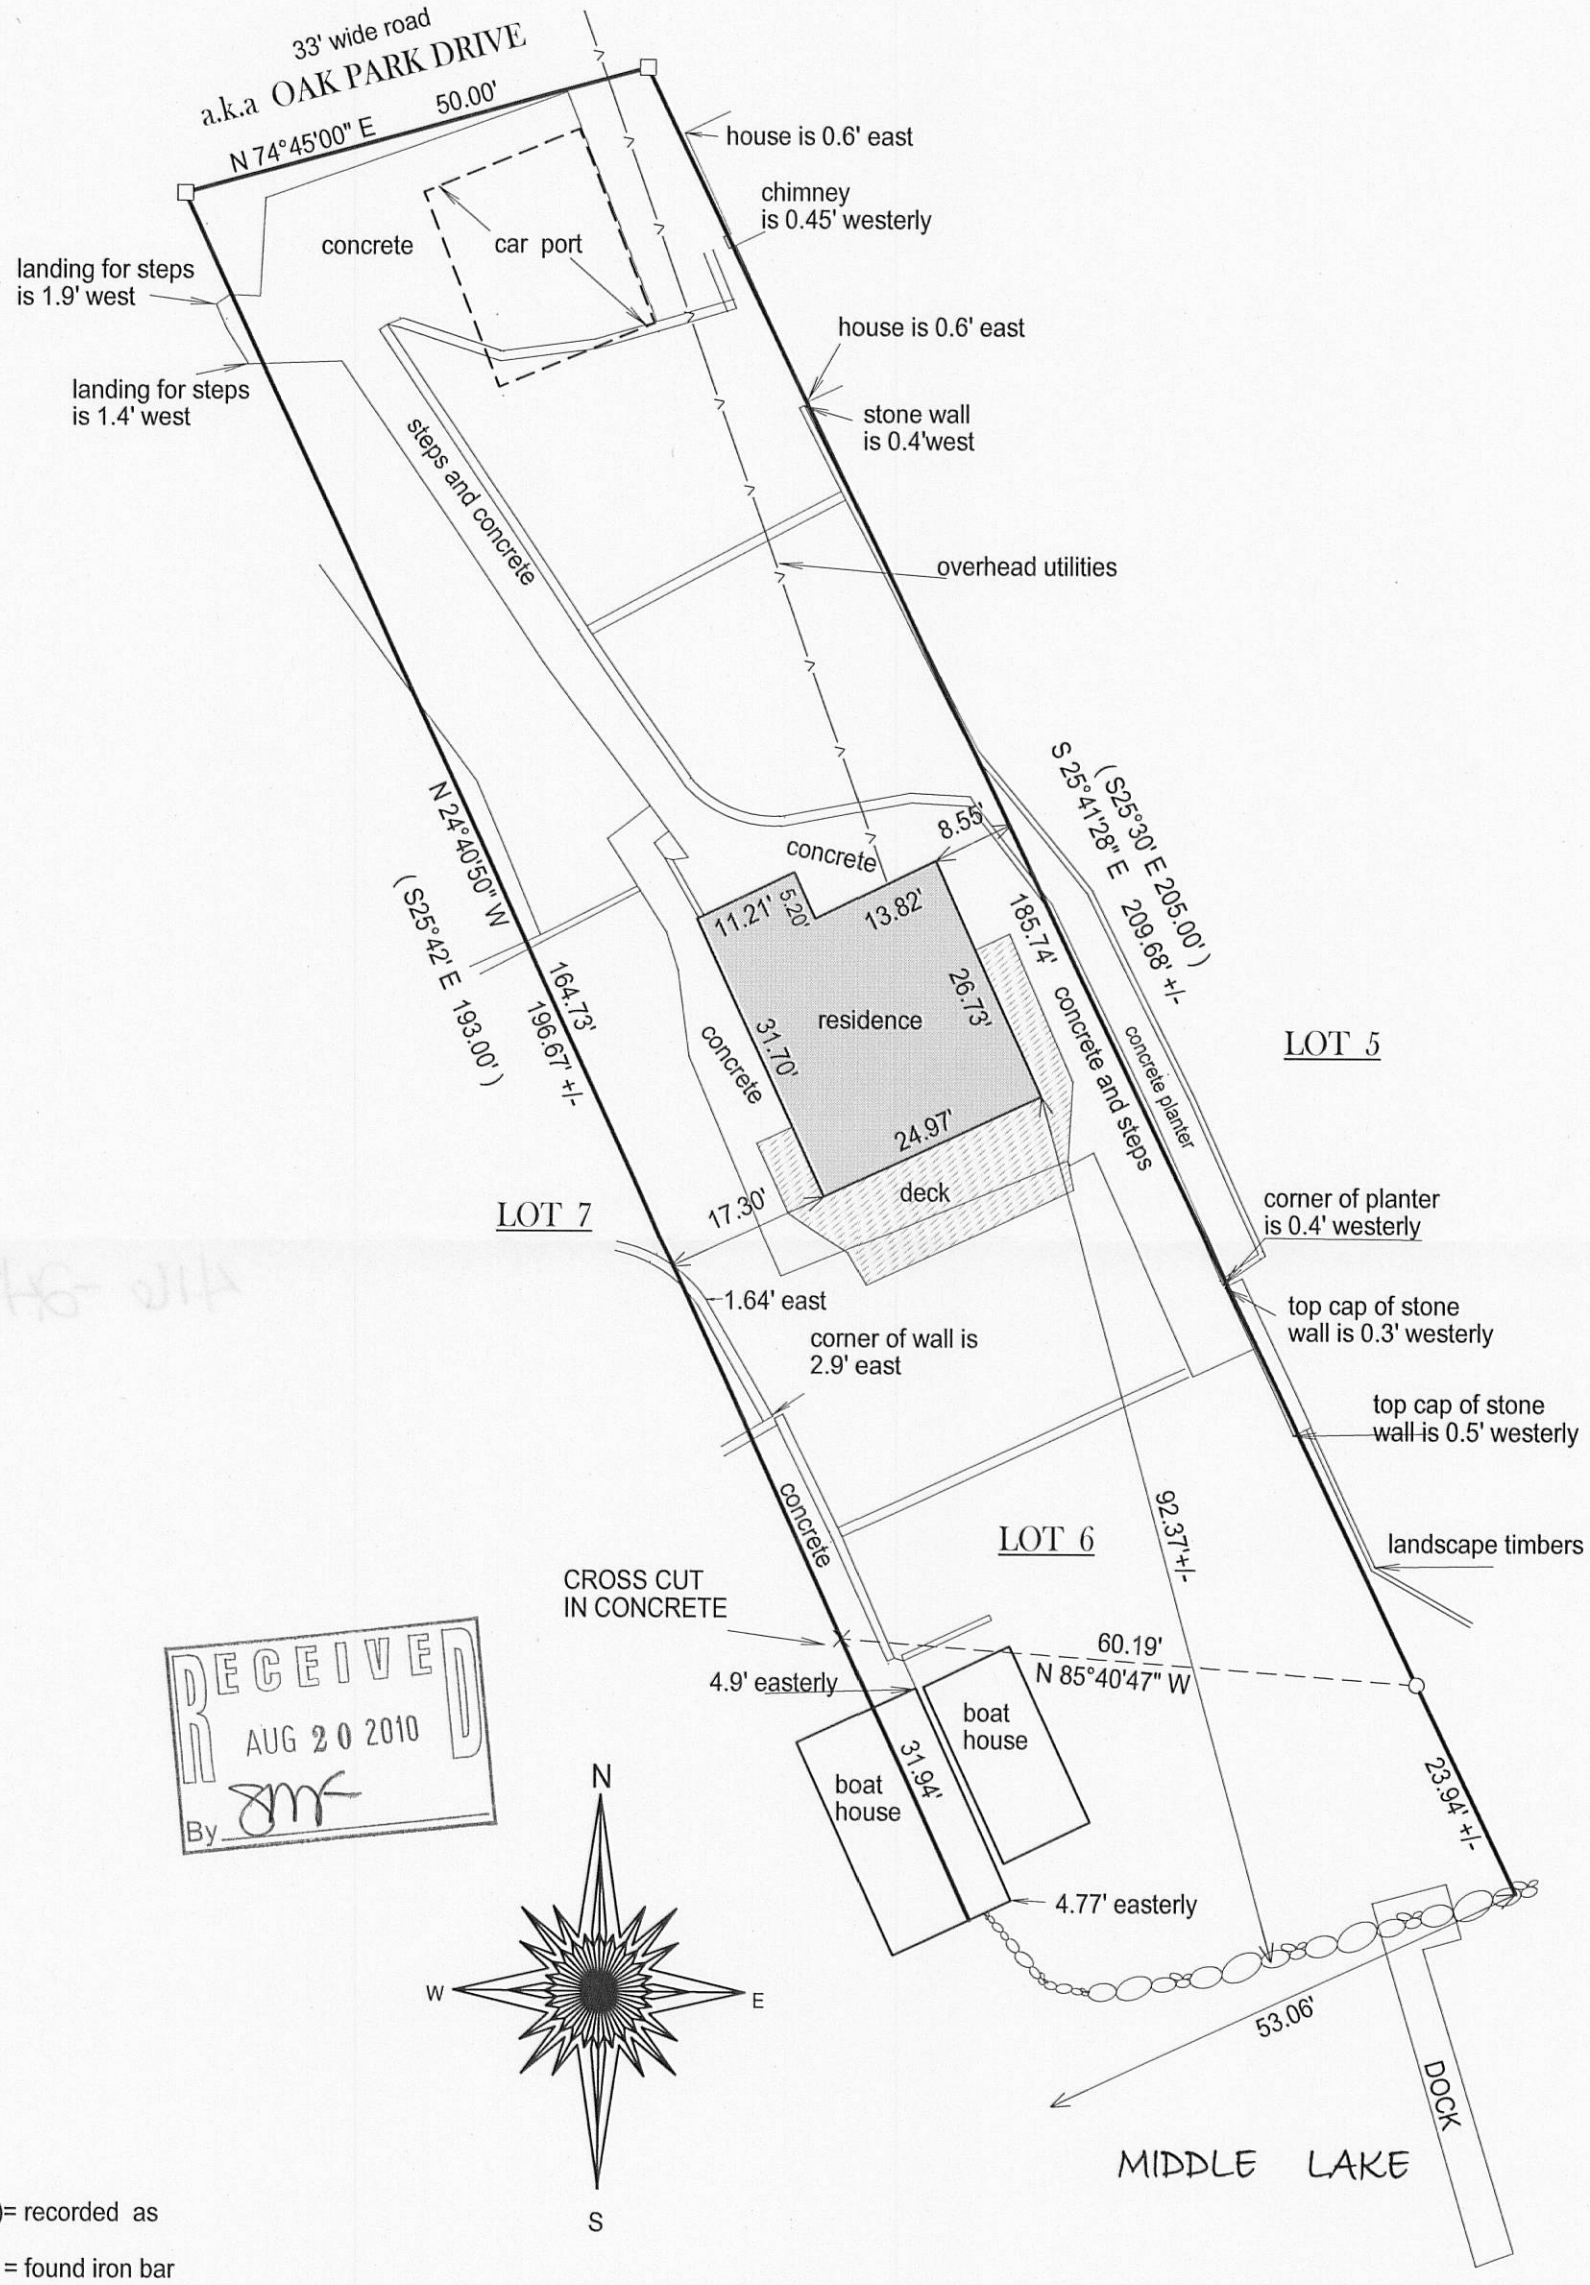

RECEIVED
AUG 20 2010
By

( )= recorded as

□ = found iron bar

○ = found iron pipe

● = set iron pipe

■ = set iron bar

SCALE 1" = 20'

JOB # 10-51

TAX ID # HOP 00004

BASIS OF BEARING OF THIS PLAT: THE SOUTH LINE OF OAK PARK DR WAS ASSUMED TO BEAR N74°45' E.

"I hereby certify that I have surveyed the above described property and that the above map is a true representation thereof and shows the size and location of all visible structures, apparent easements and encroachments if any."
This survey is made for the present owners of the property, and those who purchase, mortgage, or guarentee the title thereto, within one year from the date hereof.

DATED THIS 23RD DAY OF APRIL, 2010.

WISCONSIN
JEFFREY L. KIMPS
S-2436
LAKE GENEVA. WIS.
LAND SURVEYOR

JEFFREY L KIMPS S-2436
(origional if signed in red)