
PLAT OF SURVEY

NORTHERLY 55' OF LOT 17 OF MORRIS PARK

LOCATED IN PART OF THE SOUTHWEST 1/4 OF SECTION 26,
TOWN 4 NORTH, RANGE 16 EAST, WALWORTH COUNTY, WISCONSIN

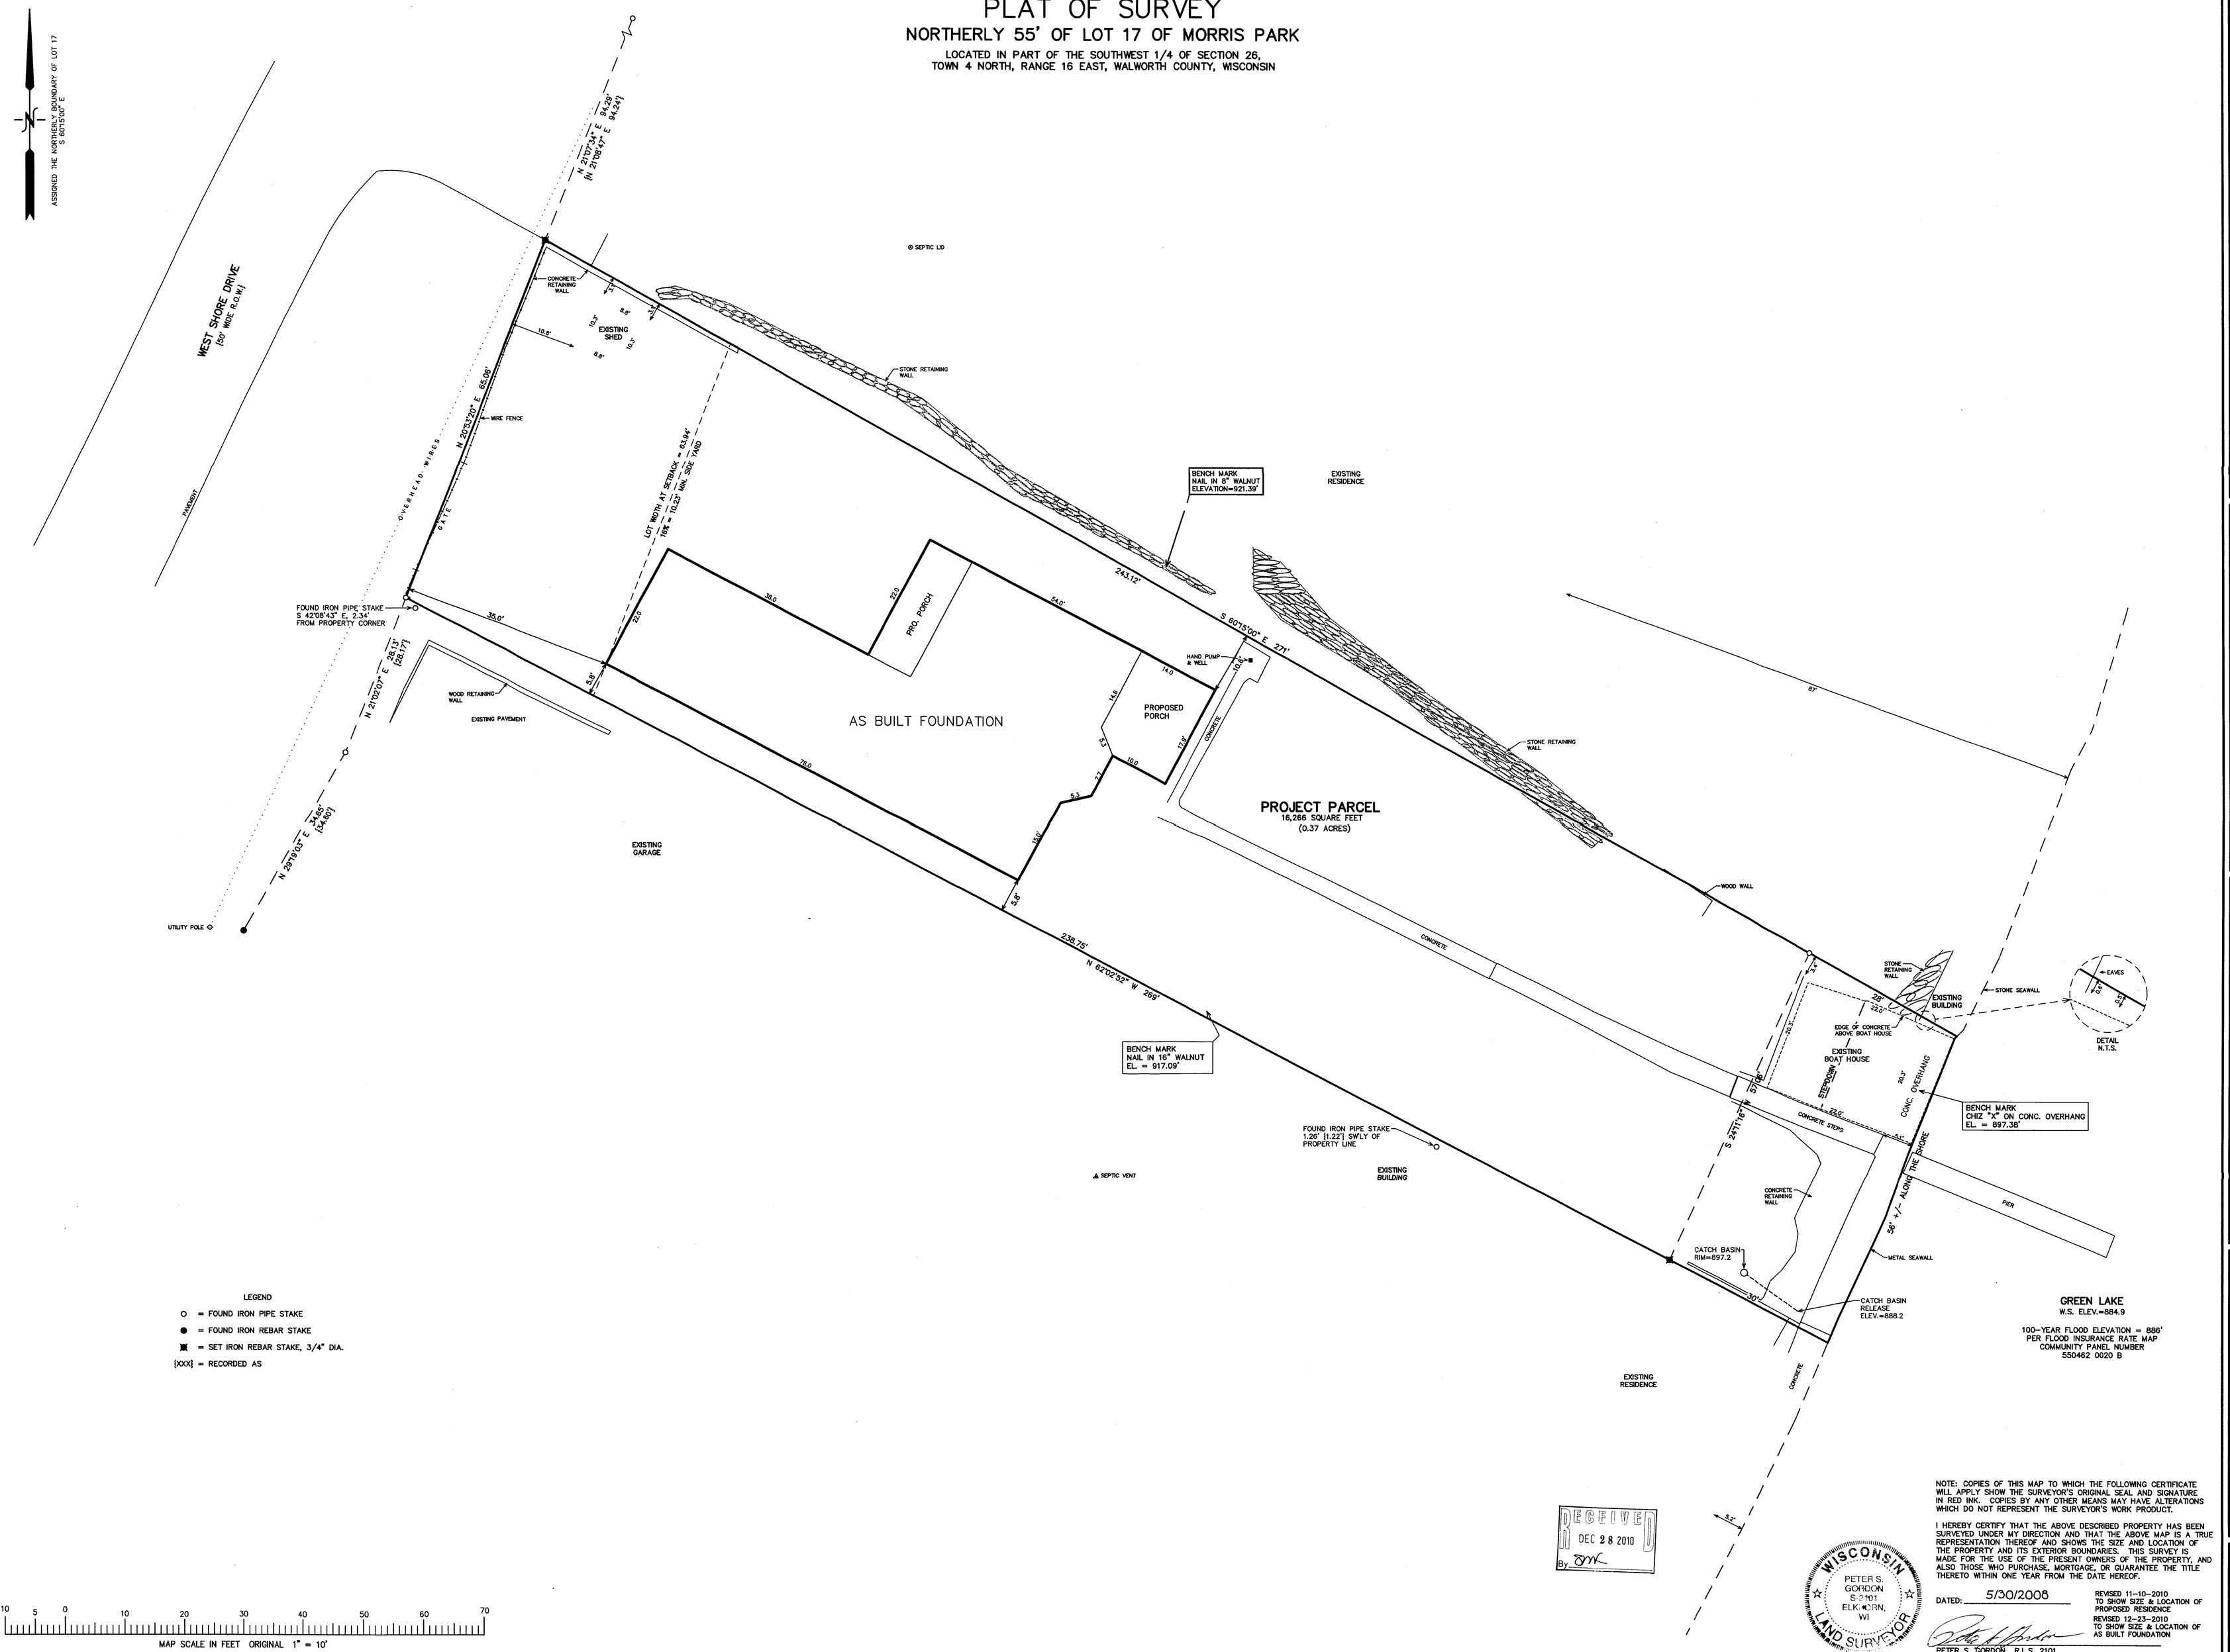

LEGEND

- ○ = FOUND IRON PIPE STAKE
- ● = FOUND IRON REBAR STAKE
- ▣ = SET IRON REBAR STAKE, 3/4" DIA.
- [XXX] = RECORDED AS

10 5 0 10 20 30 40 50 60 70

MAP SCALE IN FEET ORIGINAL 1" = 10'

RECEIVED
DEC 28 2010
By JMK

NOTE: COPIES OF THIS MAP TO WHICH THE FOLLOWING CERTIFICATE WILL APPLY SHOW THE SURVEYOR'S ORIGINAL SEAL AND SIGNATURE IN RED INK. COPIES BY ANY OTHER MEANS MAY HAVE ALTERATIONS WHICH DO NOT REPRESENT THE SURVEYOR'S WORK PRODUCT.

I HEREBY CERTIFY THAT THE ABOVE DESCRIBED PROPERTY HAS BEEN SURVEYED UNDER MY DIRECTION AND THAT THE ABOVE MAP IS A TRUE REPRESENTATION THEREOF AND SHOWS THE SIZE AND LOCATION OF THE PROPERTY AND ITS EXTERIOR BOUNDARIES. THIS SURVEY IS MADE FOR THE USE OF THE PRESENT OWNERS OF THE PROPERTY, AND ALSO THOSE WHO PURCHASE, MORTGAGE, OR GUARANTEE THE TITLE THERETO WITHIN ONE YEAR FROM THE DATE HEREOF.

WISCONSIN
PETER S. GORDON
S-2101
ELKHORN, WI
LAND SURVEYOR

DATED: 5/30/2008

PETER S. GORDON R.L.S. 2101

REVISED 11-10-2010
TO SHOW SIZE & LOCATION OF PROPOSED RESIDENCE
REVISED 12-23-2010
TO SHOW SIZE & LOCATION OF AS BUILT FOUNDATION

12/23/2010 X:\Projects\7643\DCAD\VPSZ_20101110

HMP-14

4116-25RA

FARRIS, HANSEN & ASSOCIATES, INC.
ENGINEERING – ARCHITECTURE – SURVEYING
7 RIDGWAY COURT P.O. BOX 437
ELKHORN, WISCONSIN 53121
OFFICE: (262) 723-2098 FAX: (262) 723-5886

PLAT OF SURVEY
TOWN OF LA GRANGE, WALWORTH COUNTY, WISCONSIN

– WORK ORDERED BY –
THELEN TOTAL CONSTRUCTION, INC.
P.O. BOX 17
ELKHORN, WI 53121

REVISIONS

PROJECT NO.
7643

DATE
05/30/2008

SHEET NO.
1 OF 1