




PLAT OF SURVEY

LOT 15 & THE SOUTHERLY 10 FEET OF LOT 14
MORRIS PARK SUBDIVISION
LOCATED IN TOWN 4 NORTH, RANGE 16 EAST
WALWORTH COUNTY, WISCONSIN

LEGEND

- = FOUND IRON PIPE STAKE 1" DIA.
- (XXX) = RECORDED AS
- AREA = 27,275 S.F.

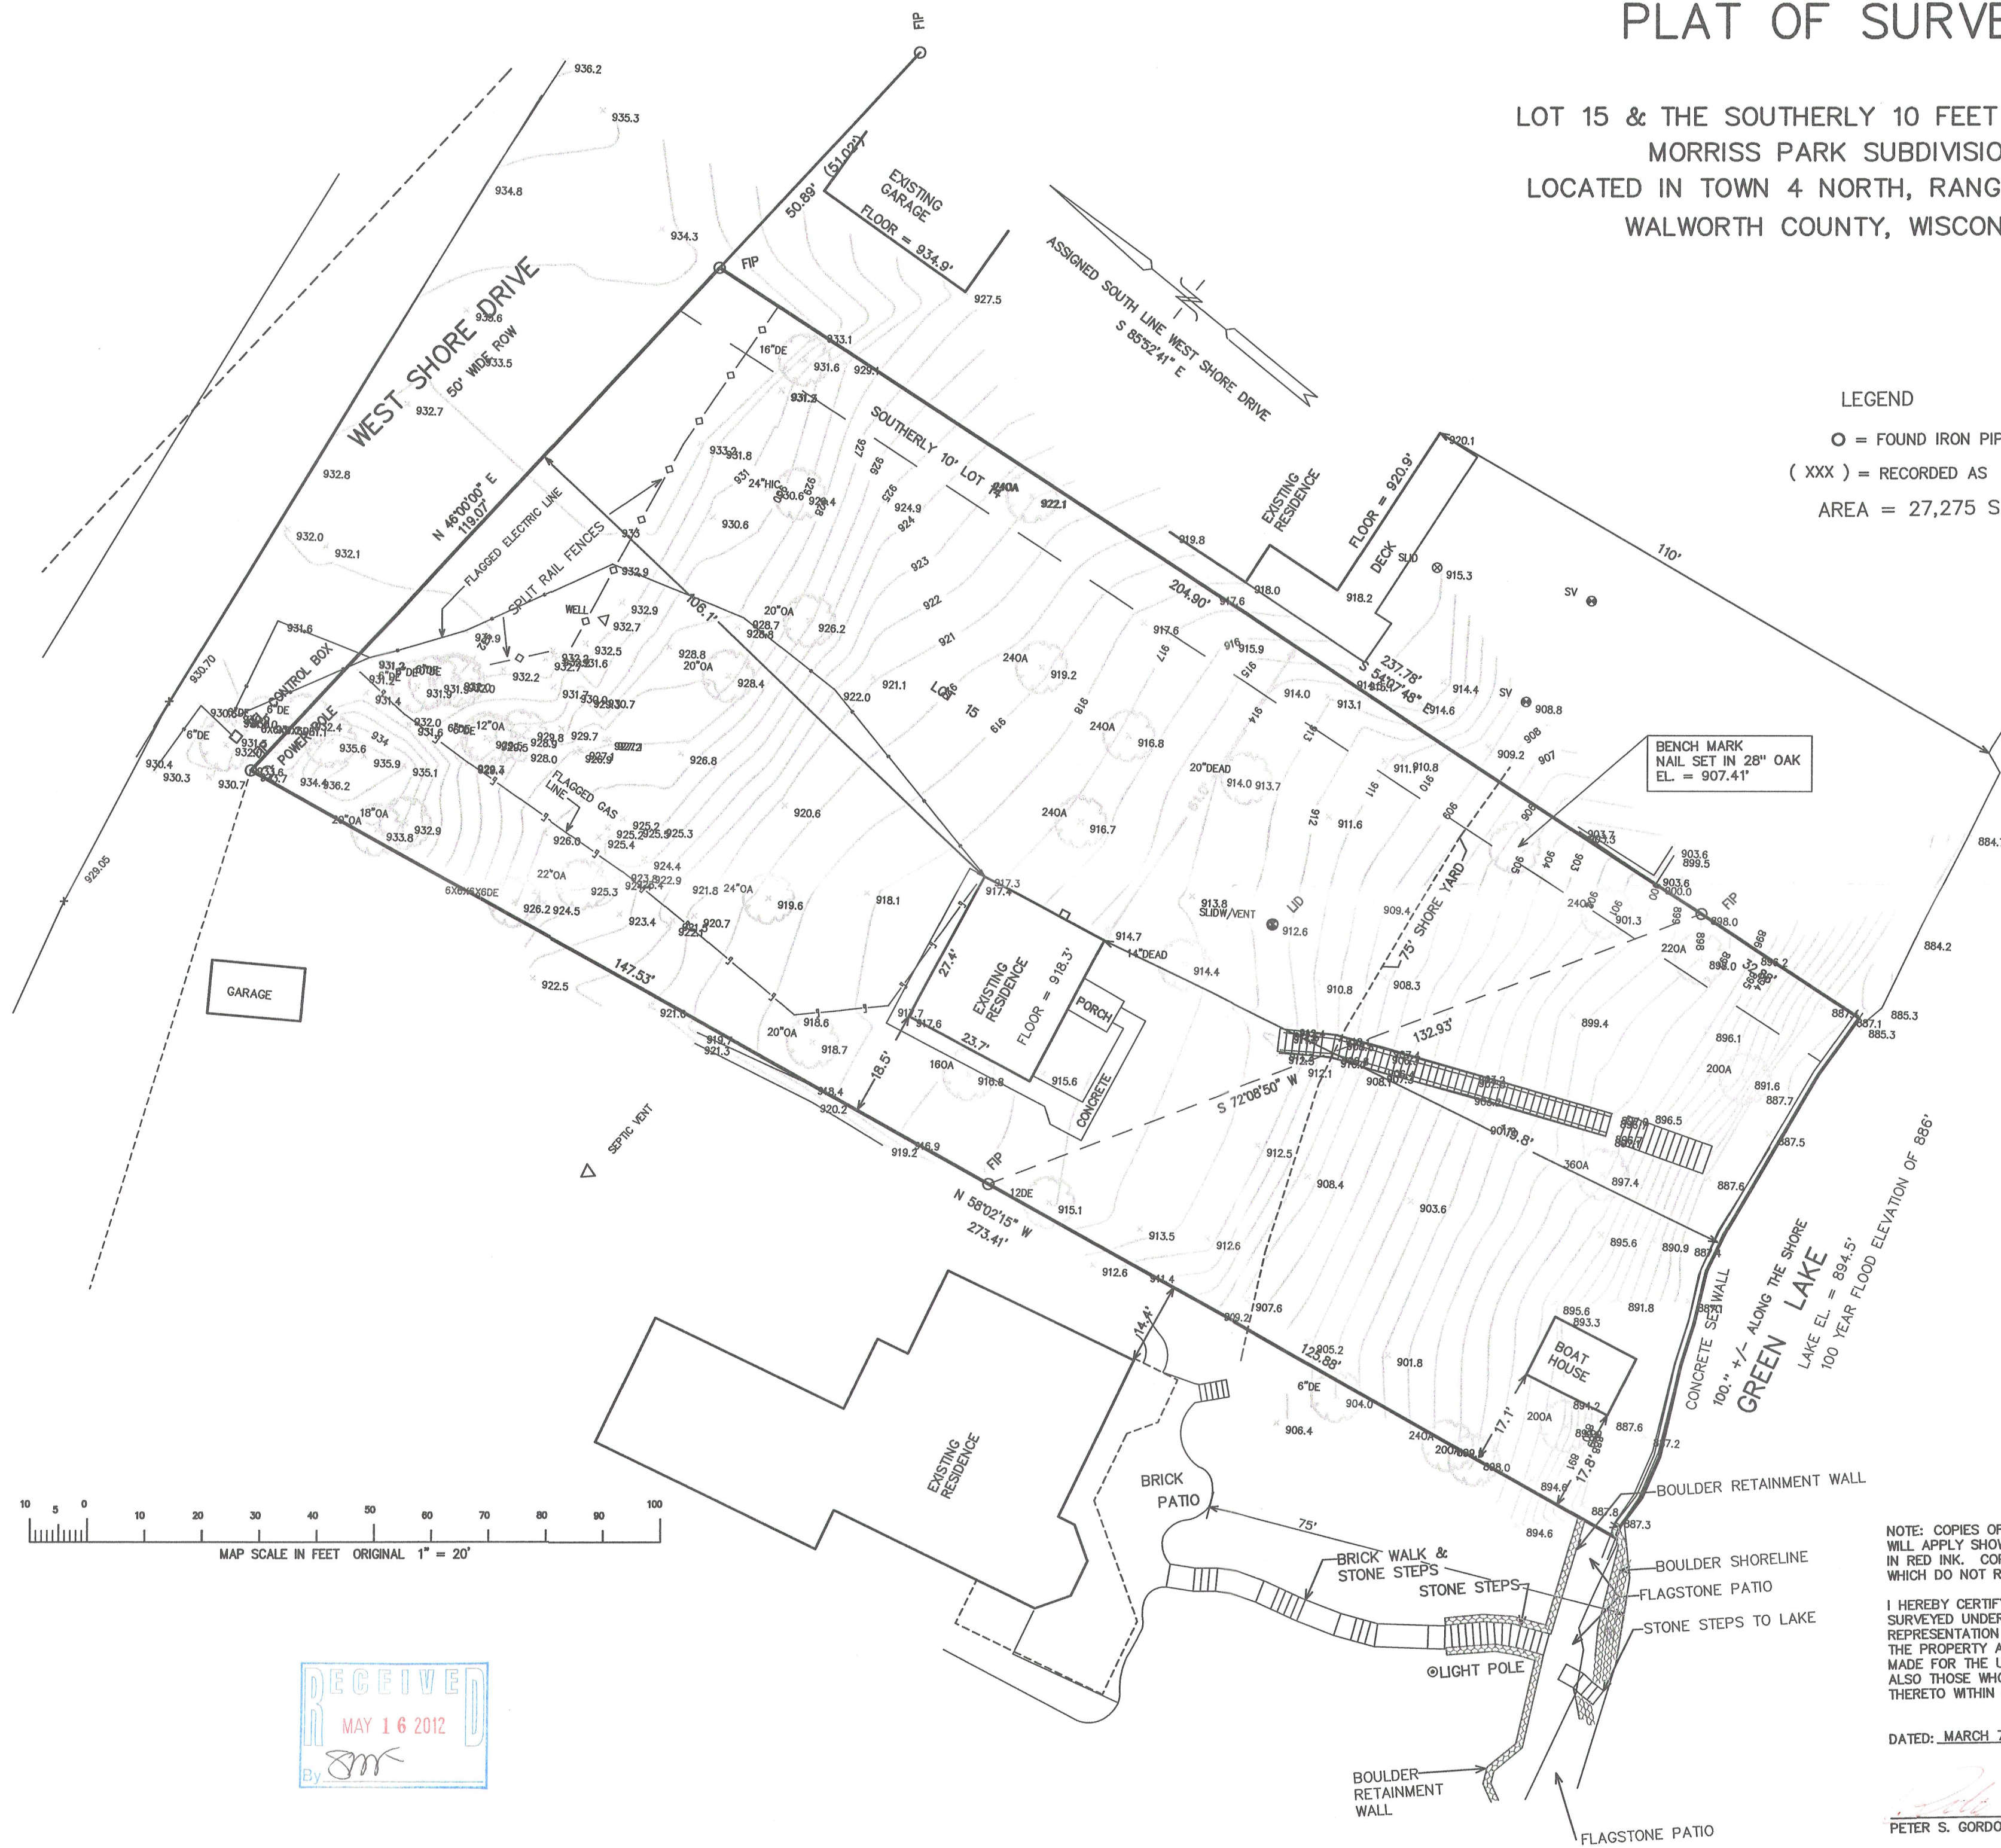

BENCH MARK
NAIL SET IN 28" OAK
EL. = 907.41'



NOTE: COPIES OF THIS MAP TO WHICH THE FOLLOWING CERTIFICATE WILL APPLY SHOW THE SURVEYOR'S ORIGINAL SEAL AND SIGNATURE IN RED INK. COPIES BY ANY OTHER MEANS MAY HAVE ALTERATIONS WHICH DO NOT REPRESENT THE SURVEYOR'S WORK PRODUCT.

I HEREBY CERTIFY THAT THE ABOVE DESCRIBED PROPERTY HAS BEEN SURVEYED UNDER MY DIRECTION AND THAT THE ABOVE MAP IS A TRUE REPRESENTATION THEREOF AND SHOWS THE SIZE AND LOCATION OF THE PROPERTY AND ITS EXTERIOR BOUNDARIES. THIS SURVEY IS MADE FOR THE USE OF THE PRESENT OWNERS OF THE PROPERTY, AND ALSO THOSE WHO PURCHASE, MORTGAGE, OR GUARANTEE THE TITLE THERETO WITHIN ONE YEAR FROM THE DATE HEREOF.

DATED: MARCH 7, 2012

PETER S. GORDON R.L.S. 2101

WORK ORDERED BY:
THELEN TOTAL CONSTRUCTION
PO BOX 17
ELKHORN, WI. 53121

FARRIS, HANSEN & ASSOCIATES, INC.
Engineering, Architecture, Surveying
7 Ridgway Court P.O. Box 437
ELKHORN, WISCONSIN 53121
Office: (414) 723-2098
Fax: (414) 723-5886

REVISIONS

PROJECT NO.
4976.12
DATE:
04-20-98
SHEET NO.
1 OF 1

