FARRIS, HANSEN, & ASSOCIATES, INC.

ENGINEERING, ARCHITECTURE, SURVEYING

7 RIDGWAY COURT – P.O. BOX 437, ELKHORN, WISCONSIN, 53121

PHONE: (414) 723–2098 FAX: (414) 723–5886

PLAT OF SURVEY


LOT 4 CSM 2011

RECORDED IN VOL. 9, PG. 303

LOCATED IN SECTION 25, TOWN 4 NORTH

RANGE 16 EAST, WALWORTH COUNTY, WI.

– WORK ORDERED BY –
PETZ CONSTRUCTION
W5369 GLADHURST LANE
ELKHORN, WI. 53121

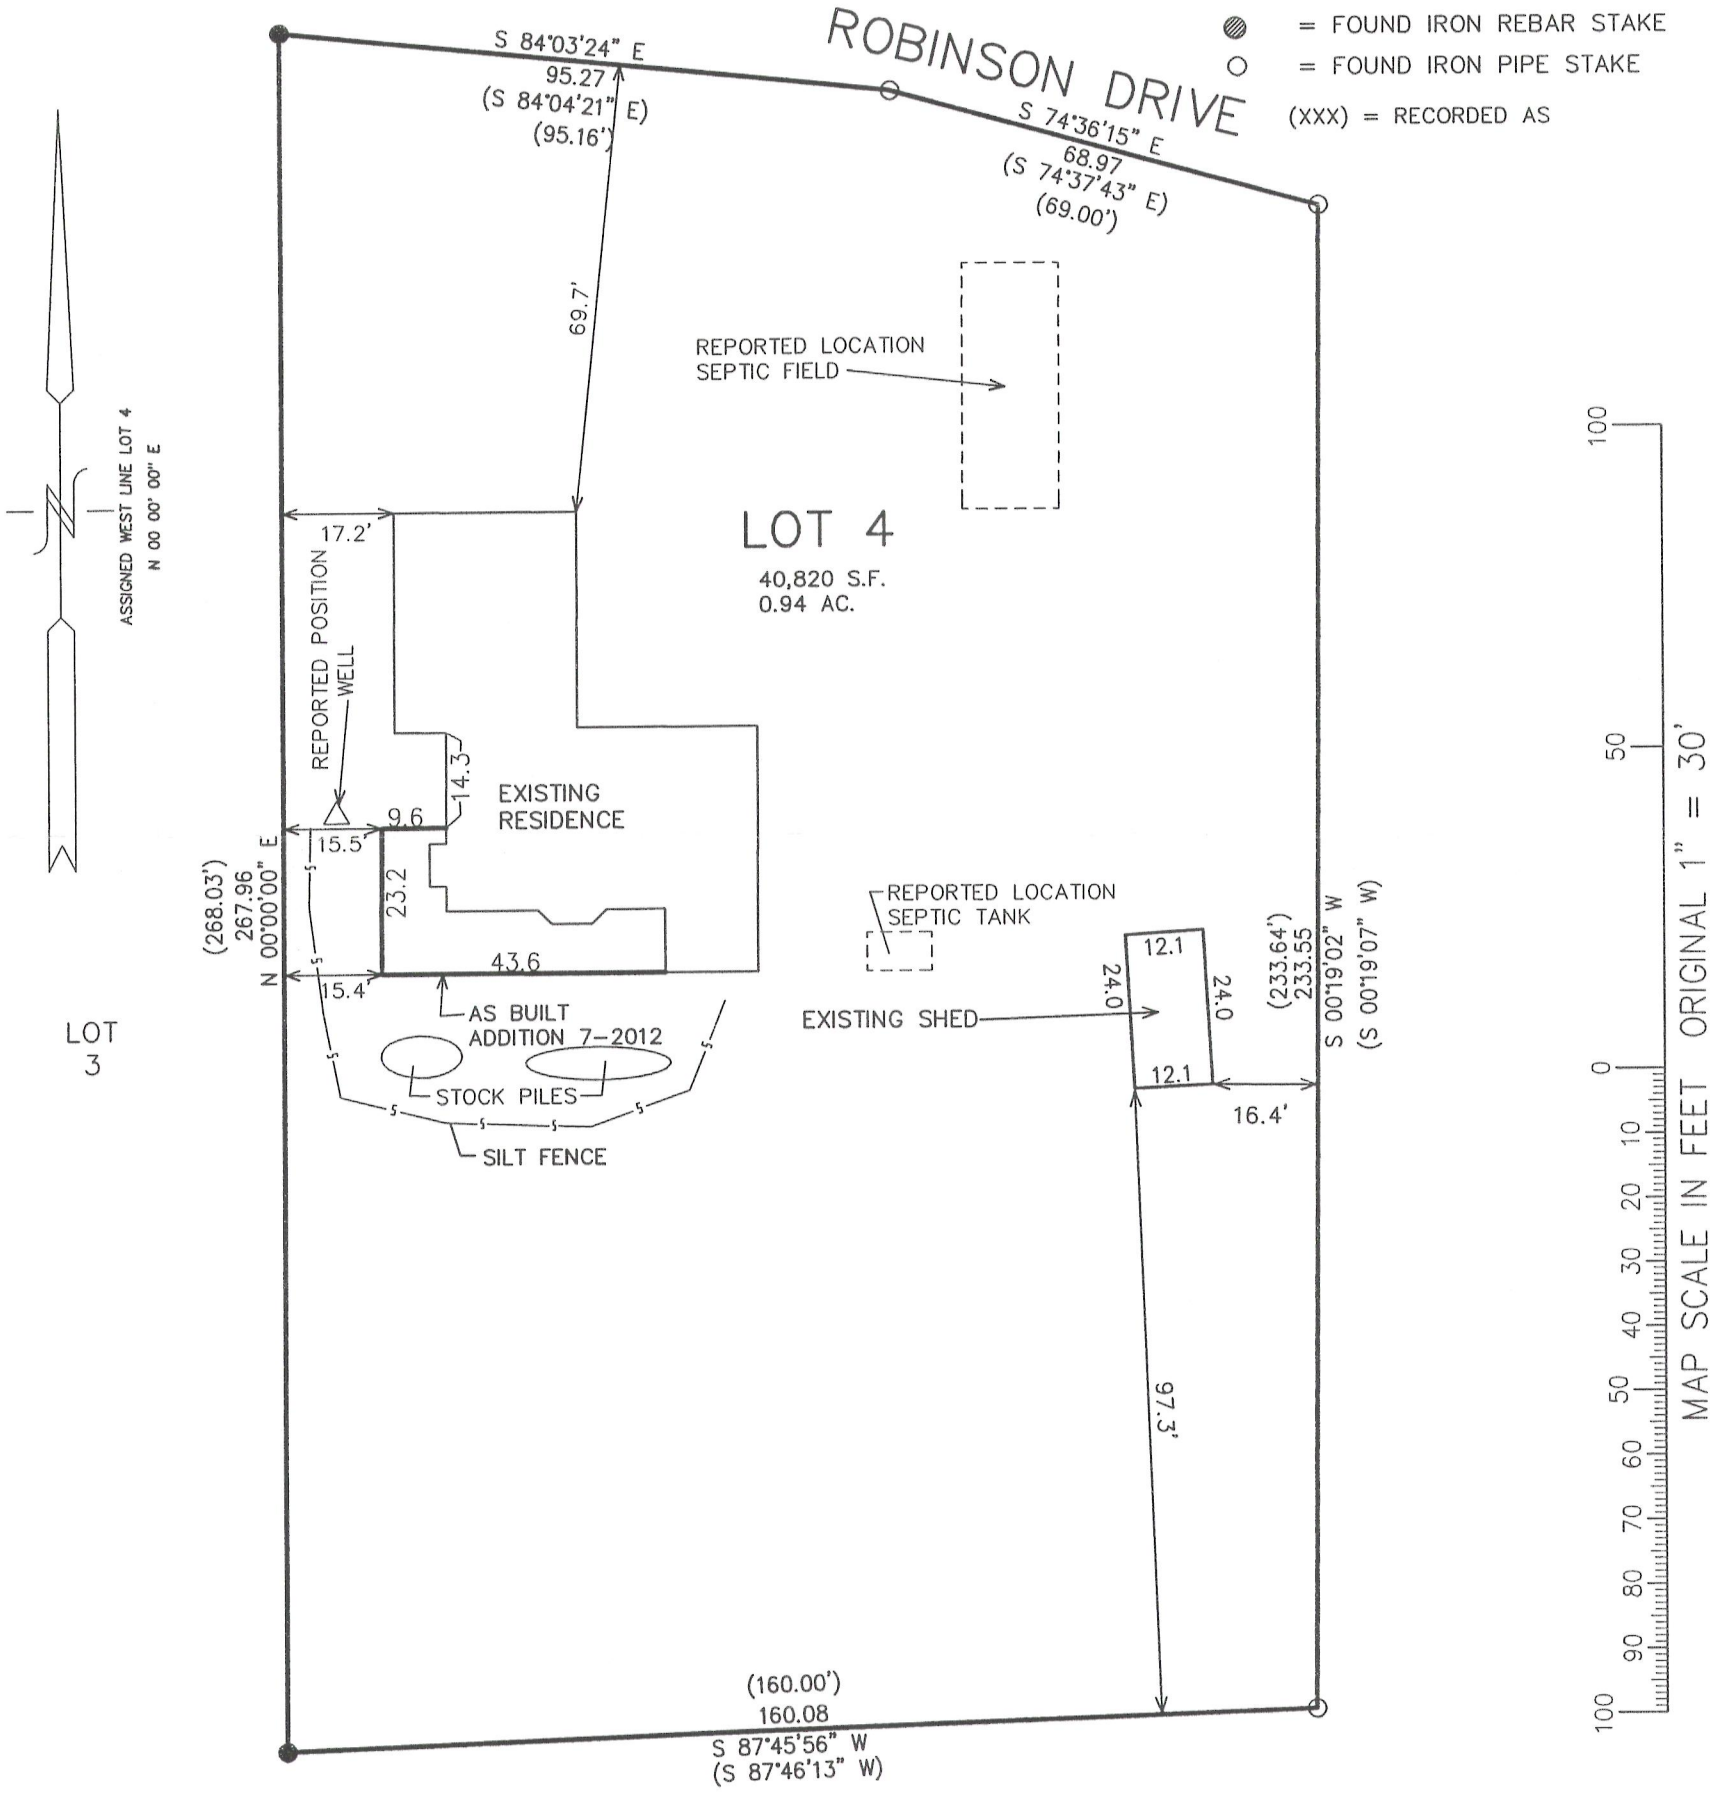

NOTE: COPIES OF THIS MAP TO WHICH THE FOLLOWING CERTIFICATE WILL APPLY SHOW SURVEYOR'S ORIGINAL SEAL AND SIGNATURE IN RED INK. COPIES BY ANY OTHER MEANS MAY HAVE ALTERATIONS WHICH DO NOT REPRESENT THE SURVEYOR'S WORK PRODUCT.

I HEREBY CERTIFY THAT THE ABOVE DESCRIBED PROPERTY HAS BEEN SURVEYED UNDER MY DIRECTION AND THAT THE ABOVE MAP IS A TRUE REPRESENTATION THEREOF AND SHOWS THE SIZE AND LOCATION OF THE PROPERTY AND ITS EXTERIOR BOUNDARIES. THIS SURVEY IS MADE FOR THE USE OF THE PRESENT OWNERS OF THE PROPERTY, AND ALSO THOSE WHO PURCHASE, MORTGAGE, OR GUARANTEE THE TITLE THERETO WITHIN ONE YEAR FROM THE DATE HEREOF.

DATED: 11–14–2003

REVISED 06–04–2012
TO SHOW PROPOSED ADDITION

REVISED 07–11–2012 TO SHOW
AS BUILT ADDITION FOUNDATION

WISCONSIN
PETER S. GORDON
S-2101
ELKHORN, WI
LAND SURVEYOR

RECEIVED
JUL 24 2012
By

PETER S. GORDON R.L.S. 2101

PROJECT 6422
DATE: 11–14–2003
SHEET 1 OF 1

HA 201100004

416-2598

JUL 11 2012