PREPARED FOR:
JERRY KROUPA
KEEFE REALE ESTATE
ELKHORN, WI


PATHFINDER SURVEYING INC.
(formerly)
J.K. SURVEYING INC.
P.O BOX 322
LAKE GENEVA, WI. 53147
WWW.PATHFINDERSURVEYING.NET
262-248-8303


PLAT OF SURVEY

- OF -


LOT 2 BLOCK 2 OF COOPERS MID LAKES SUBDIVISION LOCATED IN SECTION 35 , TOWN 4 NORTH , RANGE 16 EAST , WALWORTH COUNTY, WISCONSIN.

RECEIVED
OCT 30 2012
By

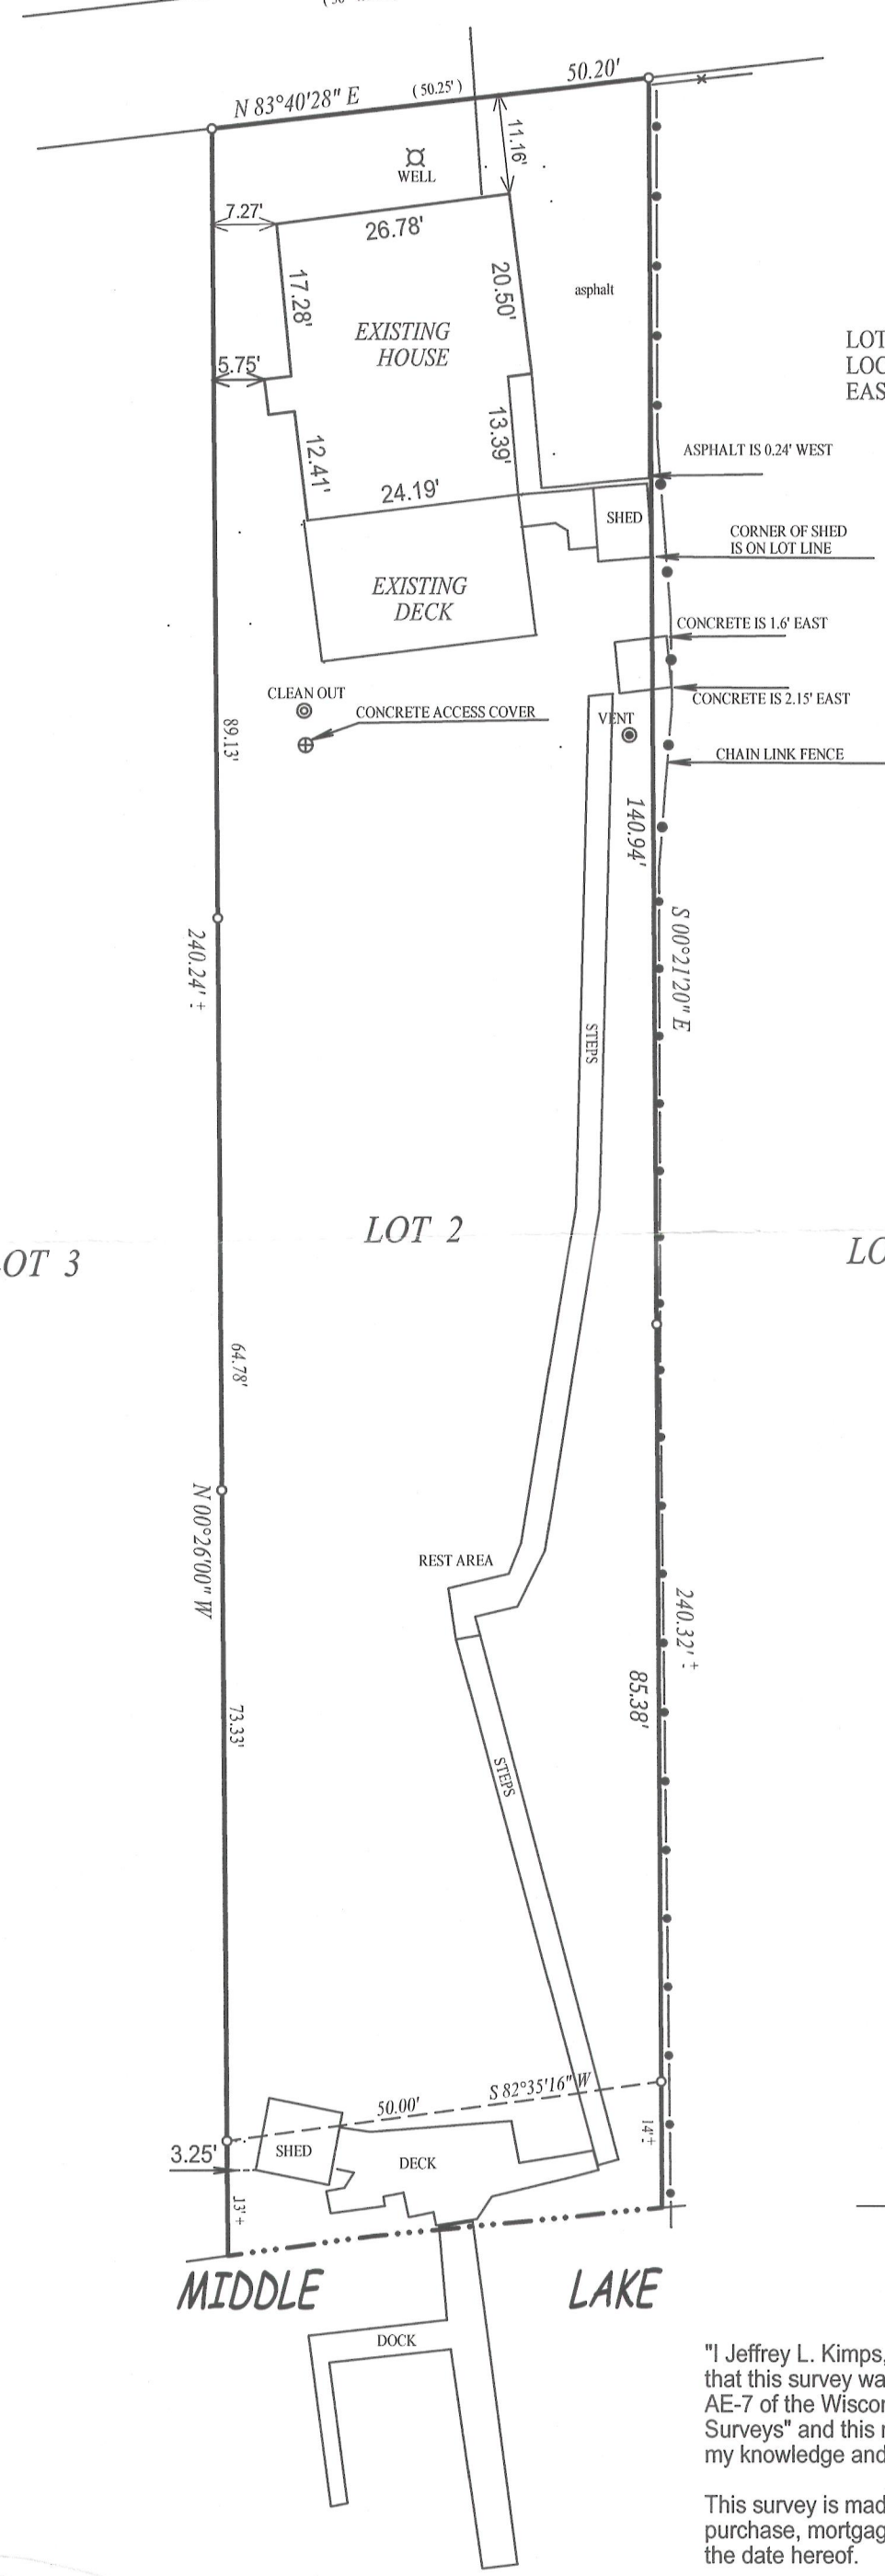

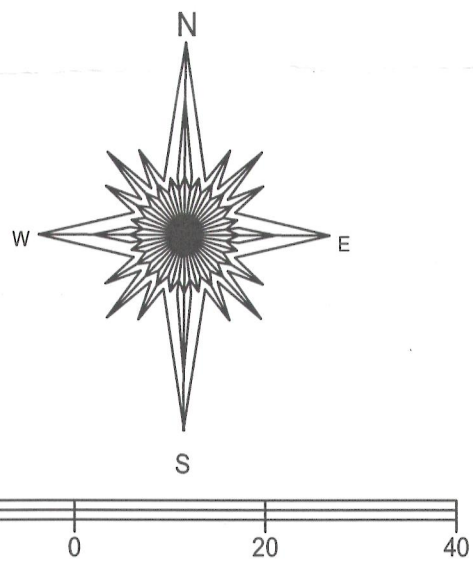

BASIS OF BEARING OF THIS PLAT :
ASSUMED DATUM.

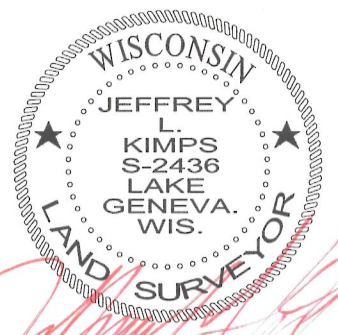

JEFFREY L KIMPS S - 2436
Wisconsin Registered Land Surveyor
(original if signed in red)

( )= recorded as
□ = found iron bar
○ = found iron pipe
● = set iron pipe
■ = set iron bar

SCALE 1" = 20'

JOB # 02-115

TAX ID # HCO 00005

"I Jeffrey L. Kimps, Wisconsin Registered Land Surveyor do hereby certify that that this survey was preformed by me and is in full compliance with chapter AE-7 of the Wisconsin Administrative Code " Minium Standards for Property Surveys" and this map is an accurate representation thereof to the best of my knowledge and belief.

This survey is made for the present owners of the property, and those who purchase, mortgage, or guarantee the title thereto, within one year from the date hereof.

DATED THIS 15TH DAY OF AUGUST, 2012.

416-2623