
PLAT OF SURVEY

LOT 11 OF MORRIS PARK SUBDIVISION

LOCATED IN THE SW 1/4 OF SECTON 26
TOWN 4 NORTH, RANGE 16 EAST
WALWORTH COUNTY, WISCONSIN

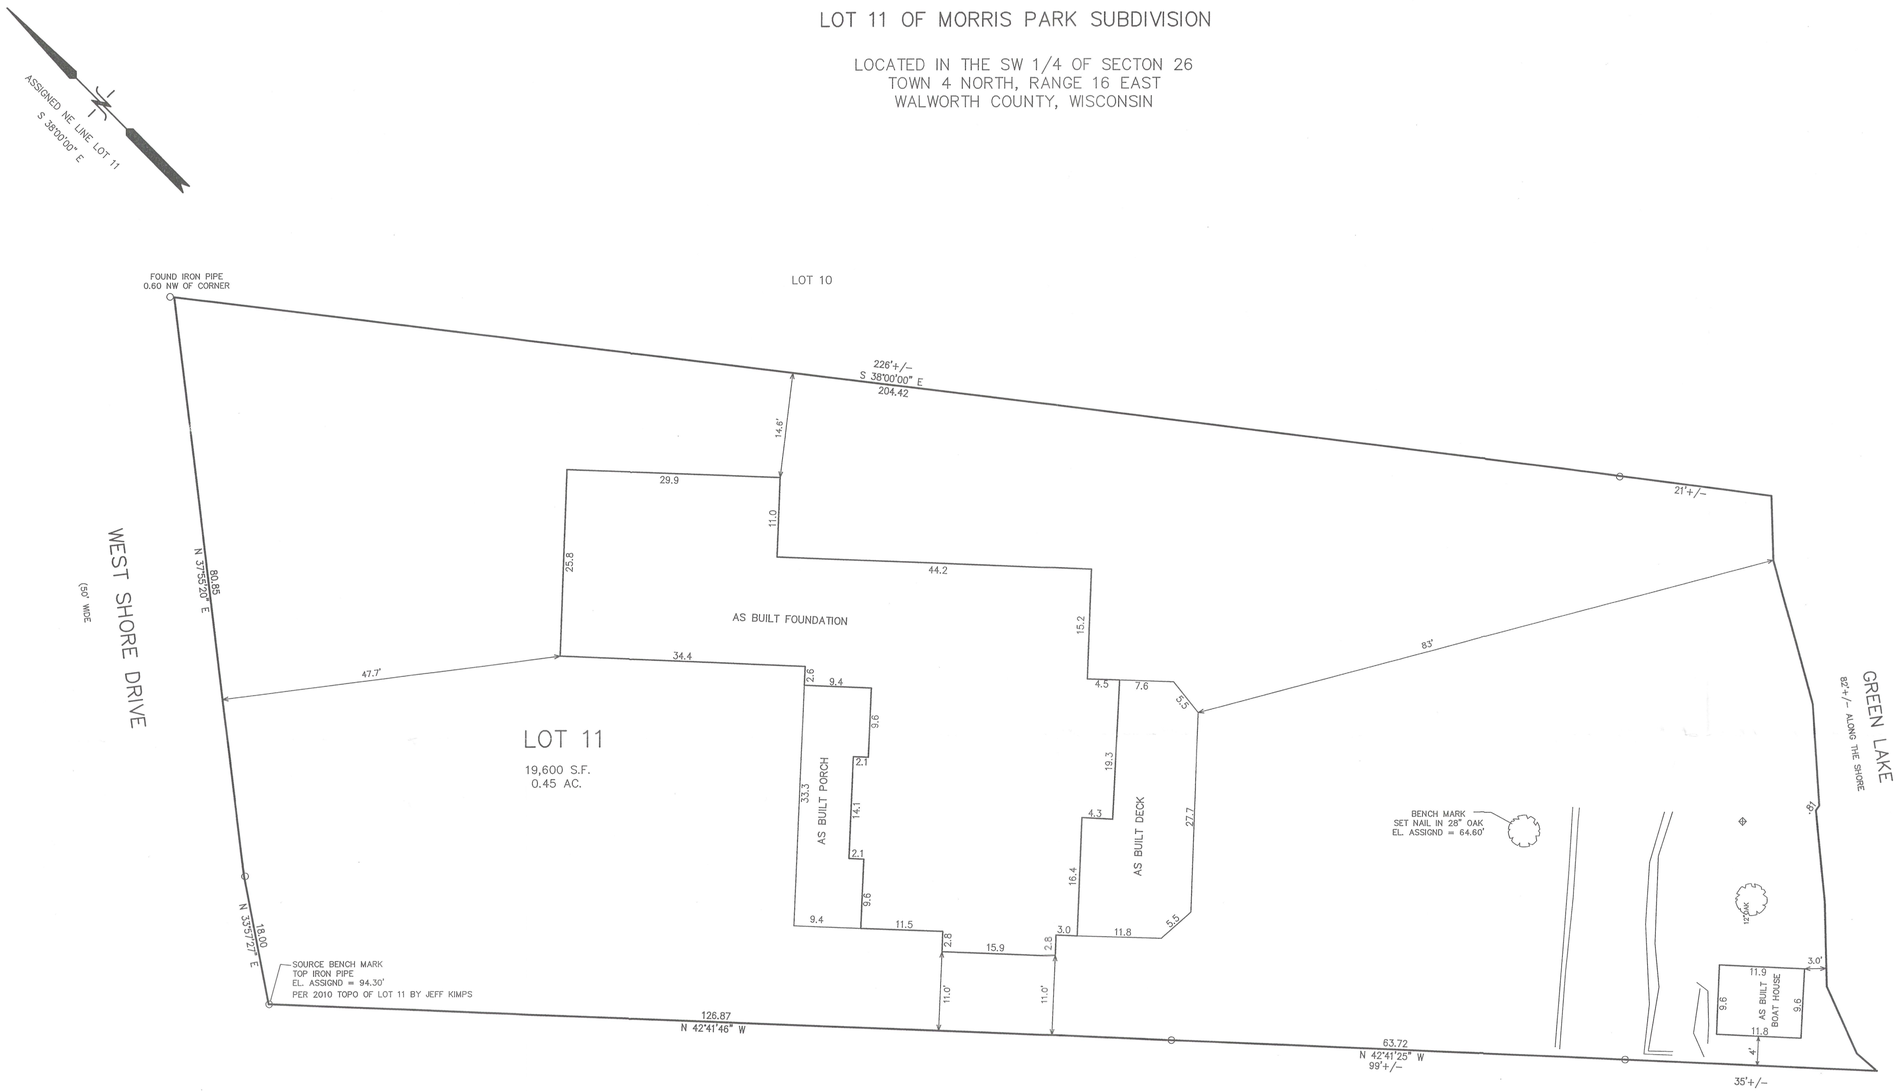

LEGEND

○ = FOUND IRON PIPE STAKE
(XXX) = RECORDED AS

10 5 0 10 20 30 40 50 60 70

MAP SCALE IN FEET ORIGINAL 1" = 10'

RECEIVED
DEC - 4 2012

NOTE: COPIES OF THIS MAP TO WHICH THE FOLLOWING CERTIFICATE WILL APPLY SHOW THE SURVEYOR'S ORIGINAL SEAL AND SIGNATURE IN RED INK. COPIES BY ANY OTHER MEANS MAY HAVE ALTERATIONS WHICH DO NOT REPRESENT THE SURVEYOR'S WORK PRODUCT.

I HEREBY CERTIFY THAT THE ABOVE DESCRIBED PROPERTY HAS BEEN SURVEYED UNDER MY DIRECTION AND THAT THE ABOVE MAP IS A TRUE REPRESENTATION THEREOF AND SHOWS THE SIZE AND LOCATION OF THE PROPERTY AND ITS EXTERIOR BOUNDARIES. THIS SURVEY IS MADE FOR THE USE OF THE PRESENT OWNERS OF THE PROPERTY, AND ALSO THOSE WHO PURCHASE, MORTGAGE, OR GUARANTEE THE TITLE THERETO WITHIN ONE YEAR FROM THE DATE HEREOF.

DATED: DEC. 9, 2011

PETER S. GORDON R.L.S. 2101

WISCONSIN
PETER S.
GORDON
S-2101
ELKHORN,
WI
LAND SURVEYOR

REVISED 10-02-2012
TO SHOW PROPOSED RESIDENCE

REVISED 11-15-2012
TO SHOW SIZE & LOCATION OF
AS BUILT STRUCTURES

WORK ORDERED BY:
SWEETWATER BUILDERS
PO BOX 404
DELAVAN, WI.

FARRIS, HANSEN & ASSOCIATES, INC.
ENGINEERING -- ARCHITECTURE -- SURVEYING
7 RIDGWAY COURT P.O. BOX 437
ELKHORN, WISCONSIN 53121
OFFICE: (262) 723-2098 FAX: (262) 723-5886

REVISIONS

PROJECT NO.
8469

DATE
12-09-2011

SHEET NO.
1 OF 1

11/15/2012 X:\Projects\8469\DCAD\ASBUILT

HMP-8

416-3629