

PLAT OF SURVEY
LOT 13 ARROWHEAD PARK ADDITION NO. 1
LOCATED IN GOVERNMENT LOT 3
SECTION 35, TOWN 4 NORTH, RANGE 16 EAST
WALWORTH COUNTY, WISCONSIN




WORK ORDERED BY:
DENISE FITZPATRICK
6256 WEST 127th PLACE
PALOS HEIGHTS, IL. 60463


FARRIS, HANSEN & ASSOCIATES, INC.
ENGINEERING - ARCHITECTURE - SURVEYING
7 RIDGWAY COURT P.O. BOX 437
ELKHORN, WISCONSIN 53121
OFFICE: (262) 723-2098 FAX: (262) 723-5886

REVISIONS


PROJECT NO.
8710
DATE:
12-07-2012
SHEET NO.
1 OF 1

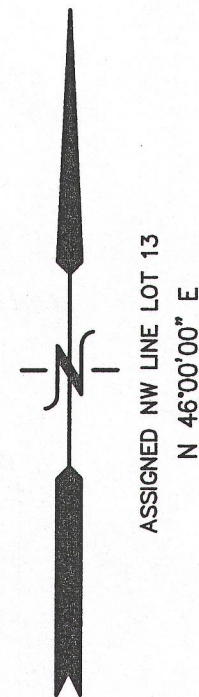

ASSIGNED NW LINE LOT 13
N 46°00'00" E

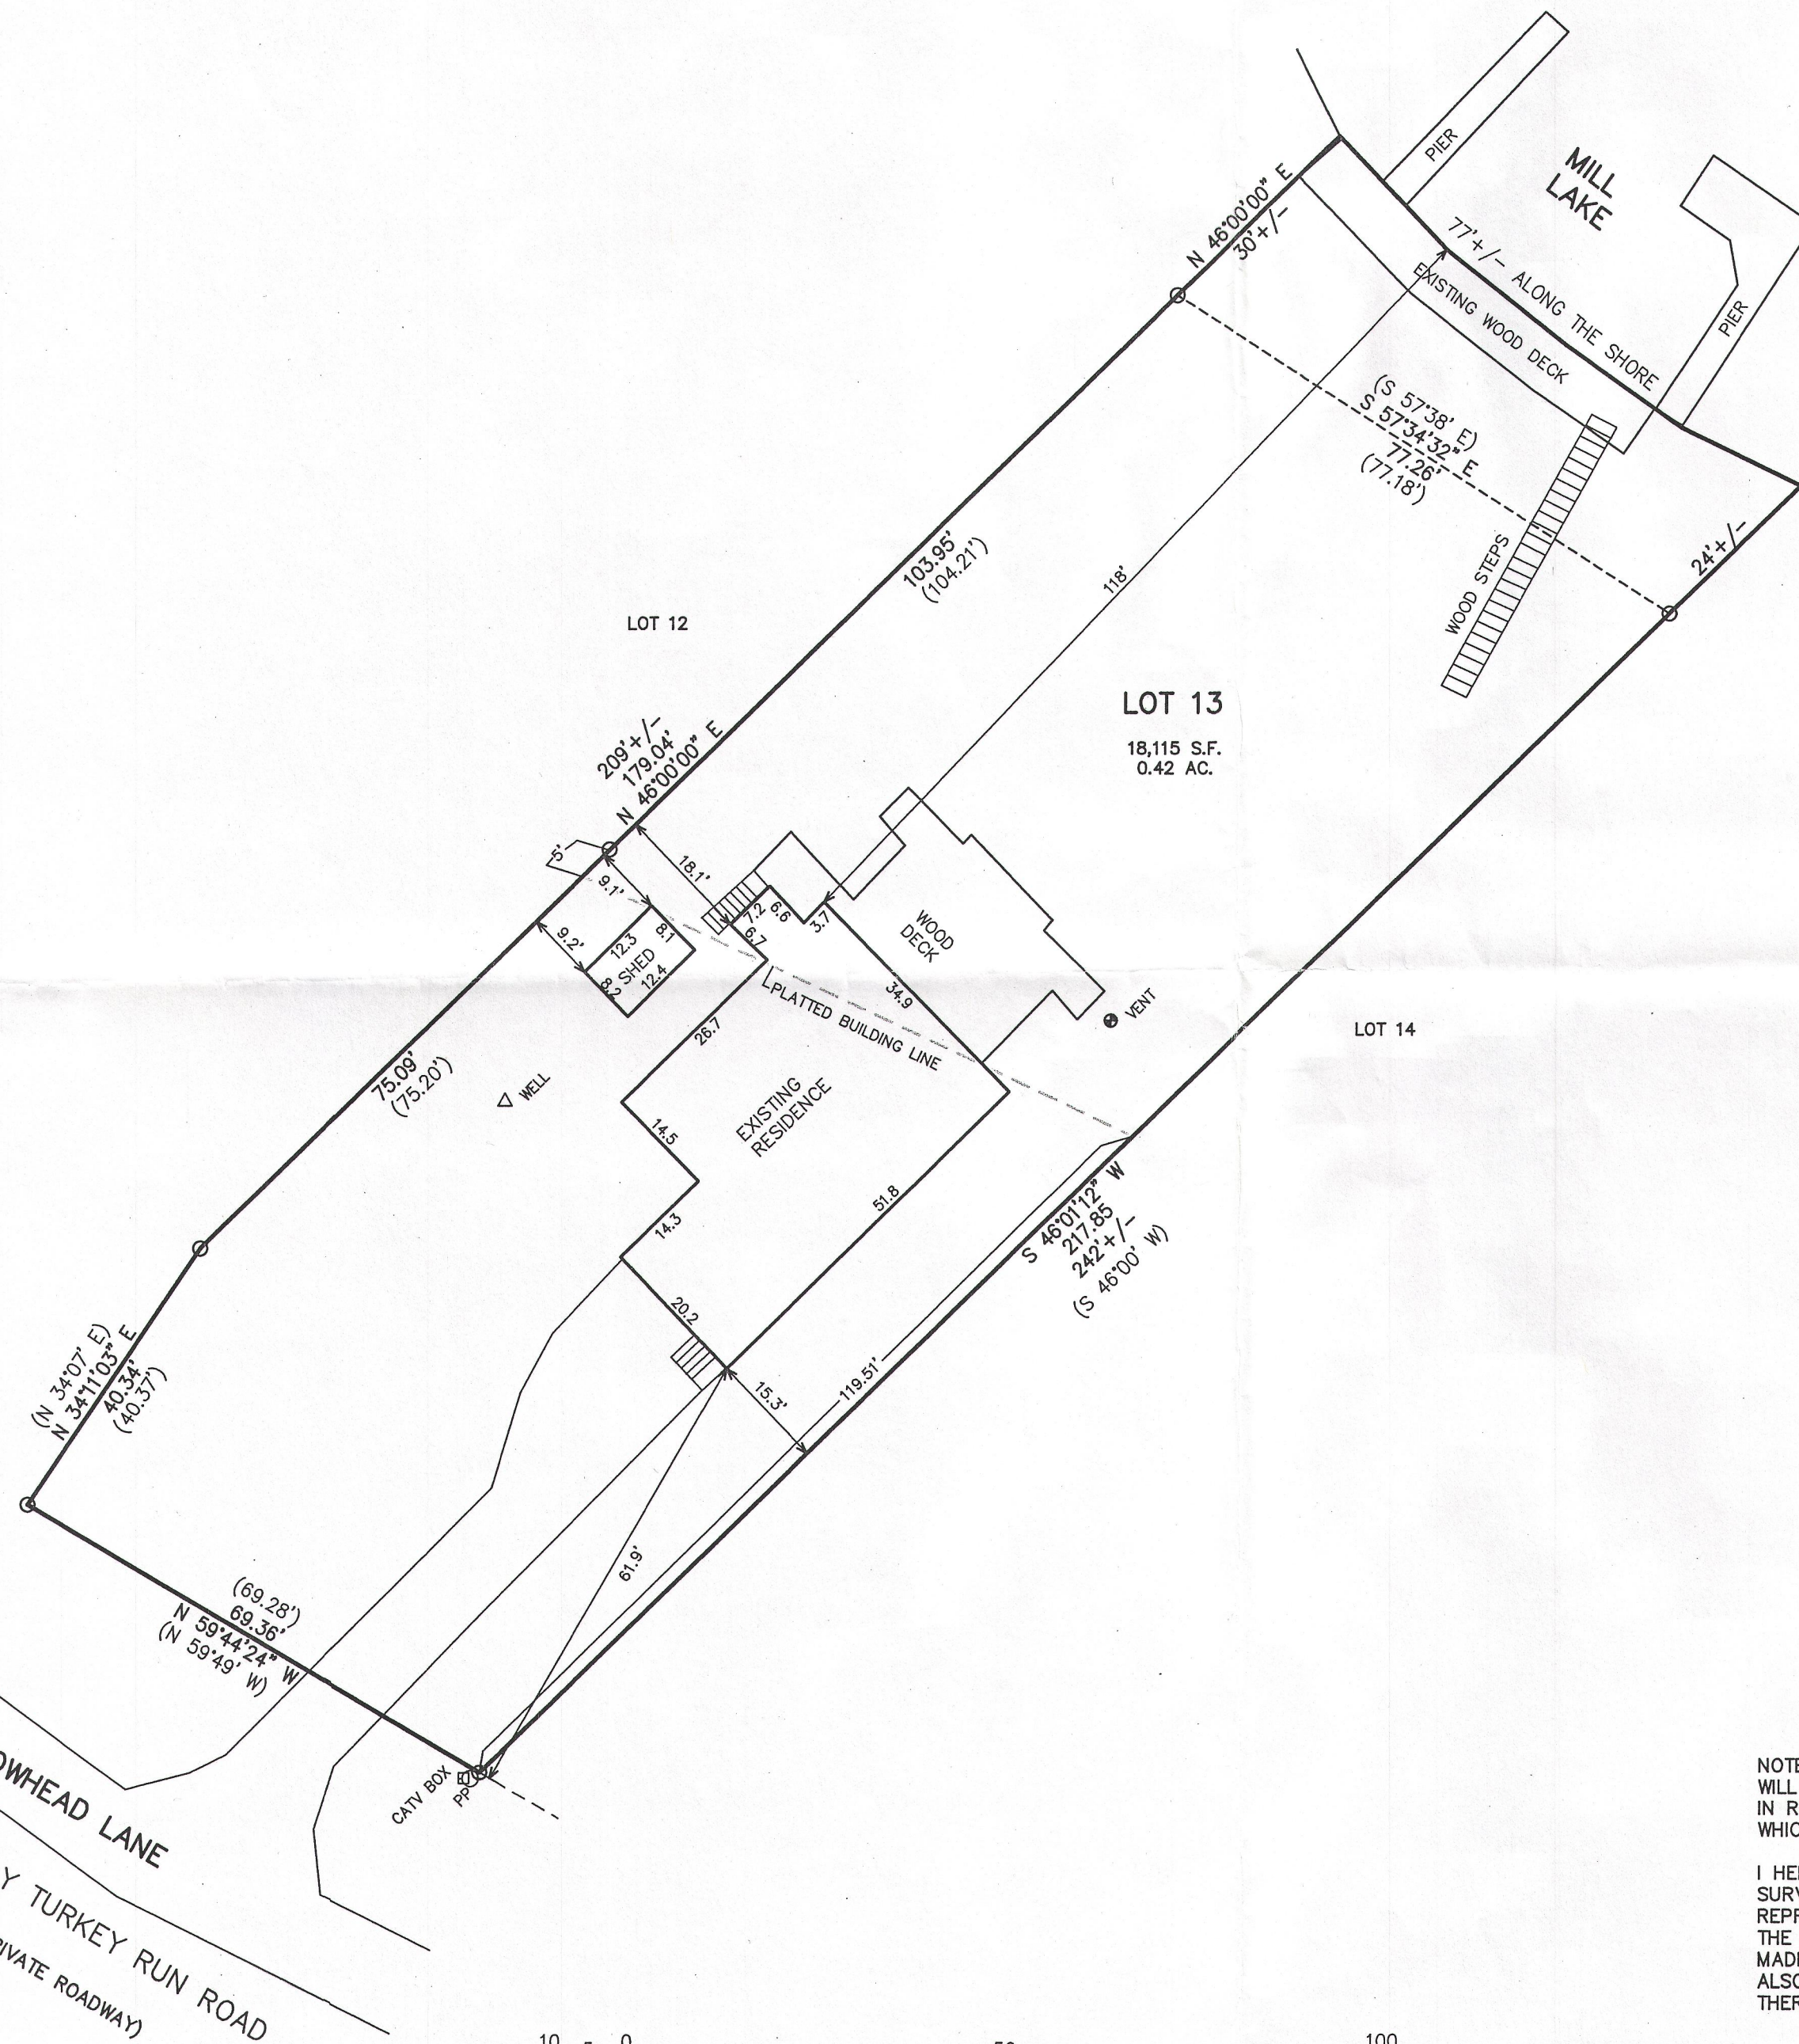

LEGEND
○ = FOUND IRON PIPE STAKE
(XXX) = RECORDED AS


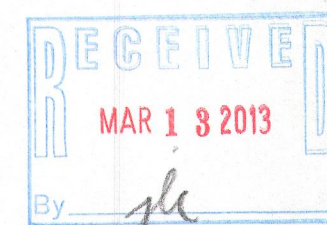


NOTE: COPIES OF THIS MAP TO WHICH THE FOLLOWING CERTIFICATE
WILL APPLY SHOW THE SURVEYOR'S ORIGINAL SEAL AND SIGNATURE
IN RED INK. COPIES BY ANY OTHER MEANS MAY HAVE ALTERATIONS
WHICH DO NOT REPRESENT THE SURVEYOR'S WORK PRODUCT.

I HEREBY CERTIFY THAT THE ABOVE DESCRIBED PROPERTY HAS BEEN
SURVEYED UNDER MY DIRECTION AND THAT THE ABOVE MAP IS A TRUE
REPRESENTATION THEREOF AND SHOWS THE SIZE AND LOCATION OF
THE PROPERTY AND ITS EXTERIOR BOUNDARIES. THIS SURVEY IS
MADE FOR THE USE OF THE PRESENT OWNERS OF THE PROPERTY, AND
ALSO THOSE WHO PURCHASE, MORTGAGE, OR GUARANTEE THE TITLE
THERETO WITHIN ONE YEAR FROM THE DATE HEREOF.

DATED: DECEMBER 7, 2012

Peter S. Gordon
PETER S. GORDON R.L.S. 2101

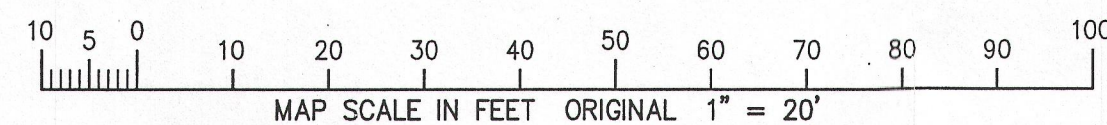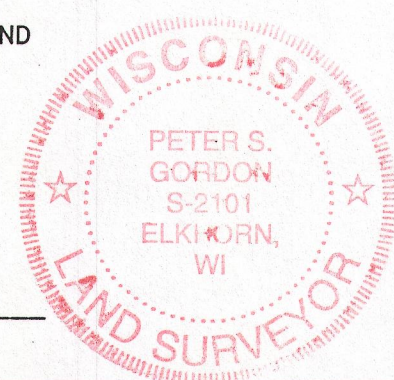

HAPA 00003

416-2635