


PREPARED FOR
KAREN OSTERMEIER
KEEFE REAL ESTATE
751 GENEVA PARKWAY
LAKE GENEVA WI. 53147

KROTT SURVEYING INC.
N3705 WILLOW BEND LANE
LAKE GENEVA WI. 53147
PHONE # (262)248-3697
FAX # (262)249-0639

PLAT OF SURVEY

-OF-

LOT 56 BUBBLING SPRINGS SUBDIVISION, FIRST ADDITION, IN THE TOWN OF LA GRANGE ACCORDING TO THE RECORD PLAT THEREOF RECORDED IN VOLUME 13 OF PLATS, PAGES 44-46, WALWORTH COUNTY, WISCONSIN.

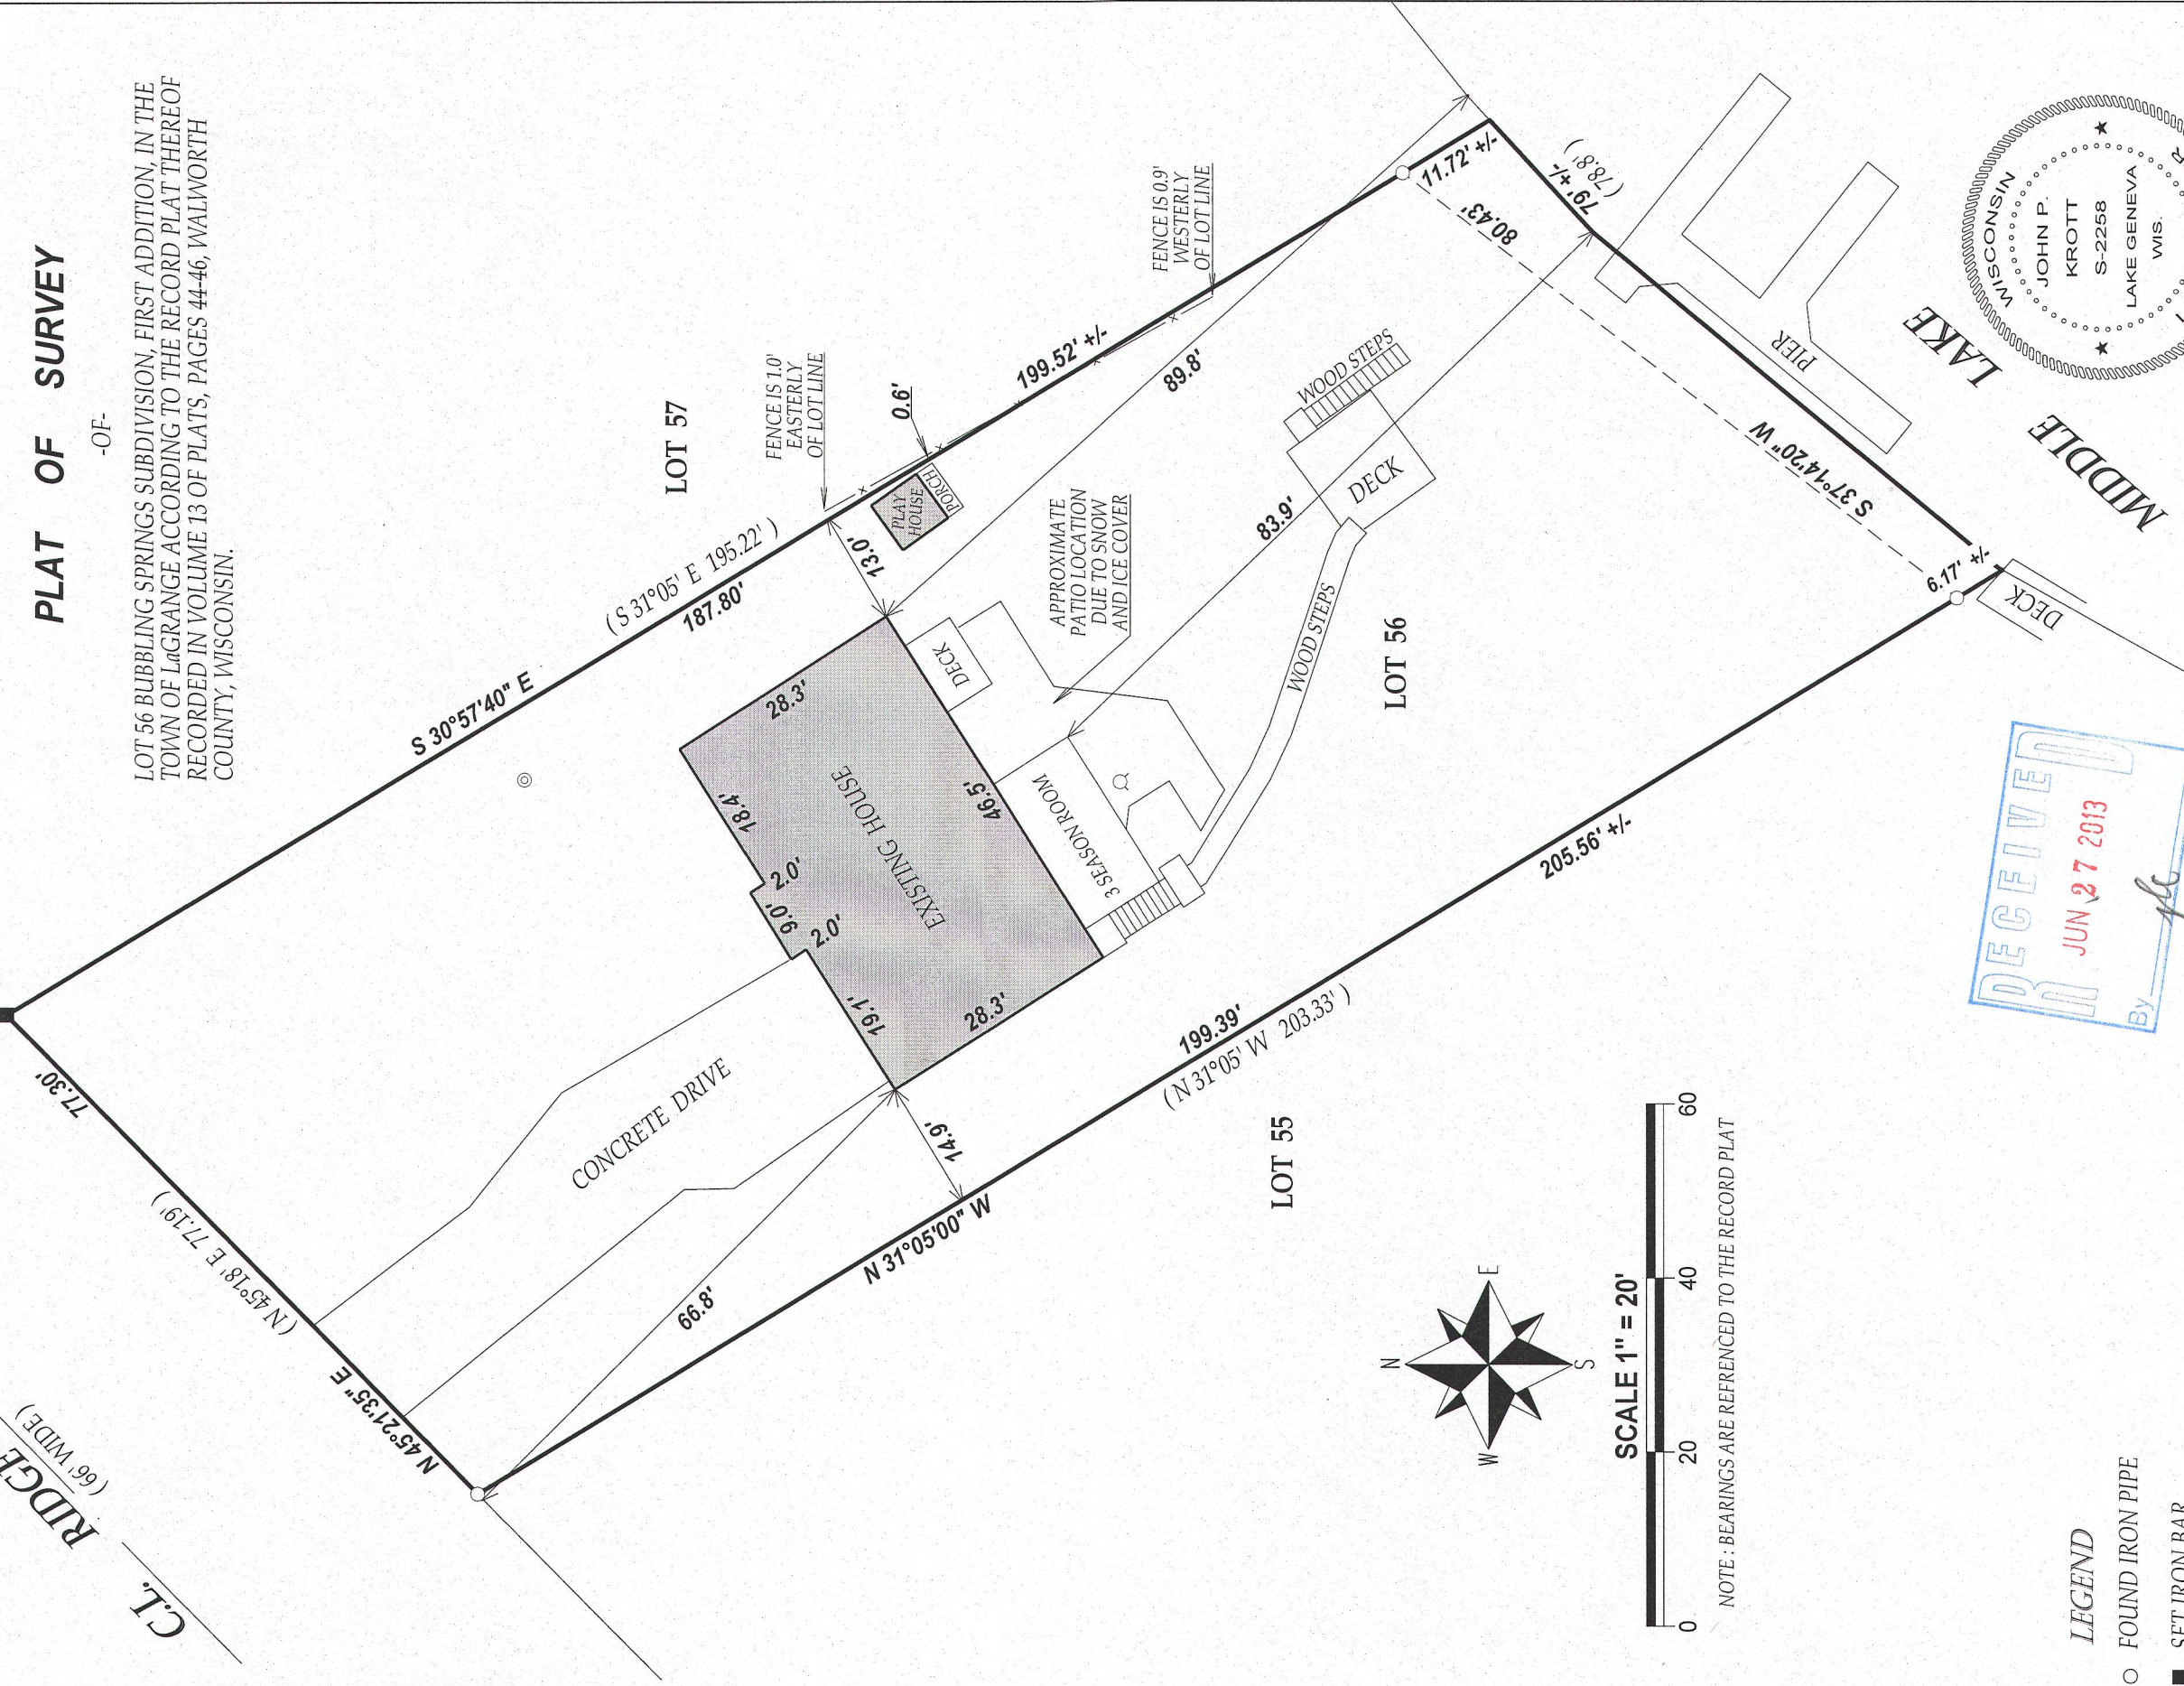

NOTE: BEARINGS ARE REFERENCED TO THE RECORD PLAT

LEGEND

- FOUND IRON PIPE
- SET IRON BAR
- WELL
- ◎ CLEAN OUT
- (XX) RECORDED AS

TAX ID # HBS100025

JOB # 13-033



I have surveyed the above-described property and the above map is a true representation thereof and shows the size and location of the property, its exterior boundaries, the location and dimensions of all structures thereon, fences apparent easements and roadways and visible encroachments, if any.

This survey is made for the exclusive use of the present owners of the property, and also those who purchase, mortgage, or insure the title thereto within one (1) year from date hereof; and as to them I warrant the accuracy of said survey map.



DATED THIS 21st DAY OF MARCH 2013

JOHN KROTT S - 2258
Wisconsin Registered Land Surveyor
(original if signed in red)

416-2650