
744871

CERTIFIED SURVEY MAP NO. 4174

A PARCEL SPLIT LOCATED IN PART OF THE NE 1/4 AND SE 1/4 OF THE SW 1/4 AND THE NW 1/4 AND SW 1/4 OF THE SE 1/4 OF SECTION 23 AND THE NE 1/4 OF THE NW 1/4 AND THE NW 1/4 OF THE NE 1/4 OF SECTION 26, ALL IN TOWN 4 NORTH, RANGE 16 EAST, TOWN OF LAGRANGE, WALWORTH COUNTY, WISCONSIN

LEGEND
- ○ = FOUND IRON PIPE STAKE, 1 3/8" O.D.
- ● = FOUND IRON REBAR STAKE, 3/4" DIA.
- ⊞ = FOUND CONCRETE COUNTY MONUMENT W/ BRASS CAP
- ⌀ = SET IRON REBAR STAKE, 3/4" DIA. 24"x1.13 lbs./ft.
- (XXX) = RECORDED AS

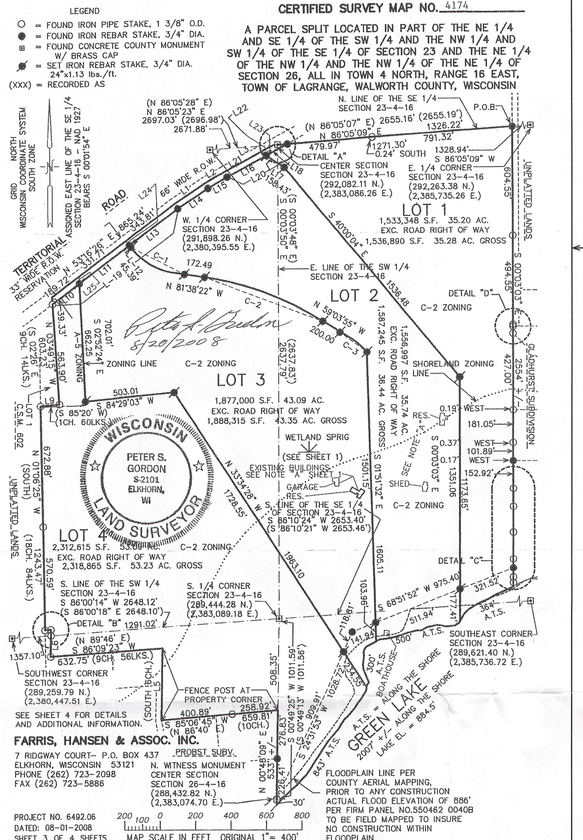

PROJECT NO. 6492.06
DATED: 08-01-2008
SHEET 3 OF 4 SHEETS

MAP SCALE IN FEET ORIGINAL 1" = 400'


CSM # 4174

Vol 26 Page 211

FARRIS, HANSEN & ASSOC. INC.
7 RIDGWAY COURT– P.O. BOX 437
ELKHORN, WISCONSIN 53121
PHONE (262) 723-2098
FAX (262) 723-5886

AS–BUILT MAPPING
PART OF LOT 2 CSM 4174

REC. AS DOC. 744871
LOCATED IN THE SW 1/4 & SE 1/4 OF SECTION 23 & THE NW 1/4 & NE 1/4 OF SECTION 26
TOWN 4 NORTH, RANGE 16 EAST
WALWORTH COUNTY, WISCONSIN

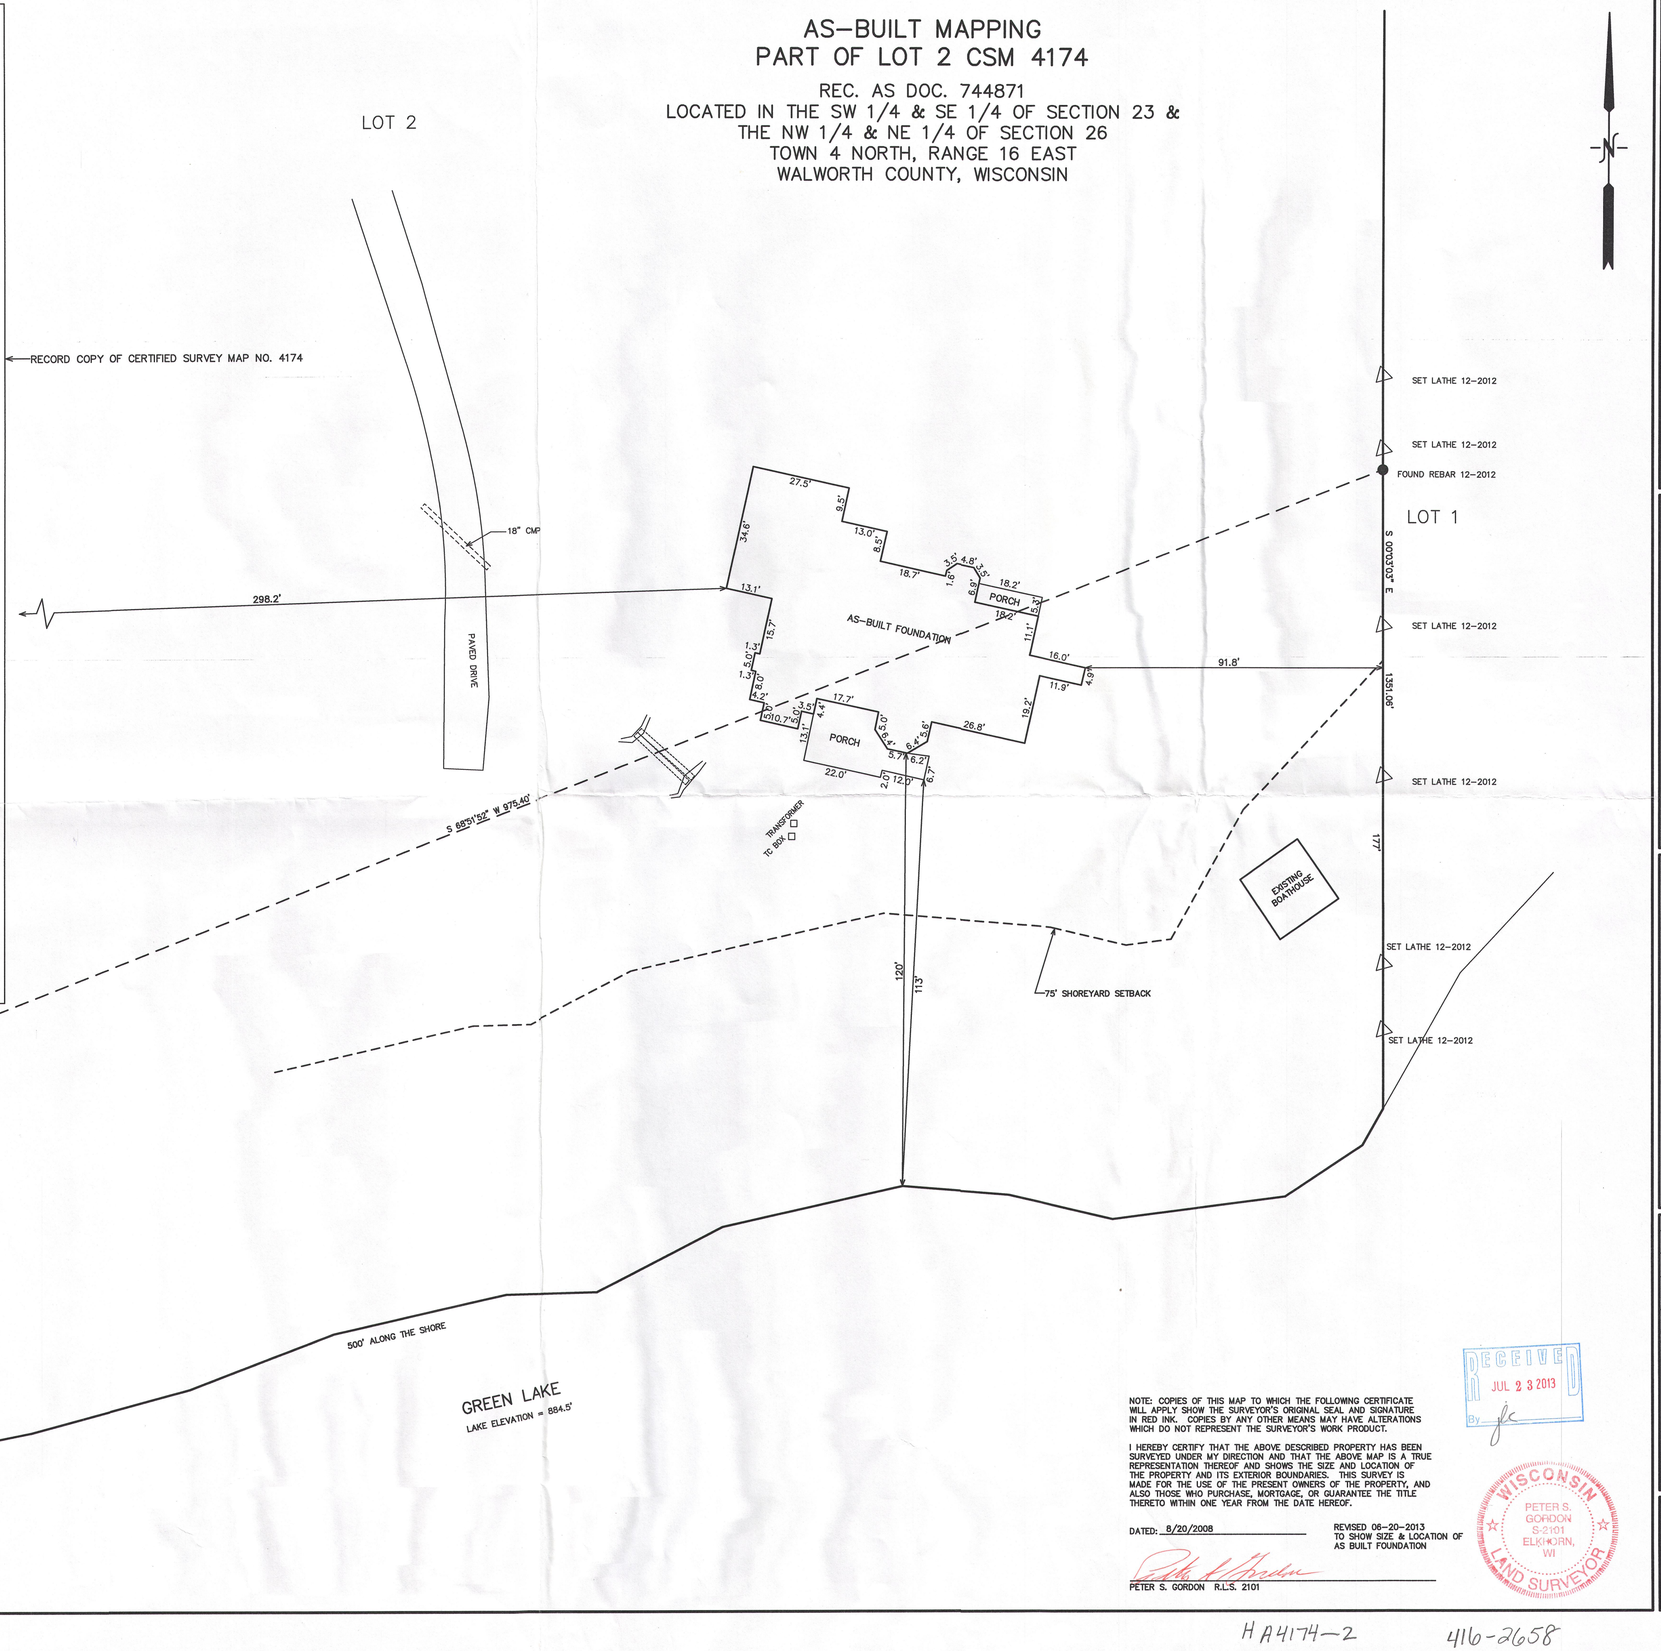

NOTE: COPIES OF THIS MAP TO WHICH THE FOLLOWING CERTIFICATE WILL APPLY SHOW THE SURVEYOR'S ORIGINAL SEAL AND SIGNATURE IN RED INK. COPIES BY ANY OTHER MEANS MAY HAVE ALTERATIONS WHICH DO NOT REPRESENT THE SURVEYOR'S WORK PRODUCT.

I HEREBY CERTIFY THAT THE ABOVE DESCRIBED PROPERTY HAS BEEN SURVEYED UNDER MY DIRECTION AND THAT THE ABOVE MAP IS A TRUE REPRESENTATION THEREOF AND SHOWS THE SIZE AND LOCATION OF THE PROPERTY AND ITS EXTERIOR BOUNDARIES. THIS SURVEY IS MADE FOR THE USE OF THE PRESENT OWNERS OF THE PROPERTY, AND ALSO THOSE WHO PURCHASE, MORTGAGE, OR GUARANTEE THE TITLE THERETO WITHIN ONE YEAR FROM THE DATE HEREOF.

DATED: 8/20/2008

REVISED 06–20–2013 TO SHOW SIZE & LOCATION OF AS BUILT FOUNDATION

PETER S. GORDON R.L.S. 2101

RECEIVED JUL 23 2013 By jlc

WISCONSIN PETER S. GORDON S-2101 ELKHORN, WI LAND SURVEYOR

ASBUILT MAPPING
TOWN OF LA GRANGE, WALWORTH COUNTY, WISCONSIN

ORDERED BY
THELEN TOTAL CONSTRUCTION FOR
THOMAS J. FORMOLO

FARRIS, HANSEN & ASSOCIATES, INC.
ENGINEERING – ARCHITECTURE – SURVEYING
7 RIDGWAY COURT P.O. BOX 437
ELKHORN, WISCONSIN 53121
OFFICE: (262) 723-2098 FAX: (262) 723-5886

REVISIONS
01–03–2012 UPDATE INFO
02/07/2013 – KB ADVANCE PLAN
4/15/2013–KB ADJUCT PLAN FOR NEW BUILDING LOCATION
6/13/2013–KB TO SHOW SIZE & LOC. OF ASBUILT FOUNDATION

PROJECT NO. 6492.13
DATE 09–25–2008
SHEET NO. 1 OF 1

6/20/2013 X:\Projects\6492\DCAD\ASBLT_LOT2

HA4174–2

416–2658