
PREPARED FOR
TOM MARTIN
KEEFE REAL ESTATE
ELKHORN WI.
&
CHRISTINE B. FRANK

PATHFINDER SURVEYING INC.
(formerly)
J.K. SURVEYING INC.
P.O BOX 322
LAKE GENEVA, WI. 53147
WWW.PATHFINDERSURVEYING.NET
262-248-8303

PLAT OF SURVEY

- OF -

LOT 2 OF STRAWBERRY BANKE PLANTATION, A SUBDIVISION LOCATED IN THE SW 1/4 OF SECTION 36, TOWN 4 NORTH, RANGE 16 EAST, TOWN OF LAGRANGE, COUNTY OF WALWORTH AND STATE OF WISCONSIN.

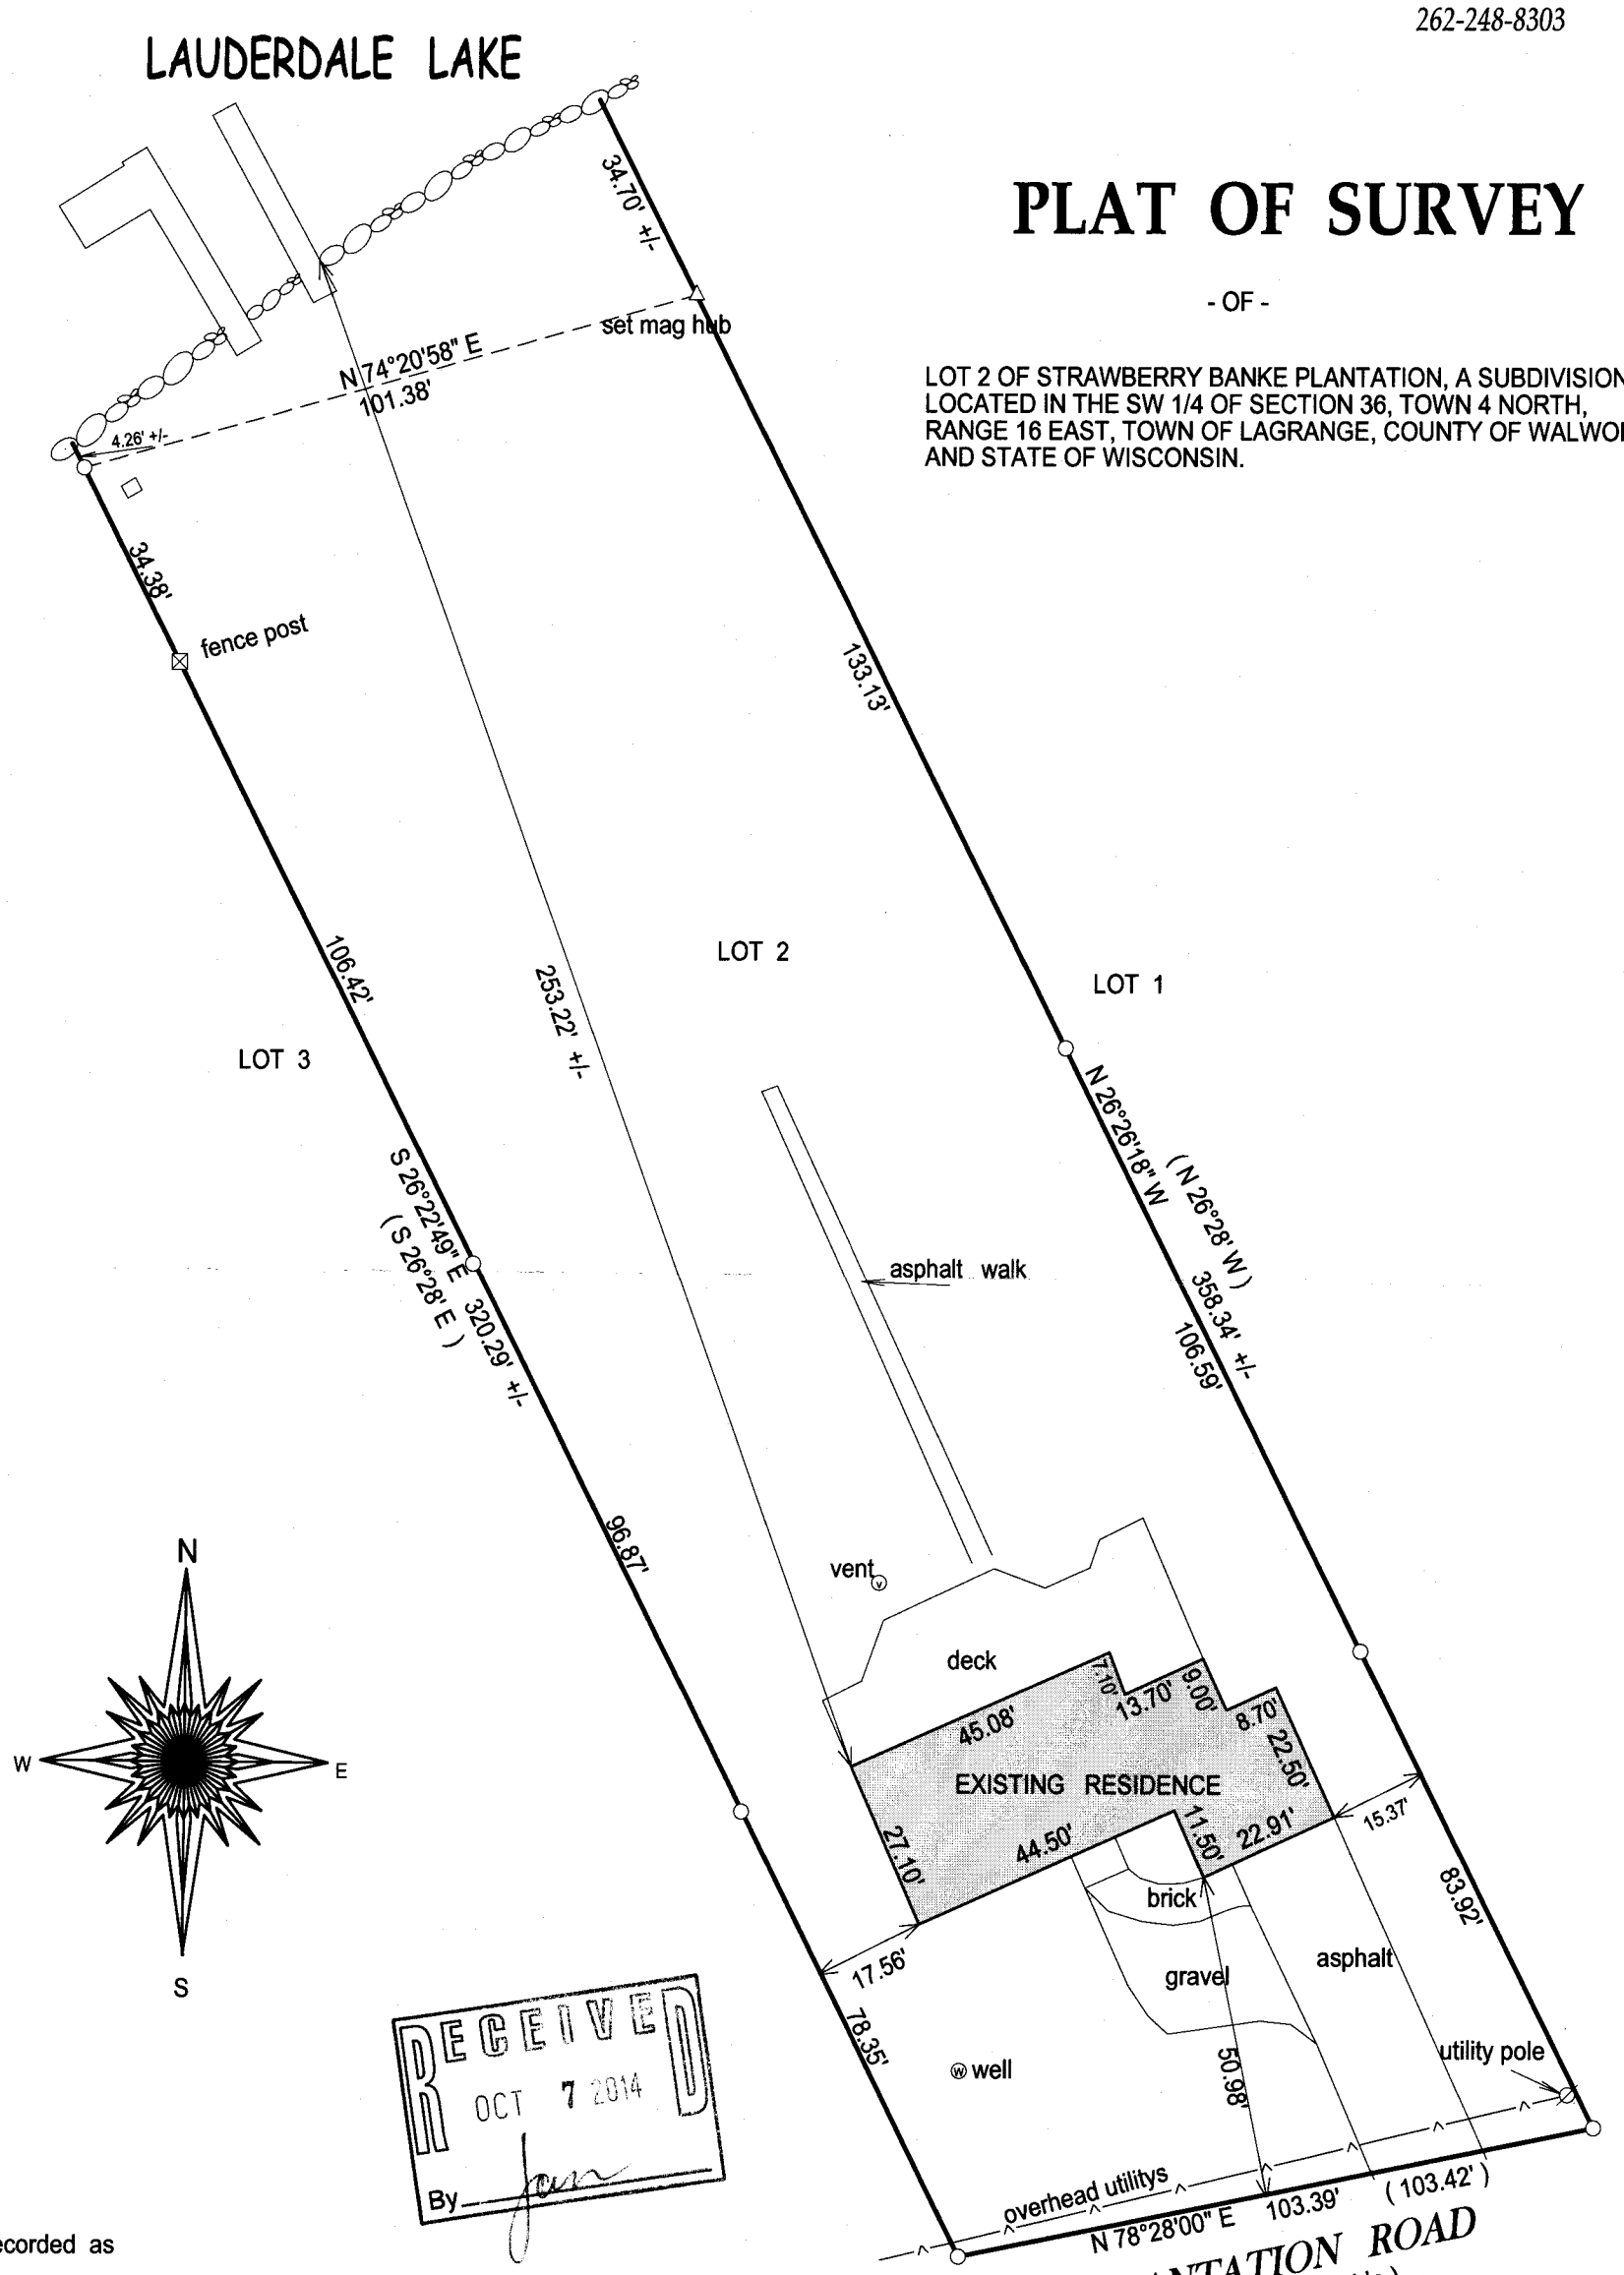

RECEIVED
OCT 7 2014
By

( )= recorded as
□ = found iron bar
○ = found iron pipe
● = set iron pipe
■ = set iron bar

SCALE 1" = 30'

JOB # 14-172

TAX ID #
HSP00002

30 0 30 60 90

BASIS OF BEARING OF THIS PLAT: THE NORTH LINE OF PLANTATION ROAD WAS ASSUMED TO BEAR N78°28' E AS RECORDED.

I hereby certify that I have surveyed the above- described property and the above map is a is a true representation thereof and shows the size and location of the property, its exterior boundaries, the location and dimensions of all structures thereon, fences, apparant easements and roadways and visible encroachments if any.

This survey is made for the present owners of the property, and those who purchase, mortgage, or guarantee the title thereto, within one year from the date hereof.

DATED THIS 31ST DAY OF JULY, 2014.

WISCONSIN
JEFFREY L. KIMPS S-2436 LAKE GENEVA. WIS.
LAND SURVEYOR

JEFFREY L KIMPS S - 2436
Wisconsin Registered Land Surveyor
(original if signed in red)

H8P-2 416-2731