

PREPARED FOR:  
TOM AJAMIAN  
AJAMIAN CONSTRUCTION, LLC  
PO BOX 1221  
LAKE GENEVA, WI 53147


SURVEY ADDRESS:  
5368 WEST SHORE DR.

# PLAT OF SURVEY

-OF-


LOT 10 AND THE NORTHERLY 20 FEET OF LOT 11, LONG POINT SUBDIVISION,  
LOCATED IN THE EAST 1/2 OF THE SOUTHEAST 1/4 OF SECTION 26, TOWN 4 NORTH,  
RANGE 16 EAST, TOWN OF LaGRANGE, WALWORTH COUNTY, WISCONSIN.

LYNCH & ASSOCIATES  
ENGINEERING CONSULTANTS, LLC.  
5482 S. WESTRIDGE DR.  
NEW BERLIN, WI 53151  
(262) 248-3697

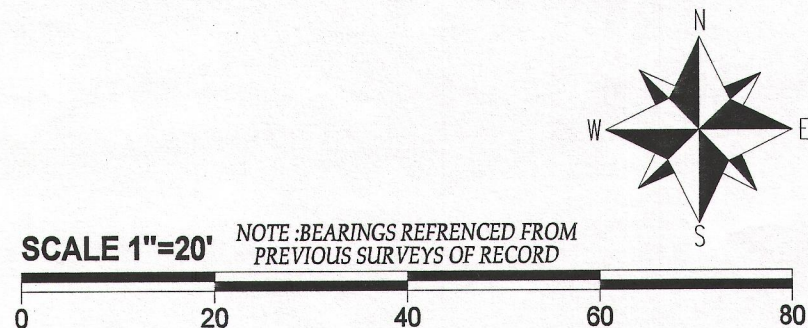

## LEGEND

- FOUND IRON PIPE
- FOUND IRON BAR
- ⊕ CONCRETE LID
- ⊙ VENT
- ⊗ WELL
- ⊗ UTILITY POLE
- E— OVERHEAD WIRES
- (xx) RECORDED AS

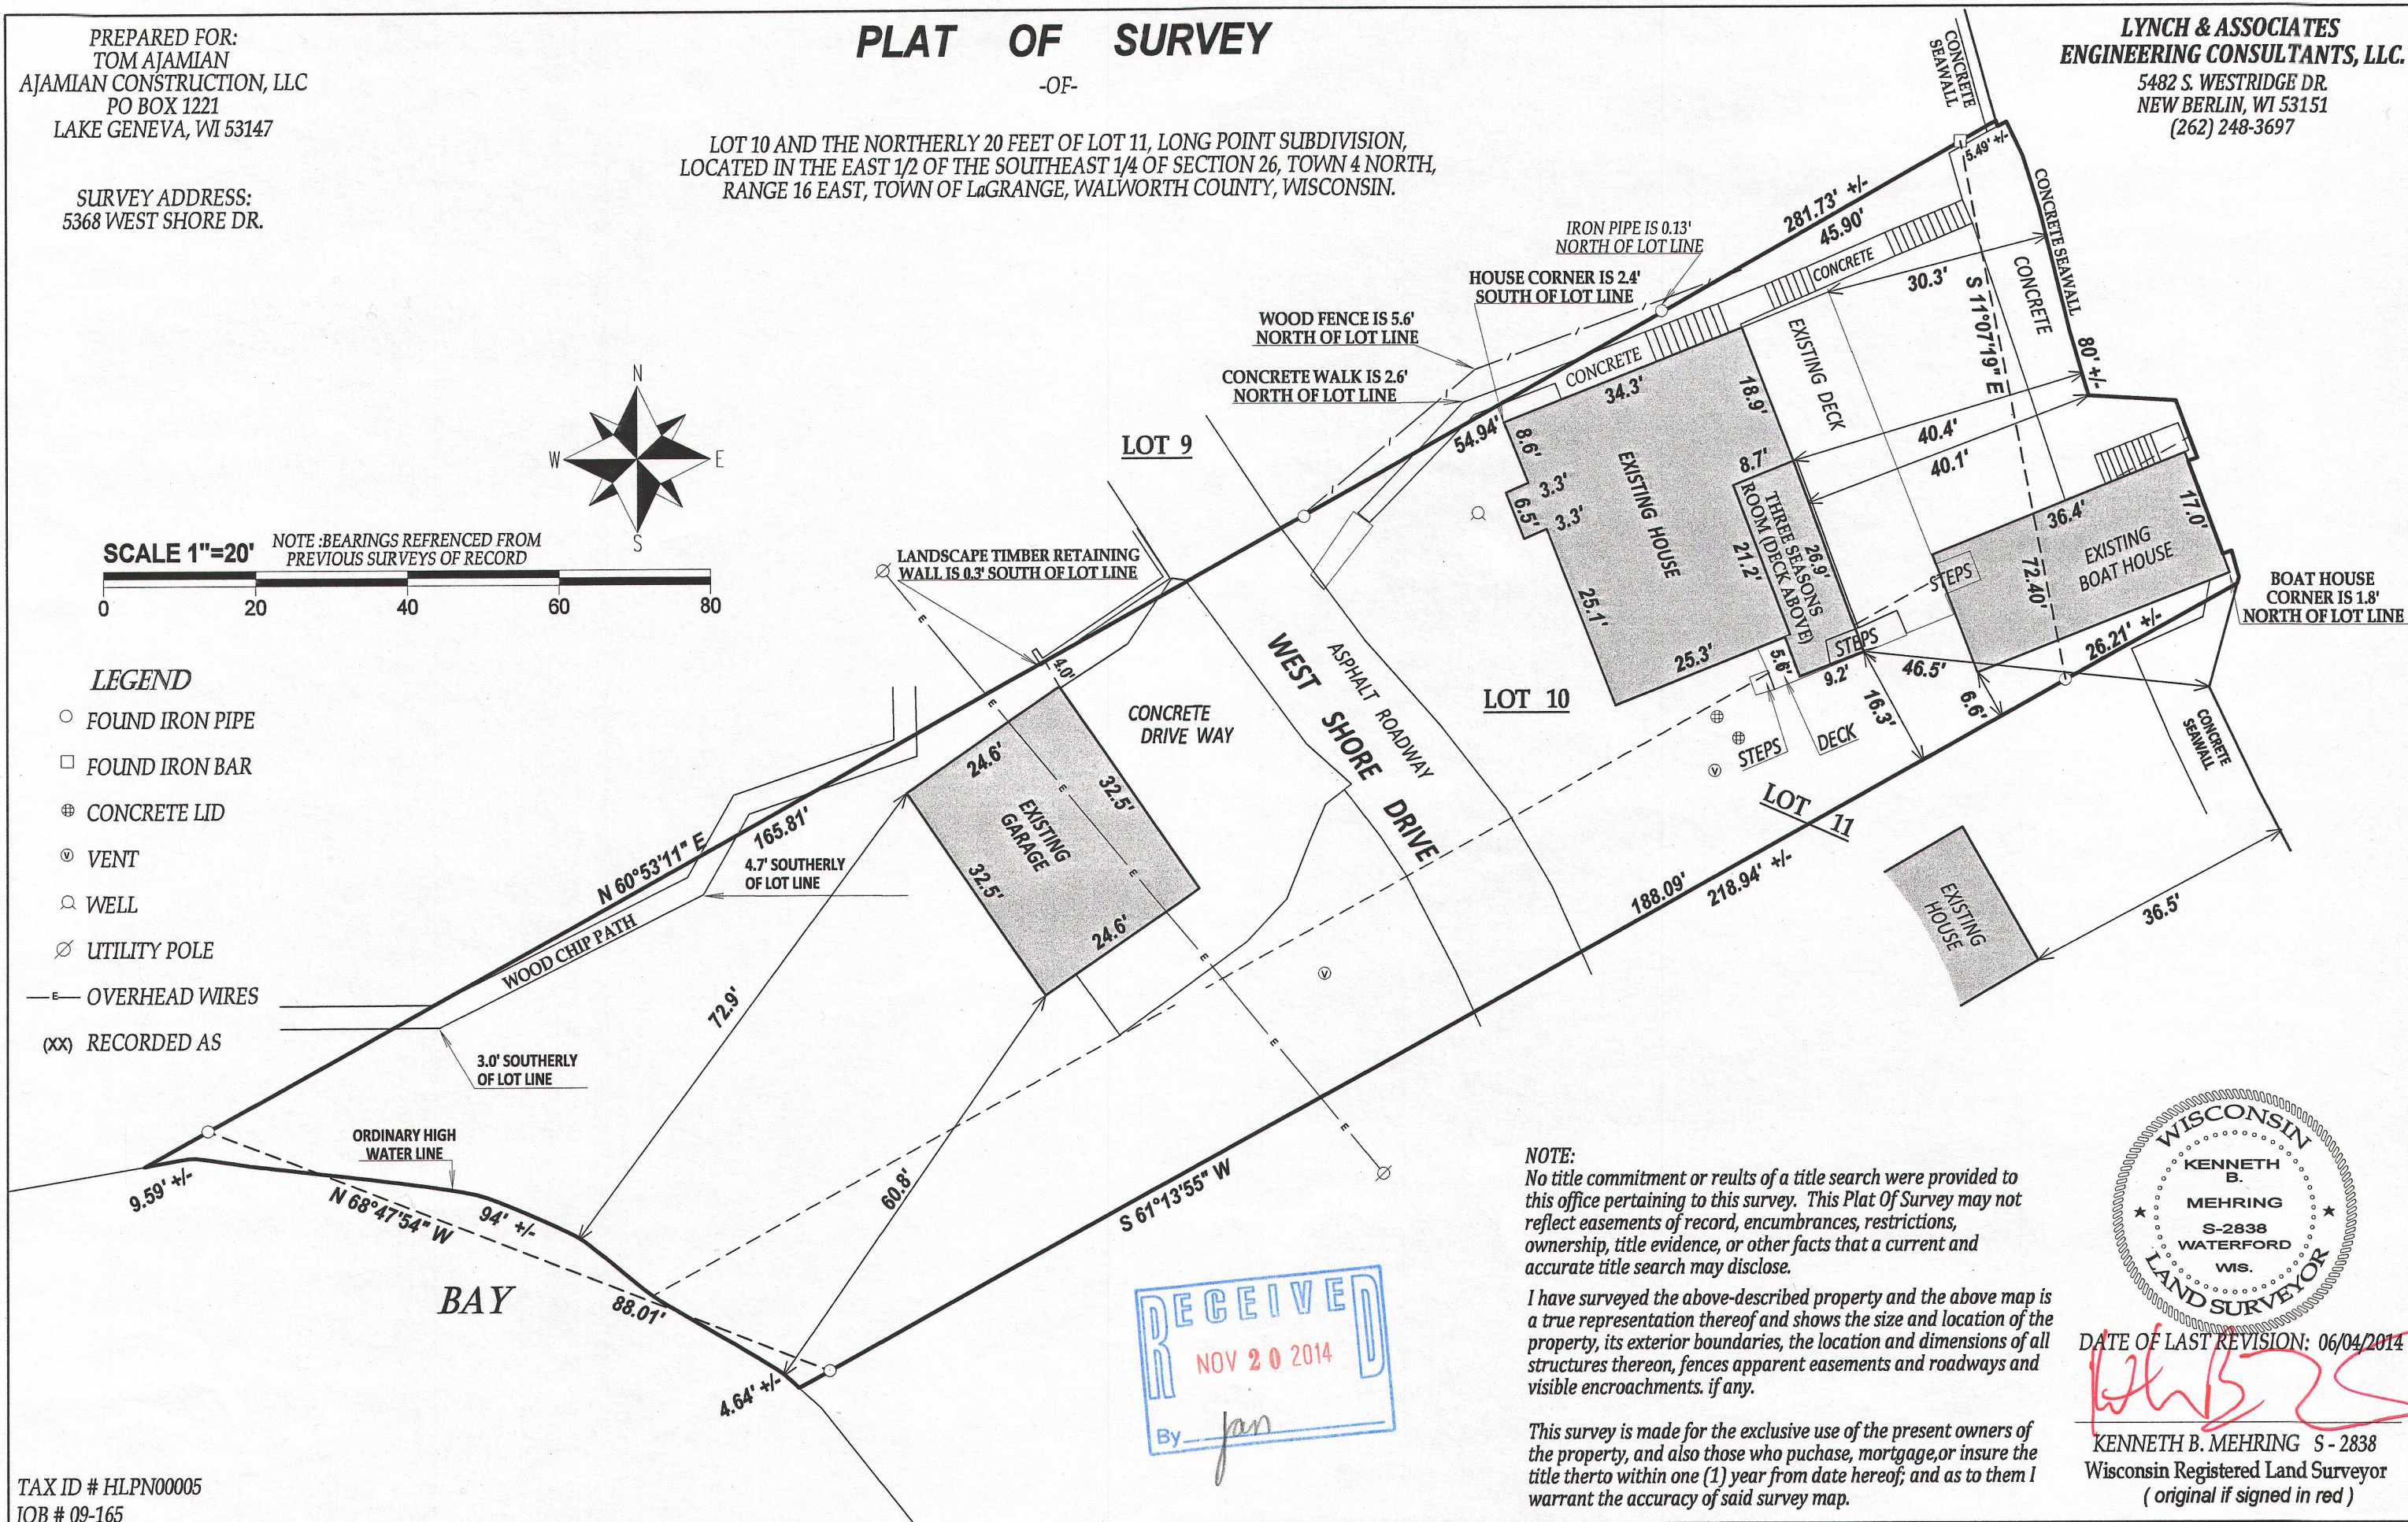

TAX ID # HLPN00005  
JOB # 09-165

HLPN-S

416-2735