
PLAT OF SURVEY
SITE, GRADING, DRAINAGE & EROSION CONTROL PLAN

LOT 3 OF CERTIFIED SURVEY MAP NO. 420
RECORDED AS DOC. 684354
LOCATED IN THE SE 1/4 OF THE SE 1/4 SECTION 35
TOWN 4 NORTH, RANGE 16 EAST
WALWORTH COUNTY, WISCONSIN

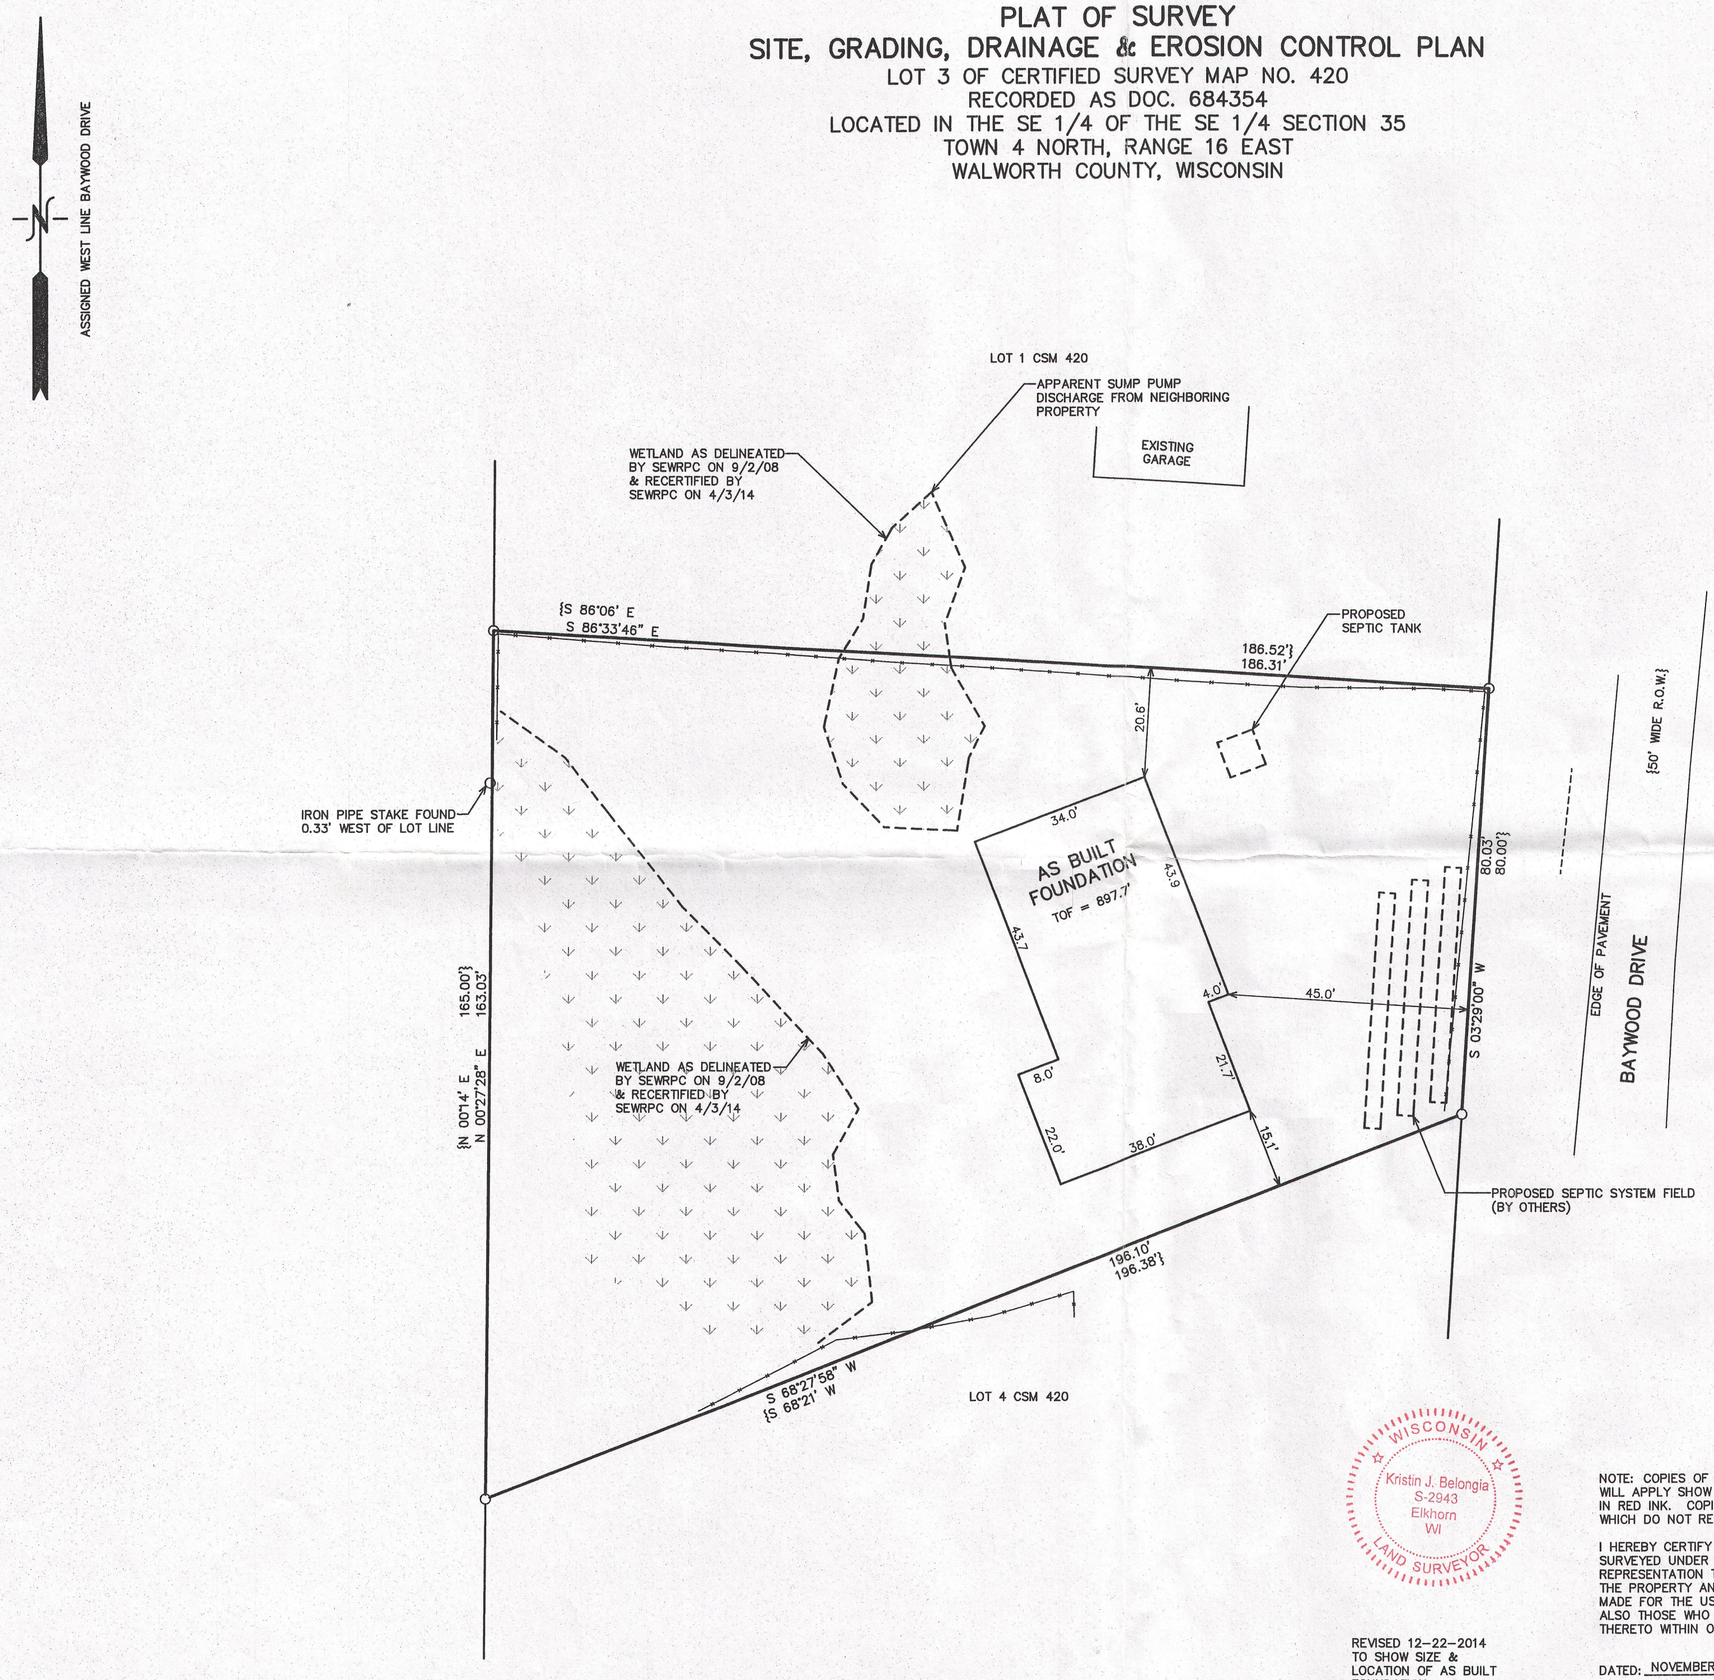

LEGEND
O = FOUND IRON PIPE STAKE
(XXX) = RECORDED AS

RECEIVED
JAN 6 2015
By jan

WISCONSIN
Kristin J. Belongia
S-2943
Elkhorn
WI
LAND SURVEYOR

NOTE: COPIES OF THIS MAP TO WHICH THE FOLLOWING CERTIFICATE WILL APPLY SHOW THE SURVEYOR'S ORIGINAL SEAL AND SIGNATURE IN RED INK. COPIES BY ANY OTHER MEANS MAY HAVE ALTERATIONS WHICH DO NOT REPRESENT THE SURVEYOR'S WORK PRODUCT.

I HEREBY CERTIFY THAT THE ABOVE DESCRIBED PROPERTY HAS BEEN SURVEYED UNDER MY DIRECTION AND THAT THE ABOVE MAP IS A TRUE REPRESENTATION THEREOF AND SHOWS THE SIZE AND LOCATION OF THE PROPERTY AND ITS EXTERIOR BOUNDARIES. THIS SURVEY IS MADE FOR THE USE OF THE PRESENT OWNERS OF THE PROPERTY, AND ALSO THOSE WHO PURCHASE, MORTGAGE, OR GUARANTEE THE TITLE THERETO WITHIN ONE YEAR FROM THE DATE HEREOF.

DATED: NOVEMBER 12, 2013

Kristin Belongia

KRISTIN J. BELONGIA R.L.S. 2943

REVISED 12-22-2014
TO SHOW SIZE & LOCATION OF AS BUILT FOUNDATION

REVISED 04-28--2014
TO SHOW PROPOSED RESIDENCE

REVISED 5/2/2014-KB
ADJUST NOTES

REVISED 5/6/2014-KB
SITE, GRADING, DRAINAGE & EROSION CONTROL PLAN

NEUBAUER PROPERTY

WORK ORDERED BY:
JEFF CZARAPATA
W5154 STEWART DRIVE
ELKHORN, WI. 53121

FARRIS, HANSEN & ASSOCIATES, INC.
ENGINEERING - ARCHITECTURE - SURVEYING
7 RIDGWAY COURT P.O. BOX 437
ELKHORN, WISCONSIN 53121
OFFICE: (262) 723-2098 FAX: (262) 723-5886

REVISIONS

PROJECT NO. 8901
DATE: 4/25/2014
SHEET NO. 1 OF 1

12/22/2014 X:\Projects\8901\Dcad\ASBUILT

DEC 22 2014

HA 420-3 416-2746