


PLAT OF SURVEY



LOTS 6 AND 6A OF ARROWHEAD PARK A SUBDIVISION
LOCATED IN THE NW 1/4 OF THE SW 1/4 SECTION 35
TOWN 4 NORTH, RANGE 16 EAST
WALWORTH COUNTY, WISCONSIN

Lots 6 and 6A, in Arrowhead Park, a subdivision located in Government Lot 3 in the Northwest 1/4 of the Southeast 1/4 of Section 35, T4N, R16E, Town of LaGrange, Walworth County, Wisconsin, as per the plat thereof dated July 20, 1954 and recorded August 9, 1954 as Document No. 463678.

Tax Key No: HAP 00007

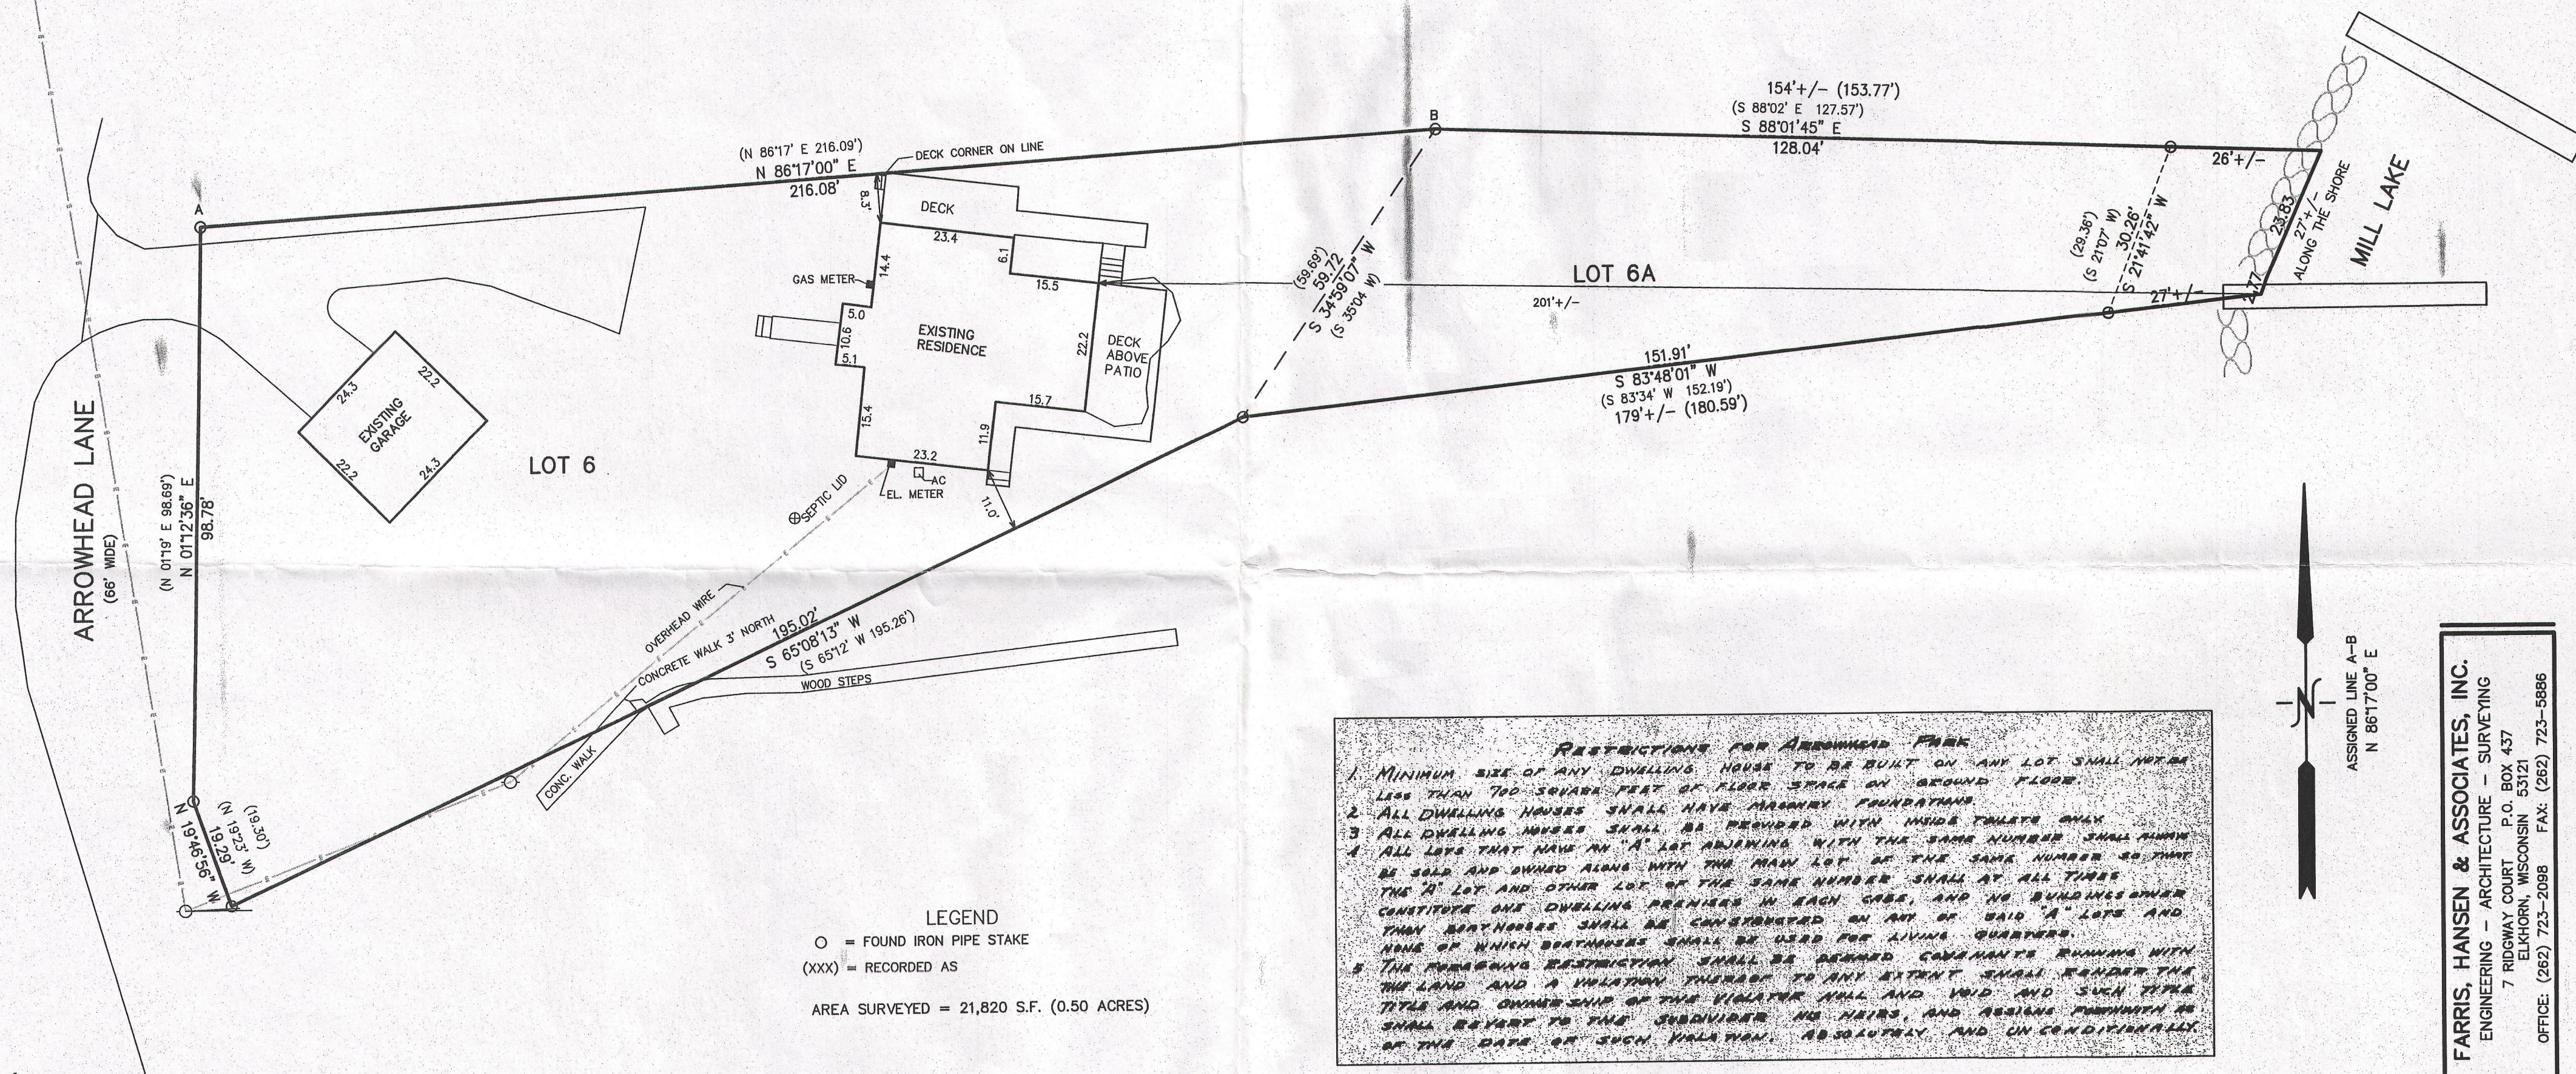

WORK ORDERED FOR:
JAMES & NANETTE DOUBLER
BY:
LAW OFFICE OF FRANK HOWARD
700 BUSSE HIGHWAY
PARK RIDGE, IL. 60068

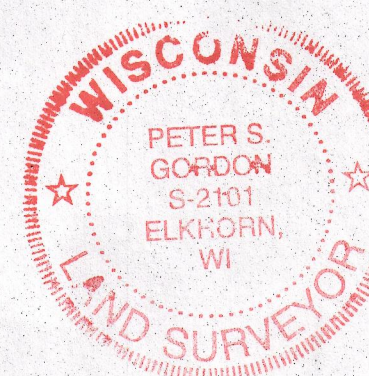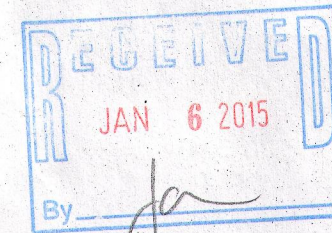


NOTE: COPIES OF THIS MAP TO WHICH THE FOLLOWING CERTIFICATE WILL APPLY SHOW THE SURVEYOR'S ORIGINAL SEAL AND SIGNATURE IN RED INK. COPIES BY ANY OTHER MEANS MAY HAVE ALTERATIONS WHICH DO NOT REPRESENT THE SURVEYOR'S WORK PRODUCT.

I HEREBY CERTIFY THAT THE ABOVE DESCRIBED PROPERTY HAS BEEN SURVEYED UNDER MY DIRECTION AND THAT THE ABOVE MAP IS A TRUE REPRESENTATION THEREOF AND SHOWS THE SIZE AND LOCATION OF THE PROPERTY, ITS EXTERIOR BOUNDARIES, THE LOCATION OF ALL VISIBLE STRUCTURES, AND DIMENSIONS OF ALL PRINCIPLE BUILDINGS THEREON, BOUNDARY FENCES, APPARENT EASEMENTS, ROADWAYS, AND VISIBLE ENCROACHMENTS, IF ANY. THIS SURVEY IS MADE FOR THE USE OF THE PRESENT OWNERS OF THE PROPERTY, AND ALSO THOSE WHO PURCHASE, MORTGAGE, OR GUARANTEE THE TITLE THERETO WITHIN ONE YEAR FROM THE DATE HEREOF.

DATED: NOVEMBER 11, 2014

Peter S. Gordon
PETER S. GORDON

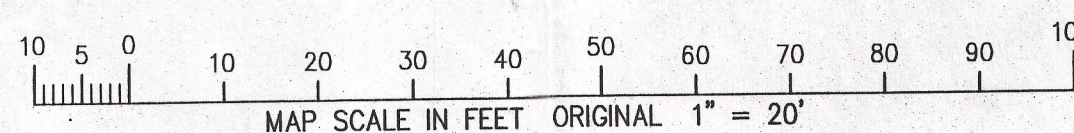

FARRIS, HANSEN & ASSOCIATES, INC.
ENGINEERING - ARCHITECTURE - SURVEYING
7 RIDGWAY COURT P.O. BOX 437
ELKHORN, WISCONSIN 53121
OFFICE: (262) 723-2098 FAX: (262) 723-5886

REVISIONS

PROJECT NO.
9183
DATE:
11-11-2014
SHEET NO.
1 OF 1

NOV 11 2014

11/11/2014 X:\Projects\9183\DCAD\SURVEY

HAP-7 416-2751