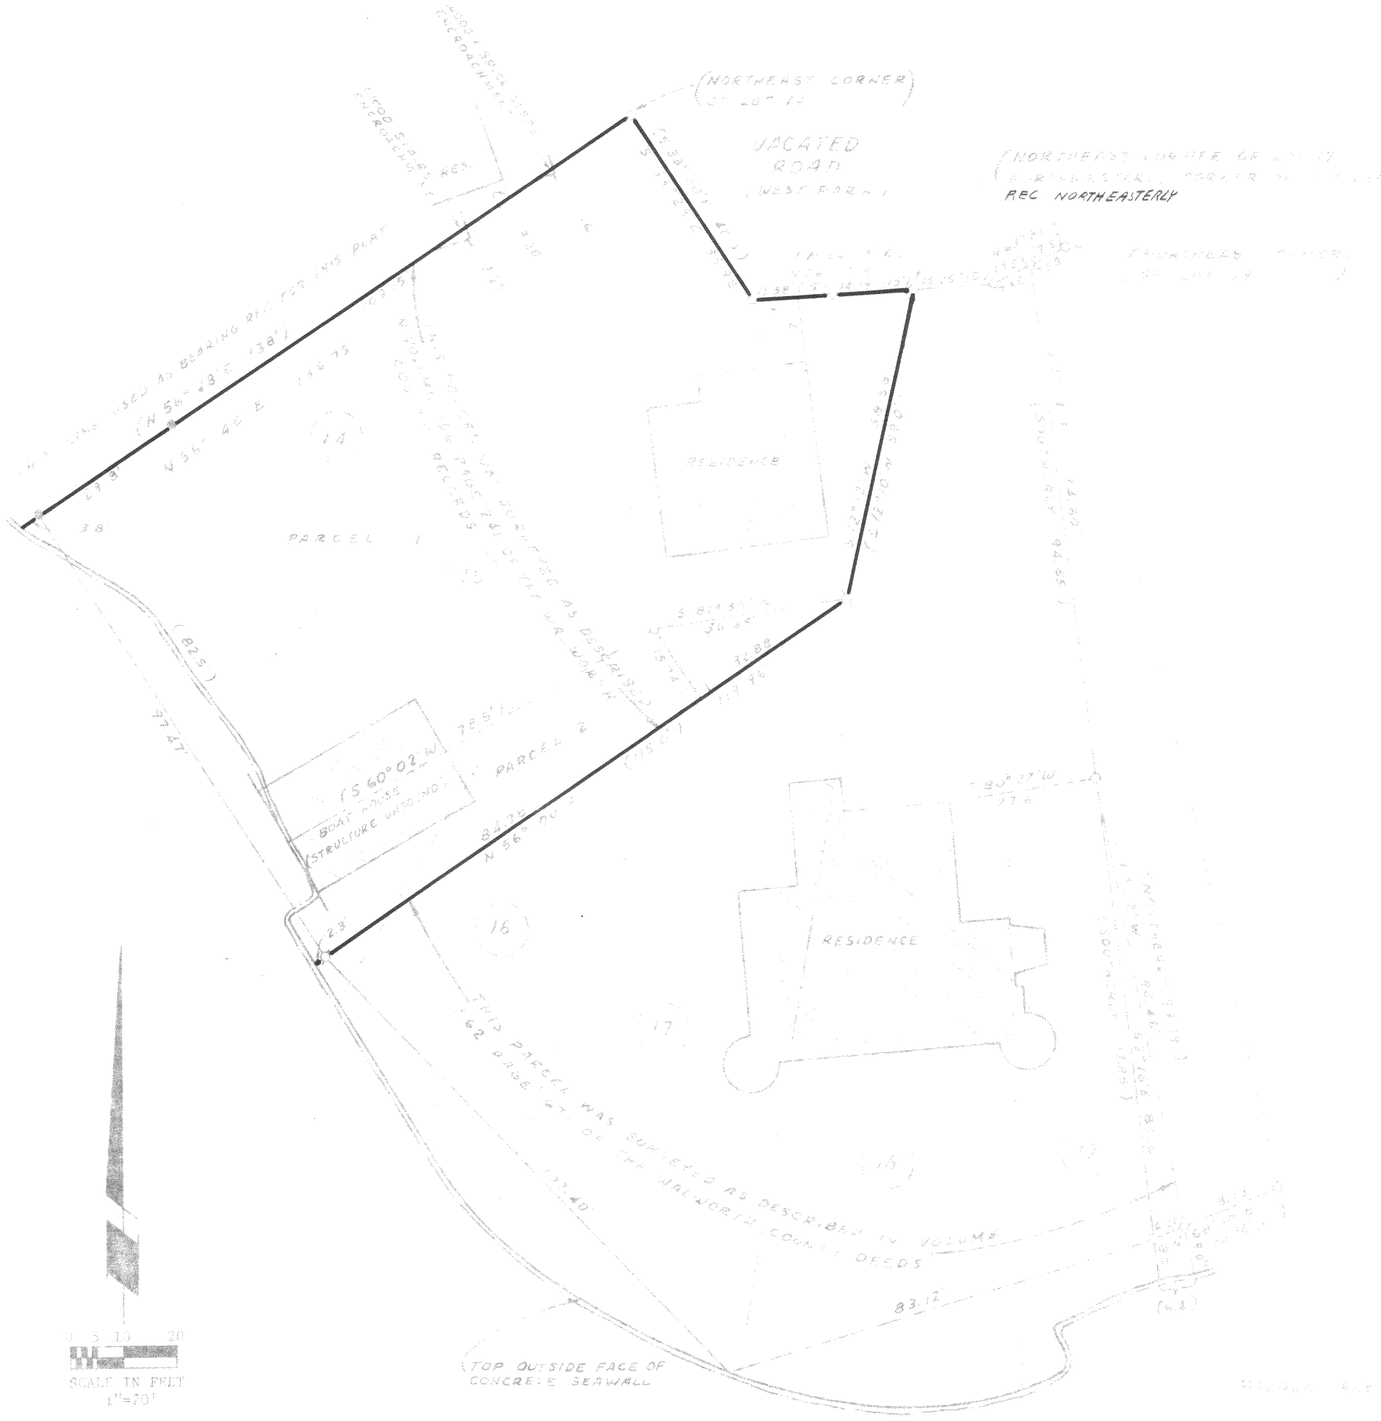


Volume 156 Page 241 of Walworth County Records

Lots 14, 15, and part of 16 and 17 of Green Island Subdivision being a subdivision located in section 26,Town 4 North, Range 16 East, Walworth County, Wisconsin more particularly described as follows, to-wit:

Parcel 1

Commencing at an iron stake at the Northeast corner of Lot 14; thence S 33°50' E 40.0 feet along the Easterly lines of Lots 14 and 15 to an iron stake; thence N 86° 15' E 30.0 feet along the Easterly lines of lots 16 and 17 to an iron stake being the Northwesterly corner of Lot 18 of said Green Island Subdivision; thence S 12° 10' W 59.0 feet to an iron stake; thence S 81°35' W 36.45 feet to an iron stake; thence S 60°02' W 78.5 feet along a line which divides the boat house now located on Lot 15 of said Green Island Subdivision into equal halves, to a point on the shore of the channel which lies between Green Lake and Middle Lake; thence Northwesterly along the shore of said channel 82.5 feet to an intersection with the Northerly line of said Lot 14; thence N 56° 48' E along the Northerly line of said Lot 14, 138 feet to the point of beginning.

Parcel 2

Commencing at an iron stake that is 59.0 feet S 12° 10' W of the Northeast corner of Lot 17 of said Green Island Subdivision; thence S 81°35' W 36.45 feet to an iron stake; thence S 60°02' W 78.5 feet to the shore of the channel between Green Lake and Middle Lake; thence Southeasterly along the shore of said channel to a point that is 115.0 feet S 56°00' W of the point of beginning; thence N 56°00' E to the point of beginning.

WORK ORDERED BY: DR. VALDEMARS JEKKALS

WISCONSIN
ROBERT A. FARRIS
S-1293
ELKHORN, WIS.
LAND SURVEYOR

Robert A. Farris

1537

H GT - 4A

416-287F