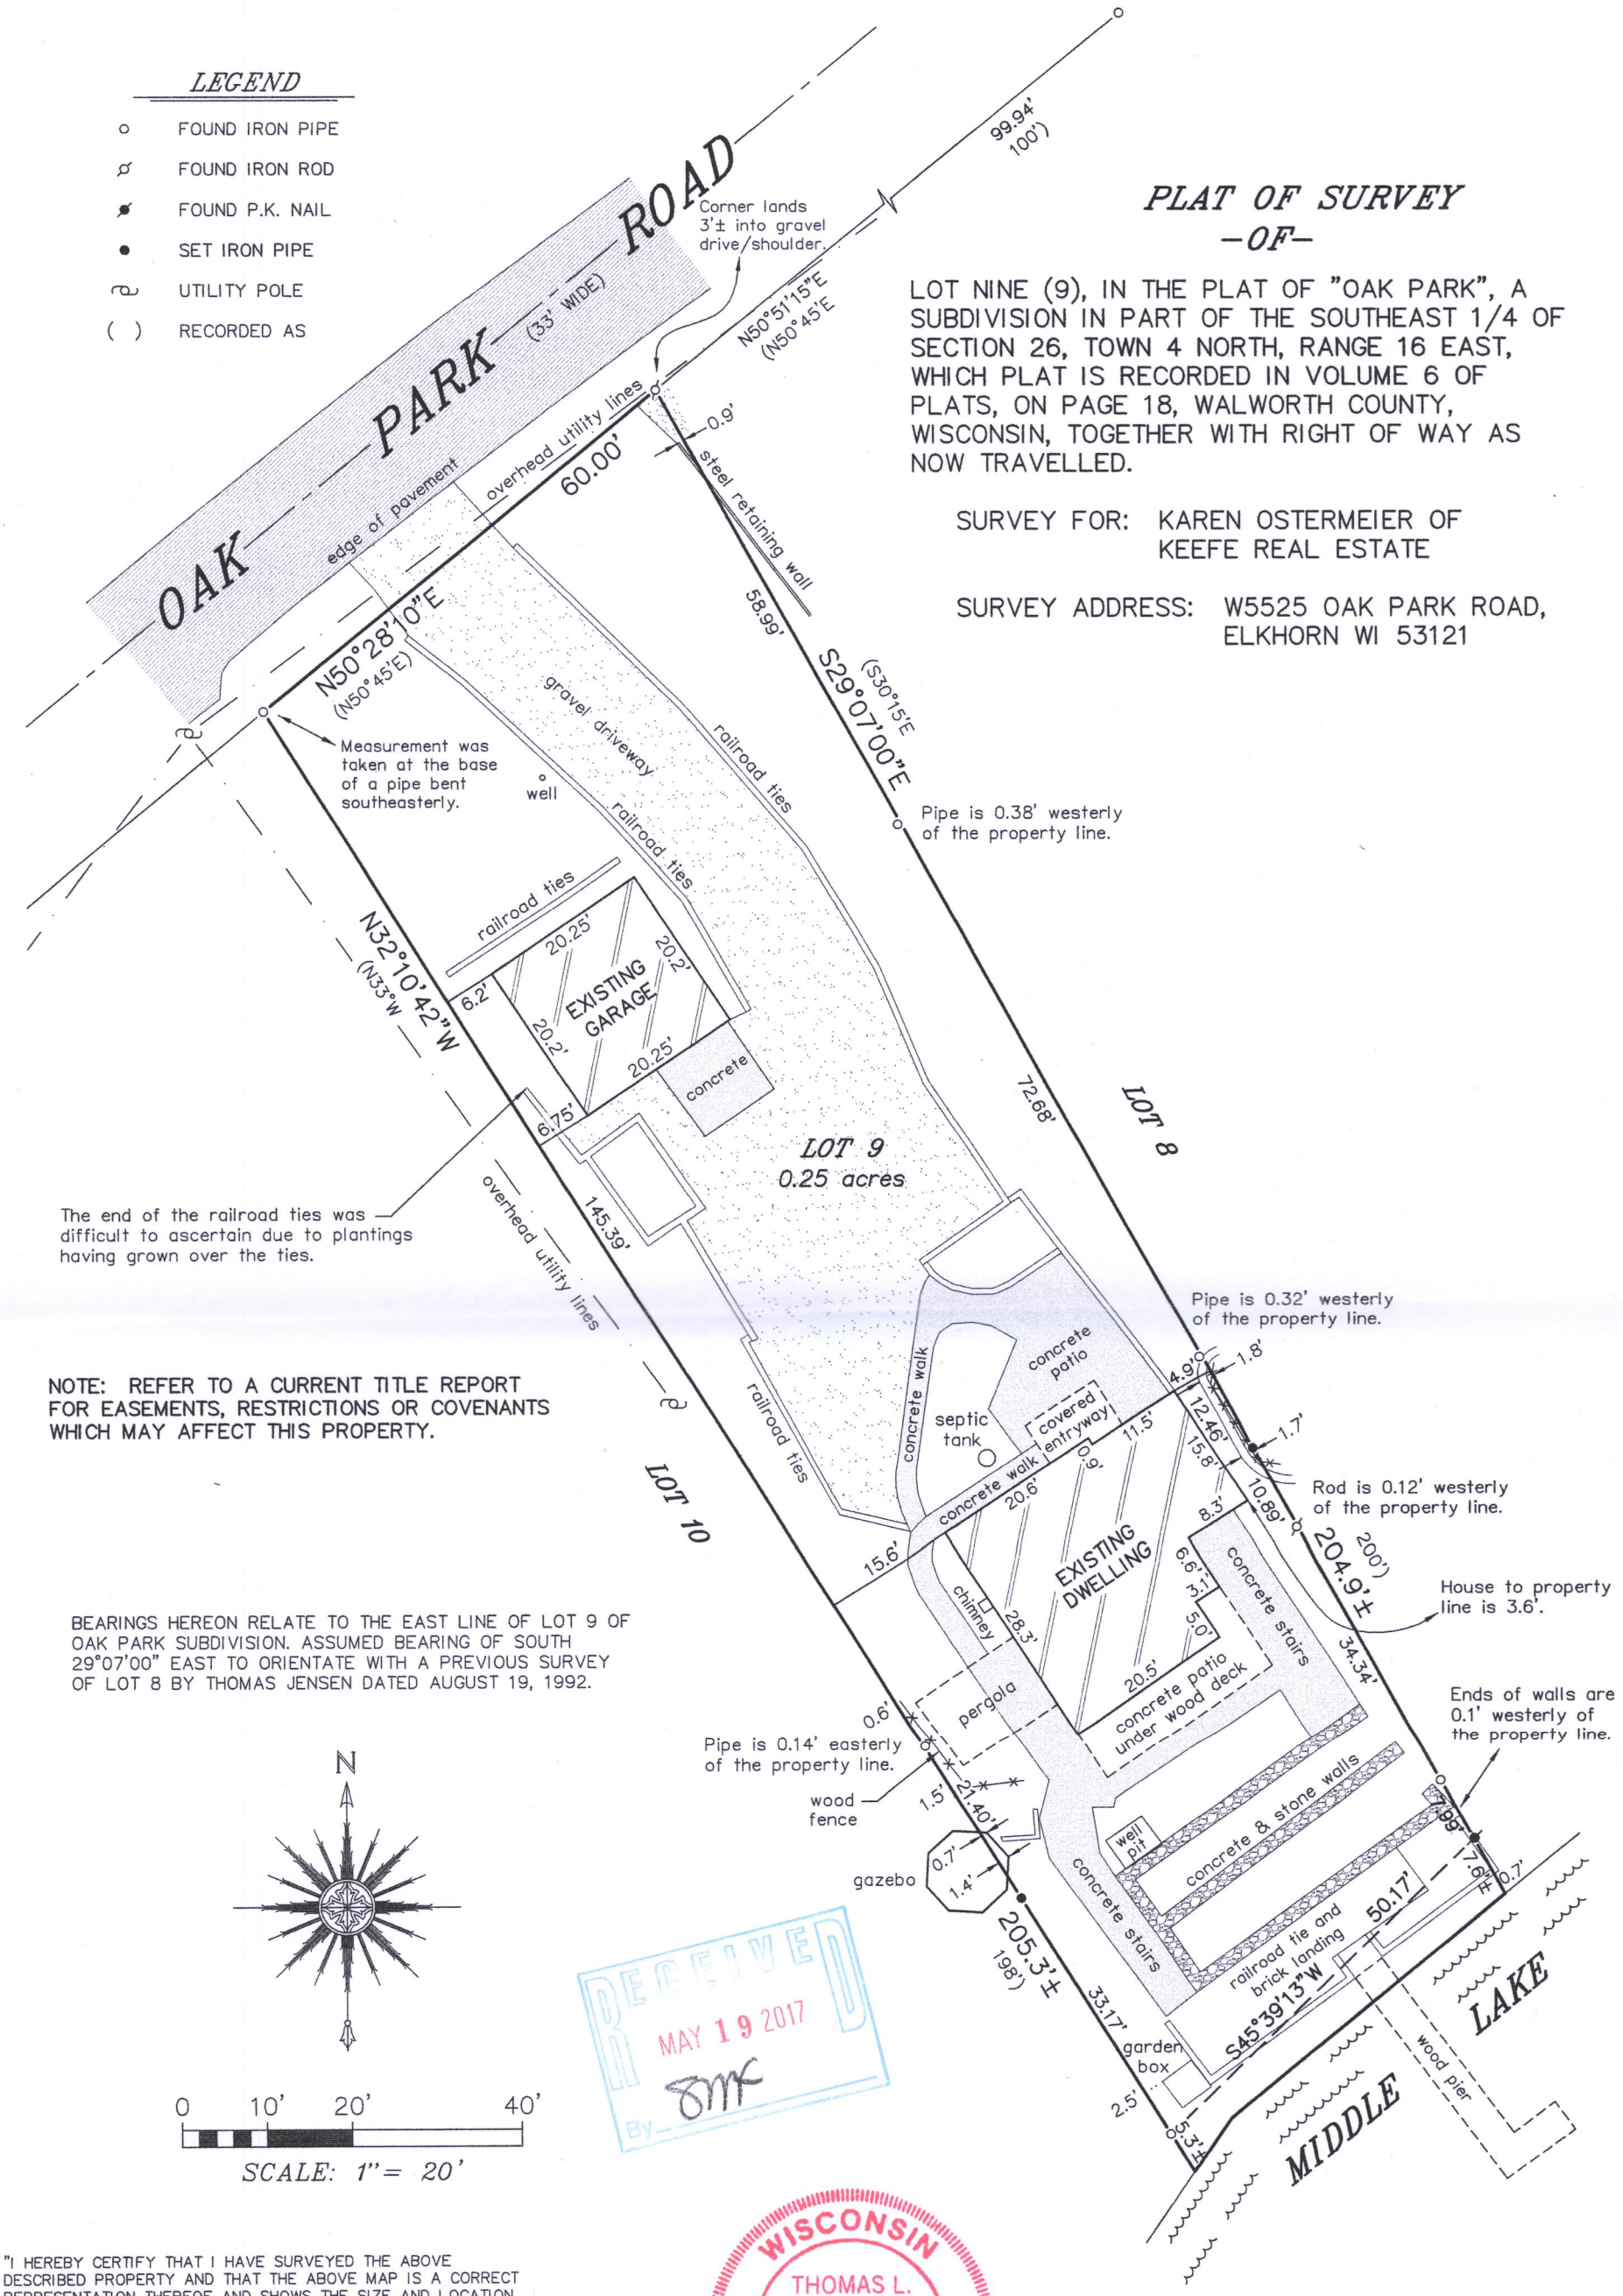


PLAT OF SURVEY
-OF-

LOT NINE (9), IN THE PLAT OF "OAK PARK", A SUBDIVISION IN PART OF THE SOUTHEAST 1/4 OF SECTION 26, TOWN 4 NORTH, RANGE 16 EAST, WHICH PLAT IS RECORDED IN VOLUME 6 OF PLATS, ON PAGE 18, WALWORTH COUNTY, WISCONSIN, TOGETHER WITH RIGHT OF WAY AS NOW TRAVELLED.

SURVEY FOR: KAREN OSTERMEIER OF KEEFE REAL ESTATE

SURVEY ADDRESS: W5525 OAK PARK ROAD, ELKHORN WI 53121

RECEIVED
MAY 19 2017
By

"I HEREBY CERTIFY THAT I HAVE SURVEYED THE ABOVE DESCRIBED PROPERTY AND THAT THE ABOVE MAP IS A CORRECT REPRESENTATION THEREOF AND SHOWS THE SIZE AND LOCATION OF THE PROPERTY, ITS EXTERIOR BOUNDARIES, THE LOCATION OF ALL VISIBLE STRUCTURES AND DIMENSIONS OF ALL PRINCIPAL BUILDINGS THEREON, BOUNDARY FENCES, APPARENT EASEMENTS, ROADWAYS AND ENCROACHMENTS, IF ANY."

"THIS SURVEY IS MADE FOR THE USE OF THE PRESENT OWNERS OF THE PROPERTY, AND THOSE WHO PURCHASE, MORTGAGE, OR GUARANTEE THE TITLE THERETO WITHIN ONE YEAR FROM DATE HEREOF."

WISCONSIN
THOMAS L. SATTER
S-2850
BURLINGTON, WI
LAND SURVEYOR

Thomas L. Satter
THOMAS L. SATTER S-2850

SATTER SURVEYING, LLC
LAND SURVEYS, MAPPING AND PLANNING
272 ORIGEN STREET
BURLINGTON, WI 53105
262-661-4239

THIS IS NOT AN ORIGINAL PRINT UNLESS THIS SEAL IS RED.

REVISED: 4/26/17
JULY 22, 2016 — DATE
071609 — JOB NUMBER

HOR-7

416-2915