

PLAT OF SURVEY WITH TOPOGRAPHY LOT 3 OF STRAWBERRY BANKE PLANTATION

LOCATED IN PART OF THE SW 1/4
OF SECTION 36, TOWN 4 NORTH, RANGE 16 EAST,
TOWN OF LAGRANGE, WALWORTH COUNTY, WISCONSIN





W5124 PLANTATION ROAD
ELKHORN, WI 53121

WORK ORDERED BY -
ALAN & KAREN ZAMIN
151 W. WING STREET
ARLINGTON HEIGHTS, IL 60005

FARRIS, HANSEN & ASSOCIATES, INC.
ENGINEERING - ARCHITECTURE - SURVEYING
7 RIDGWAY COURT P.O. BOX 437
ELKHORN, WISCONSIN 53121
OFFICE: (262) 723-2098 FAX: (262) 723-5886

REVISIONS
12/05/2017 - LB
TOPO SURVEY

PROJECT NO.
9879
DATE:
12/05/2017
SHEET NO.
1 OF 1

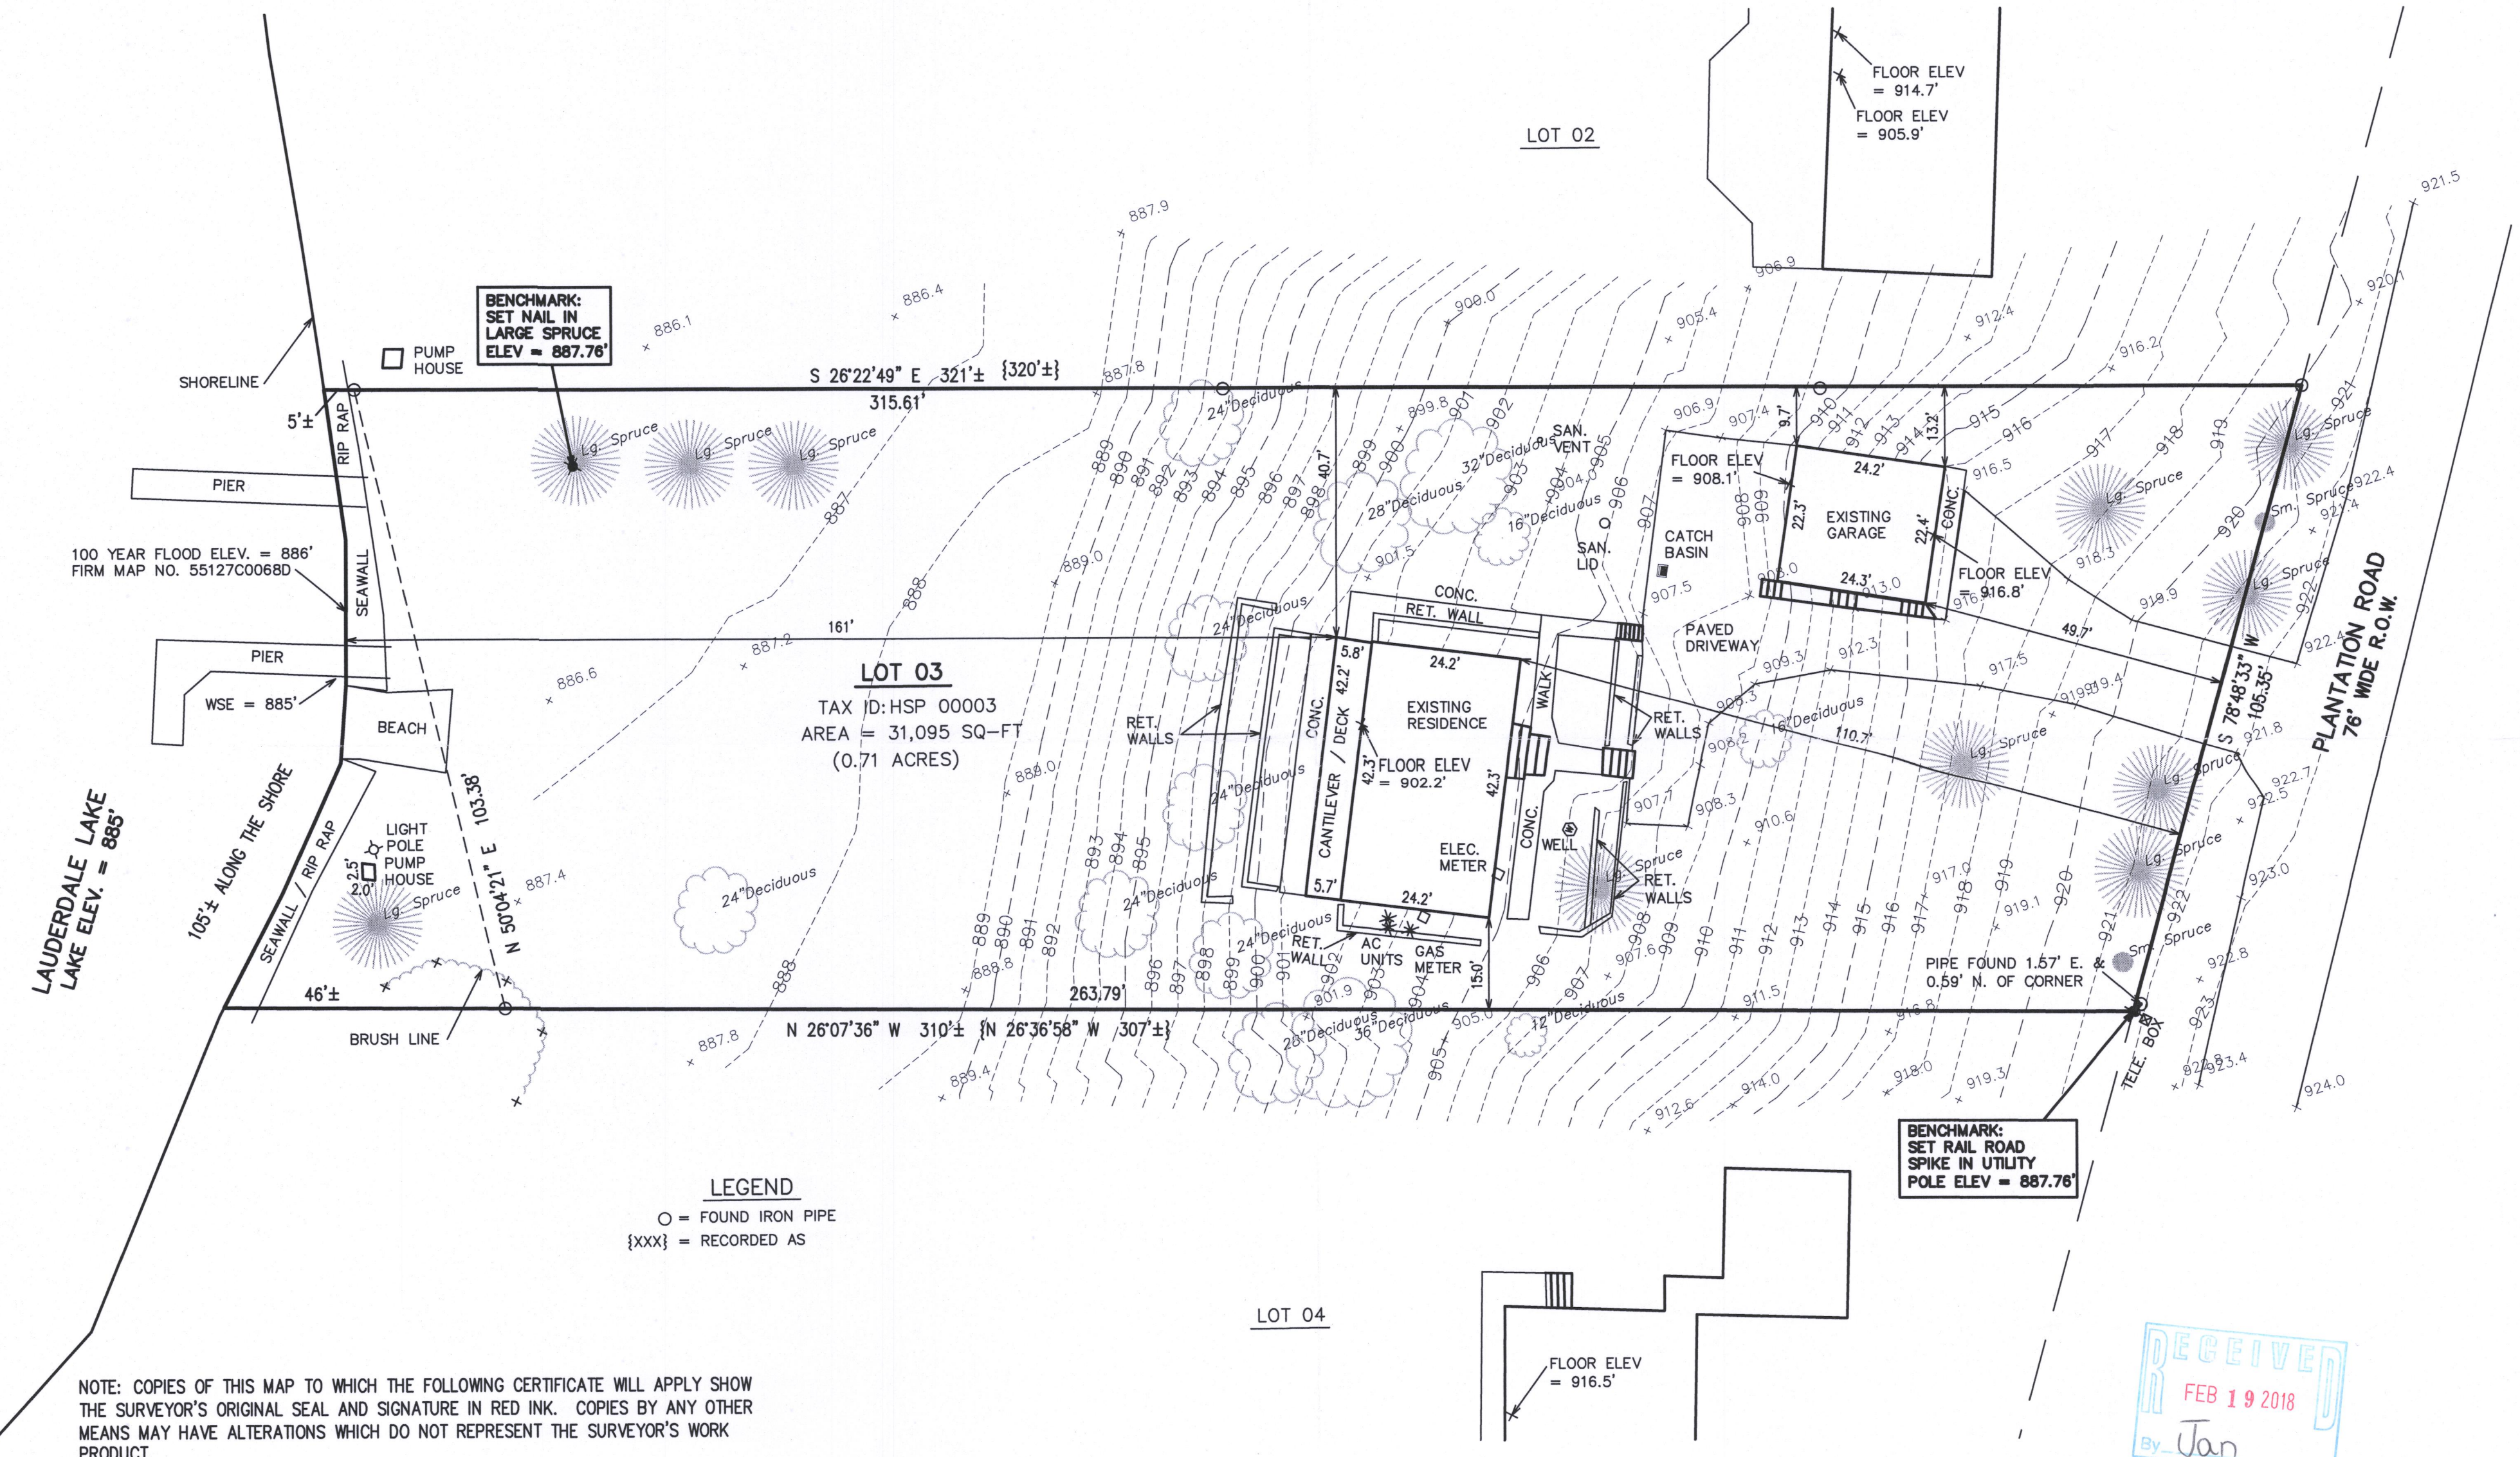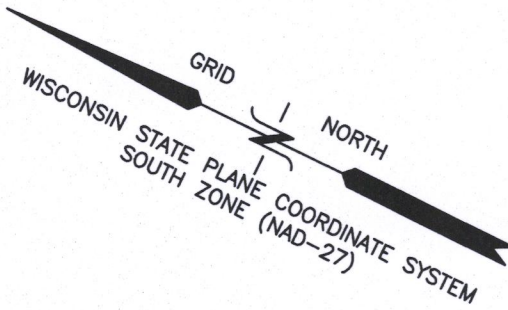

LEGEND


○ = FOUND IRON PIPE
{XXX} = RECORDED AS

NOTE: COPIES OF THIS MAP TO WHICH THE FOLLOWING CERTIFICATE WILL APPLY SHOW THE SURVEYOR'S ORIGINAL SEAL AND SIGNATURE IN RED INK. COPIES BY ANY OTHER MEANS MAY HAVE ALTERATIONS WHICH DO NOT REPRESENT THE SURVEYOR'S WORK PRODUCT.

I HEREBY CERTIFY THAT THE ABOVE DESCRIBED PROPERTY HAS BEEN SURVEYED UNDER MY DIRECTION AND THAT THE ABOVE MAP IS A TRUE REPRESENTATION THEREOF AND SHOWS THE SIZE AND LOCATION OF THE PROPERTY AND ITS EXTERIOR BOUNDARIES. THIS SURVEY IS MADE FOR THE USE OF THE PRESENT OWNERS OF THE PROPERTY, AND ALSO THOSE WHO PURCHASE, MORTGAGE, OR GUARANTEE THE TITLE THERETO WITHIN ONE YEAR FROM THE DATE HEREOF.

DATED: 12/05/2017

BRIAN M. CARLSON P.L.S. 2039

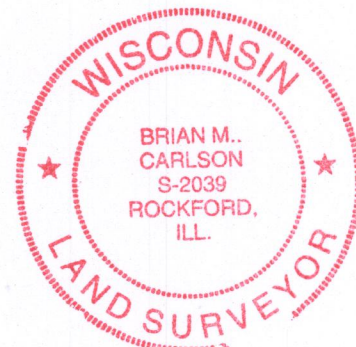

20 10 0 20 40 60 80
MAP SCALE IN FEET - ORIGINAL 1"=20'

HSP-3 416-2976