
**Farris, Hansen & Associates, Inc.**
Engineering, Surveying & Land Planning
P.O. BOX 487
715 W. WALWORTH STREET
ELKHORN, WISCONSIN 53121

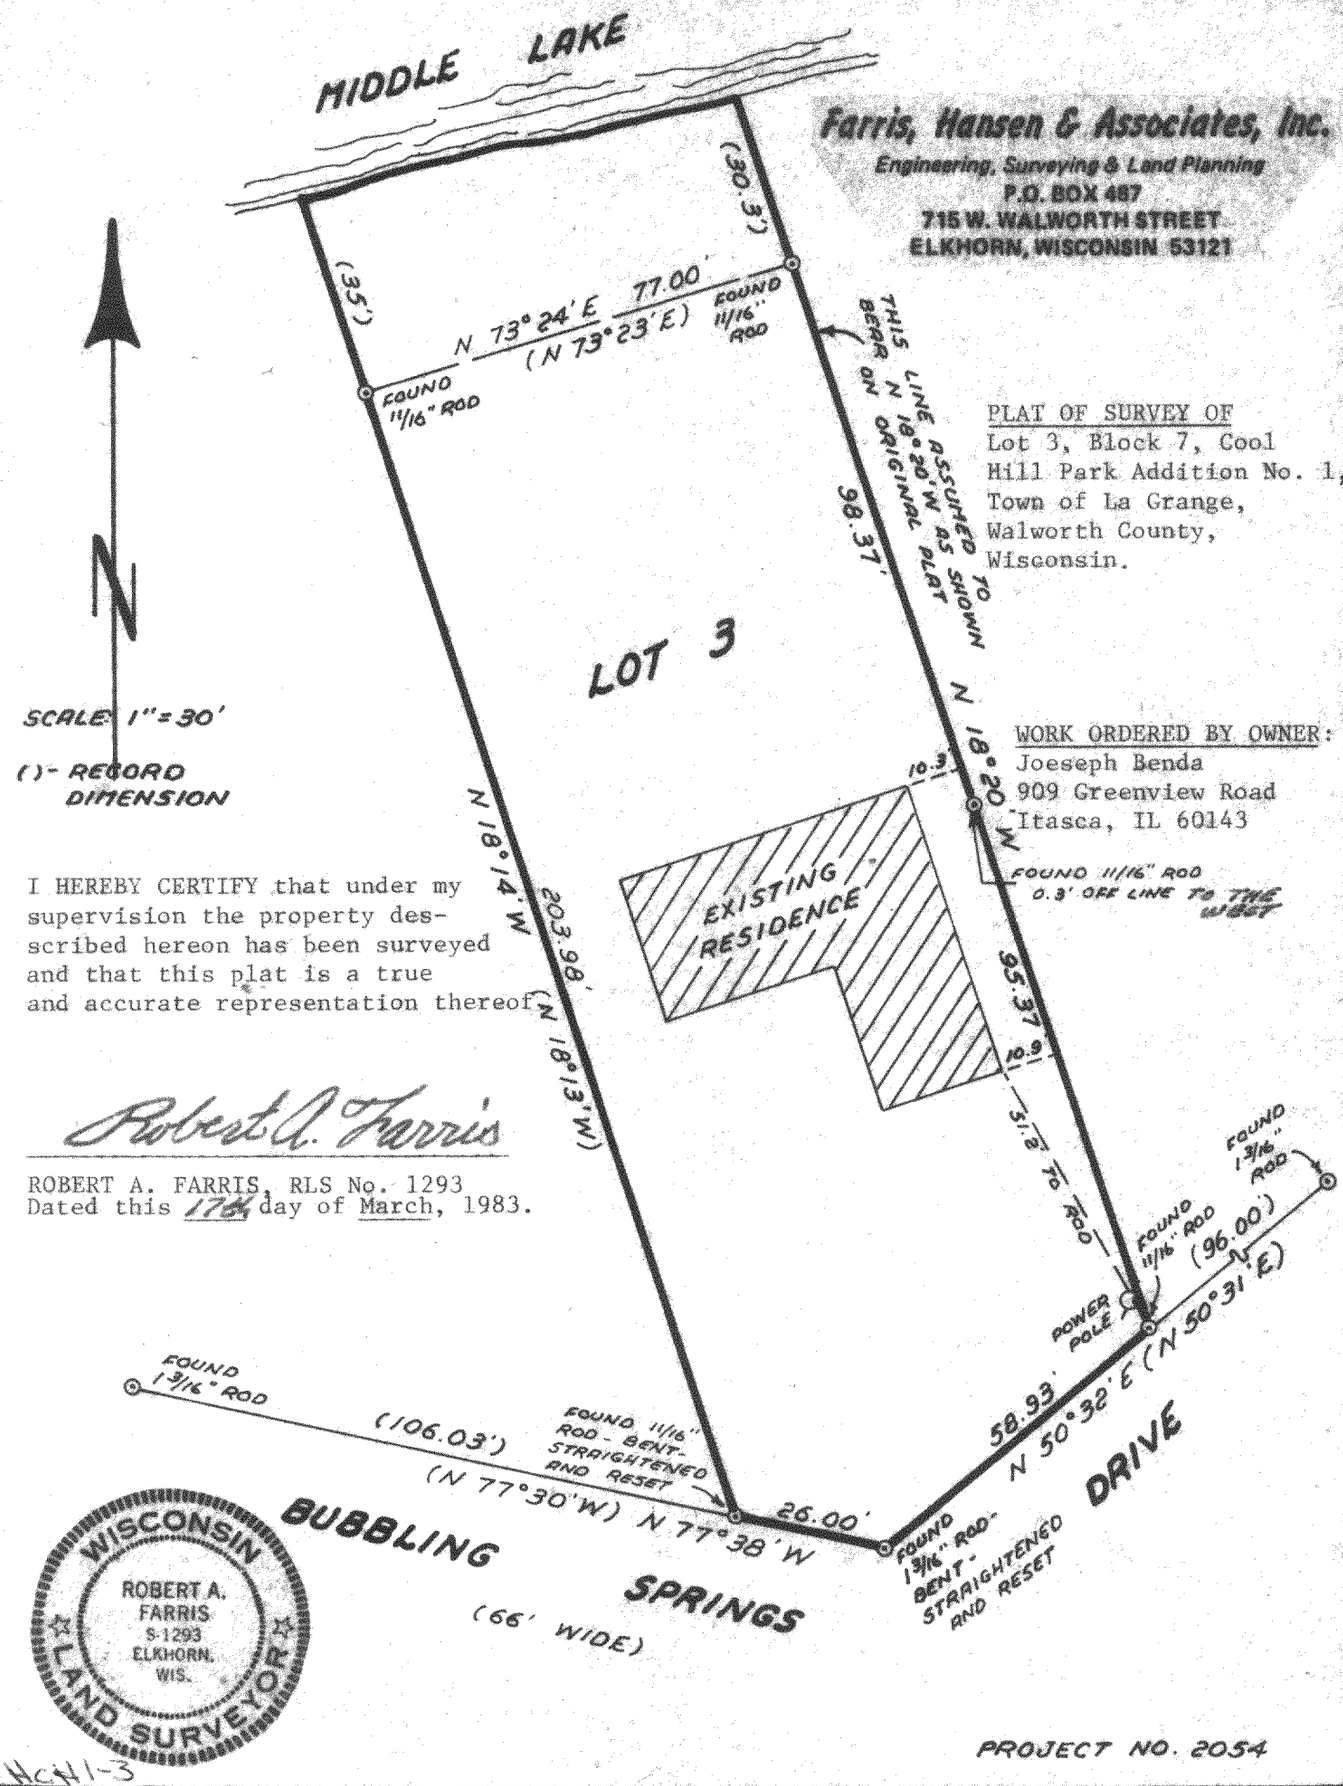


PLAT OF SURVEY OF
Lot 3, Block 7, Cool Hill Park Addition No. 1, Town of La Grange, Walworth County, Wisconsin.

WORK ORDERED BY OWNER:
Joeseph Benda
909 Greenview Road
Itasca, IL 60143

I HEREBY CERTIFY that under my supervision the property described hereon has been surveyed and that this plat is a true and accurate representation thereof.

Robert A. Farris

ROBERT A. FARRIS, RLS No. 1293
Dated this 17th day of March, 1983.

WISCONSIN
ROBERT A. FARRIS
S-1293
ELKHORN, WIS.
LAND SURVEYOR

PROJECT NO. 2054

HCW1-3