
PREPARED FOR
SCOTT & CHERYL
DILLNER


PLAT OF SURVEY

- OF -

Lot 4 Cali Acres Subdivision, located in the Southwest 1/4 of Section 35, Township 4 North, Range 16 East, Town of Lagrane, County of Walworth and State of Wisconsin.

PATHFINDER SURVEYING
(a NMB Company)
P.O BOX 322
LAKE GENEVA, WI. 53147
WWW.PATHFINDERSURVEYING.NET
262-248-8303

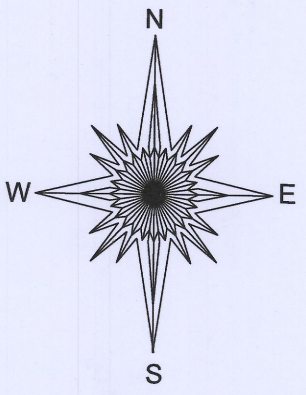

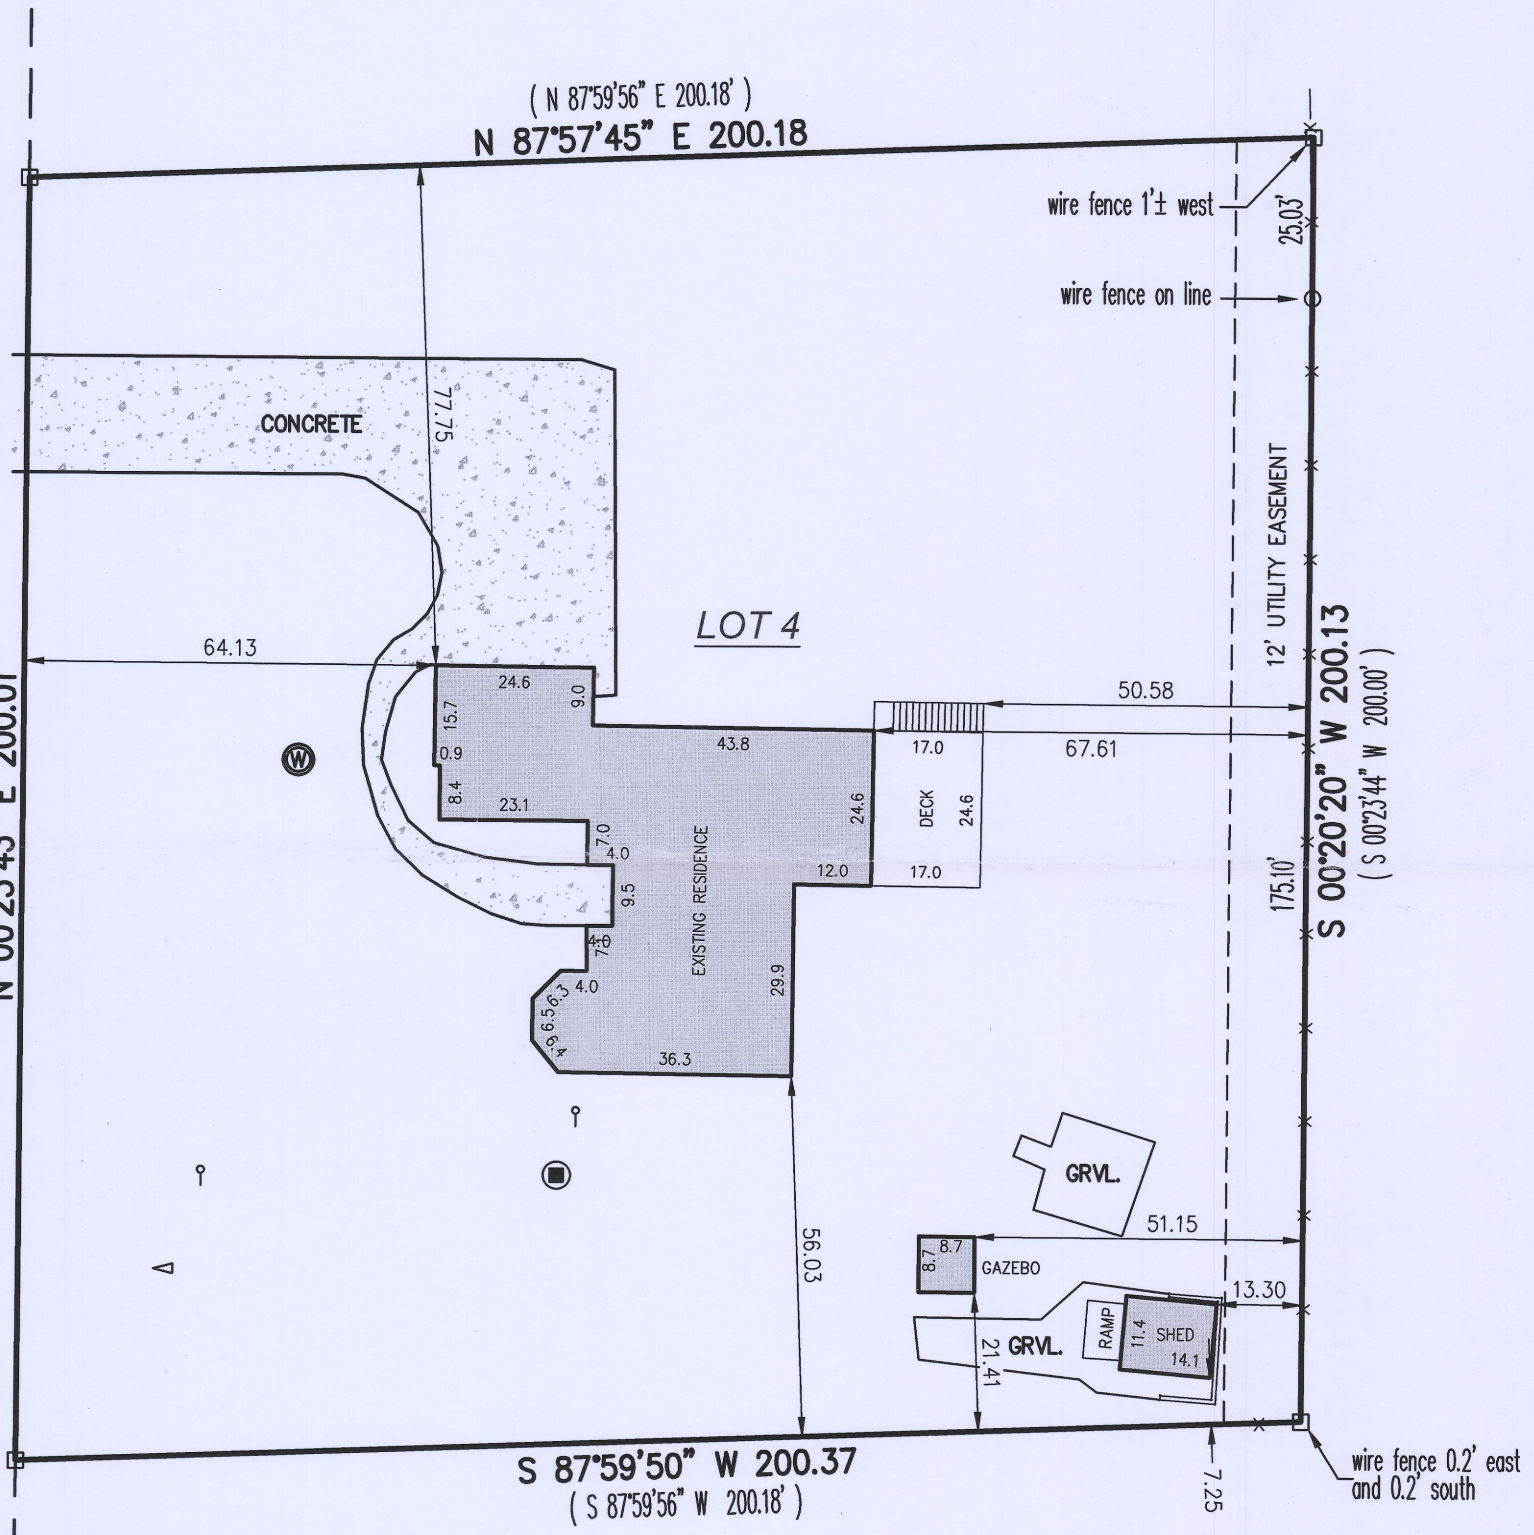

( ) = recorded as
○ = found iron pipe
□ = found iron bar
◉ = concrete lid
⚲ = clean out
◁ = vent pipe
Ⓦ = well
—X— = fence

SCALE 1" = 30'

JOB # 2018.0144.01

TAX ID # HC 00004

30 0 30 60 90

BASIS OF BEARING OF THIS PLAT: THE SUBDIVISION PLAT OF RECORD.

I hereby certify that I have surveyed the above- described property and the above map is a is a true representation thereof and shows the size and location of the property, its exterior boundaries, the location and dimensions of all structures thereon, fences, apparent easements and roadways and visible encroachments if any to the best of my knowledge and belief.

This survey is made for the present owners of the property, and those who purchase, mortgage, or guarantee the title thereto, within one year from the date hereof.

DATED THIS 18TH DAY OF MAY, 2018.

RECEIVED
JUL 25 2018
By Jan

WISCONSIN
MARK R. MADSEN
S-2271
RACINE, WI
LAND SURVEYOR

MARK R. MADSEN S - 2271
Wisconsin Professional Land Surveyor

HC-4 4116-3023