
THE SOUTH LINE OF LOT 21 WAS ASSUMED TO BEAR S85°04E AS ORIGINALLY RECORDED

FARRIS, HANSEN & COOPER, INC.

ENGINEERING, SURVEYING AND LAND PLANNING

715 W. WALWORTH ST. - P.O. BOX 487 - ELKHORN, WI 53121

OFFICE: 414/723-2038

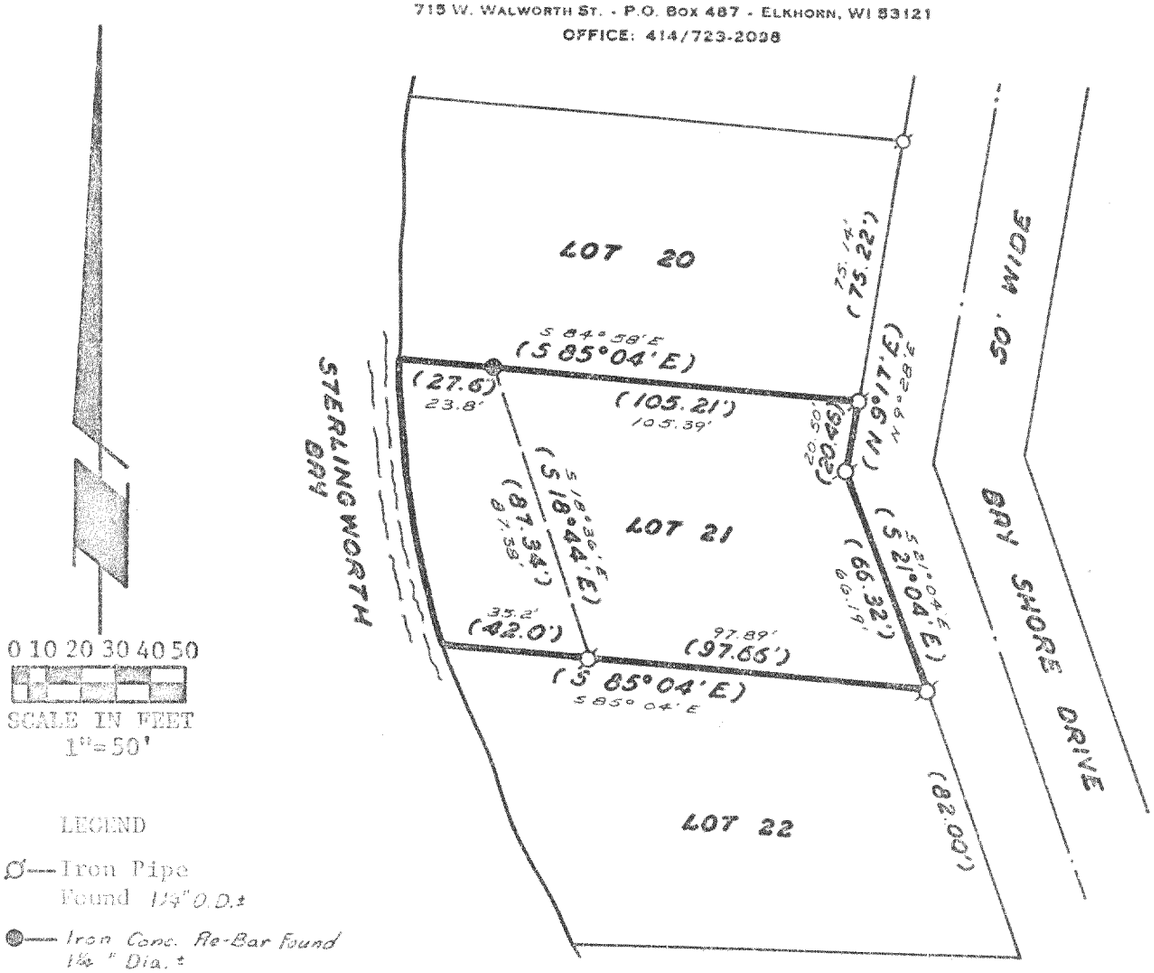

LEGEND

○— Iron Pipe Found 1¼" O.D.±

●— Iron Conc. Re-Bar Found 1¼" Dia.±

()— Record Dimension

35.2— Measured Dimension

PLAT OF SURVEY OF

Lot 21, Block 1, Bay View Manor, a subdivision located in the Northwest 1/4 of Section 36, Town 4 North, Range 16 East, Town of La Grange, Walworth County, Wisconsin.

ORDERED BY: Angie Stenstrom--Colony Realty

WISCONSIN DANIEL D. COOPER S-1464 EAST TROY, WIS. LAND SURVEYOR

I HEREBY CERTIFY that I have surveyed the lands described hereon and that this Plat of Survey is a true and accurate representation of the lot lines to the best of my professional knowledge and belief.

Daniel D Cooper

Daniel D. Cooper, Reg. Land Surveyor, S-1464

5 TH May 1979

Date

PROJECT NO. 1511

48-21

416-302 F