
FARRIS, HANSEN & COOPER, INC.
ENGINEERING, SURVEYING & LAND PLANNING
715 W. WALWORTH ST. - BOX 487 - ELKHORN, WI.
PHONE: 414-723-2098

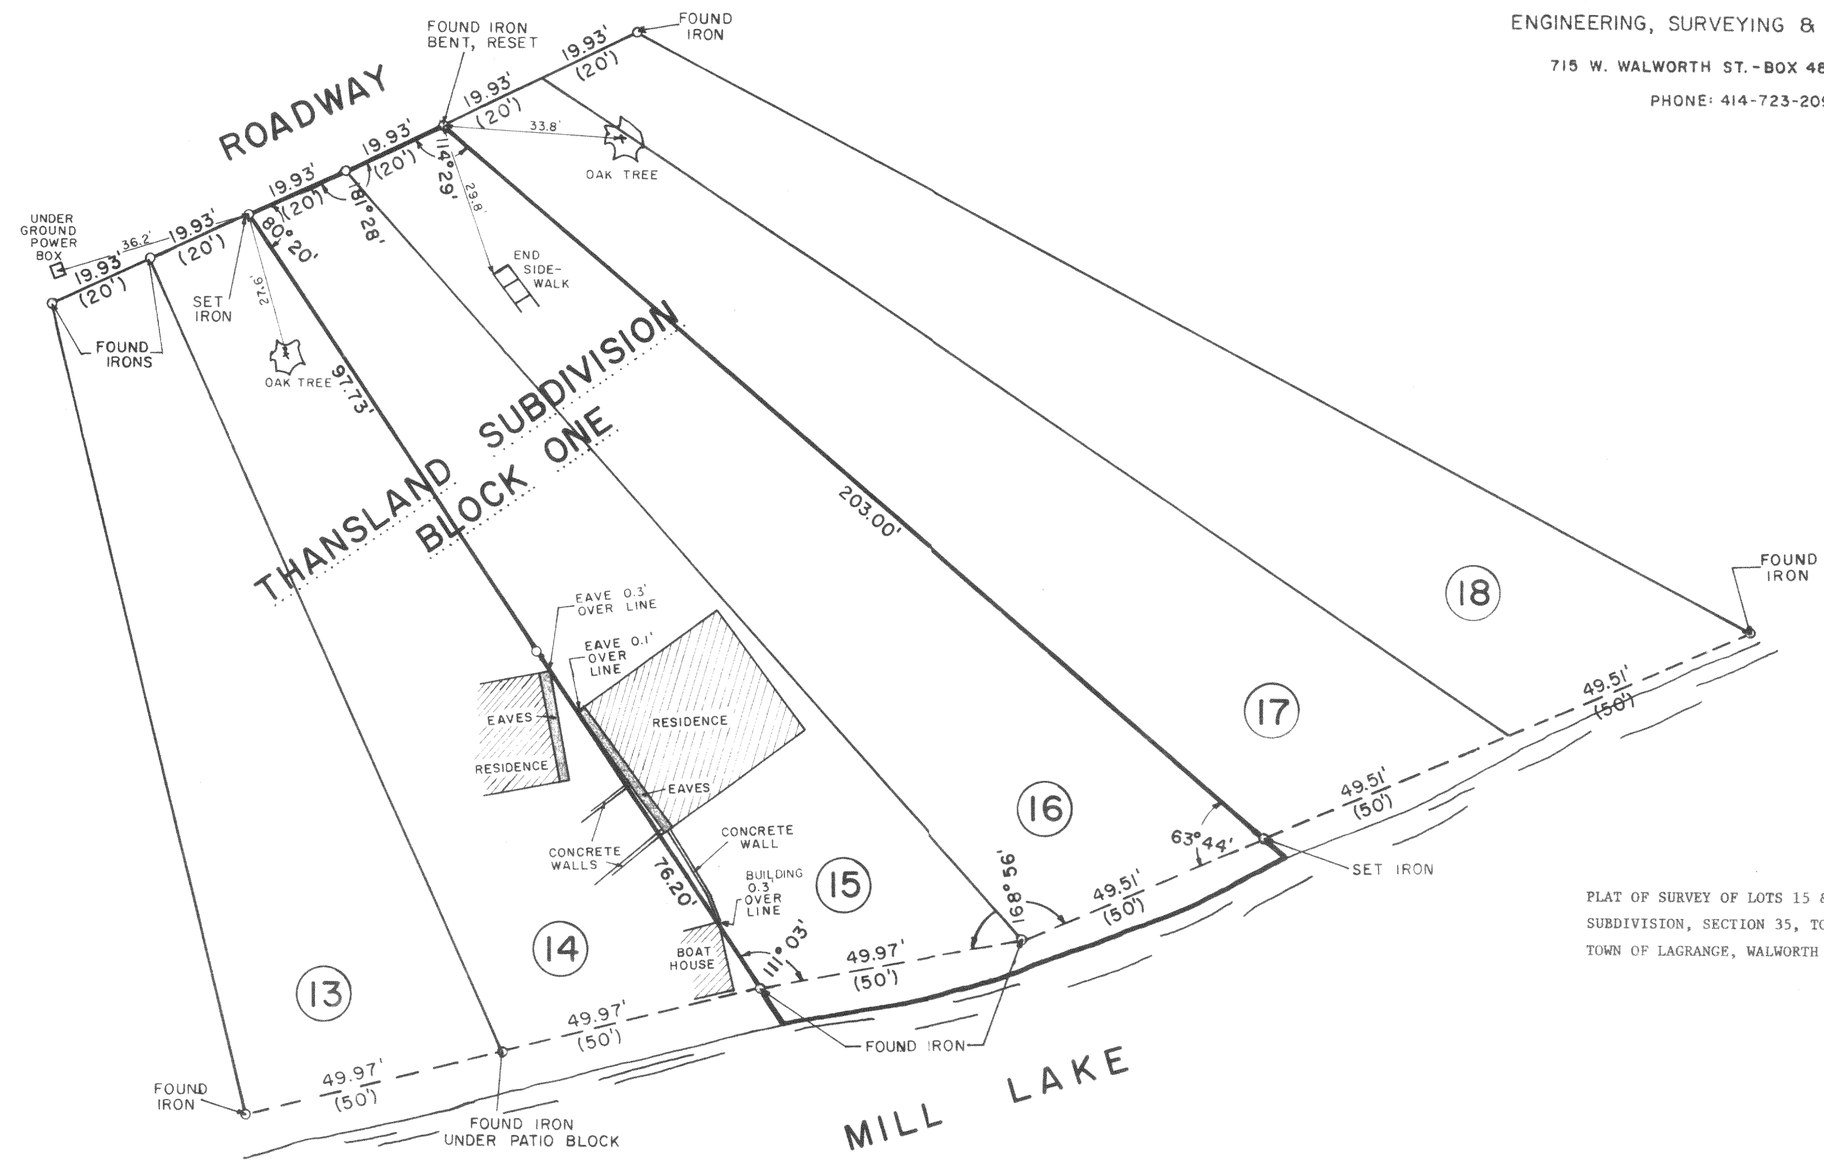

PLAT OF SURVEY OF LOTS 15 & 16, BLOCK 1, THANSLAND SUBDIVISION, SECTION 35, TOWN 4 NORTH, RANGE 16 EAST, TOWN OF LAGRANGE, WALWORTH COUNTY, WISCONSIN.

0 5 10 20
SCALE IN FEET
1"=20'

(XXX) RECORD DIMENSION

I HEREBY CERTIFY that I have surveyed the property described hereon and that this Plat of Survey is a true and accurate representation of the lot lines, and the buildings thereon, to the best of my professional knowledge and belief.

Daniel D. Cooper

Daniel D. Cooper, RLS No. 1464

Dated this 15th day of July, 1980.

WISCONSIN
DANIEL D. COOPER
S-1464
EAST TROY, WIS.
LAND SURVEYOR

WORK ORDERED BY:
JIM REHM

HTL-5

PROJECT NO. 1712

416-303F