



Plat of Survey

of
Lot 6 in Block 1 of Pebble Beach,
a subdivision located in the Northeast 1/4 and the Northwest 1/4 of
the Northwest 1/4 of Section 25, Town 4 North, Range 16 East,
Town of LaGrange, Walworth County, Wisconsin.

Surveyed for: **Rick O'Donnell**
4411 Wilmette Avenue
Rolling Meadows, Illinois. 60008

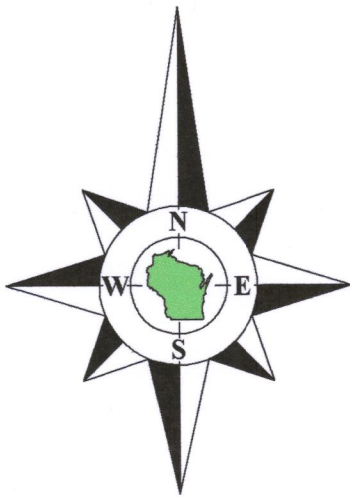

Bearings referenced to the Northerly line of Meadow Lane,
recorded as S74°06'36"E on the plat of Pebble Beach.

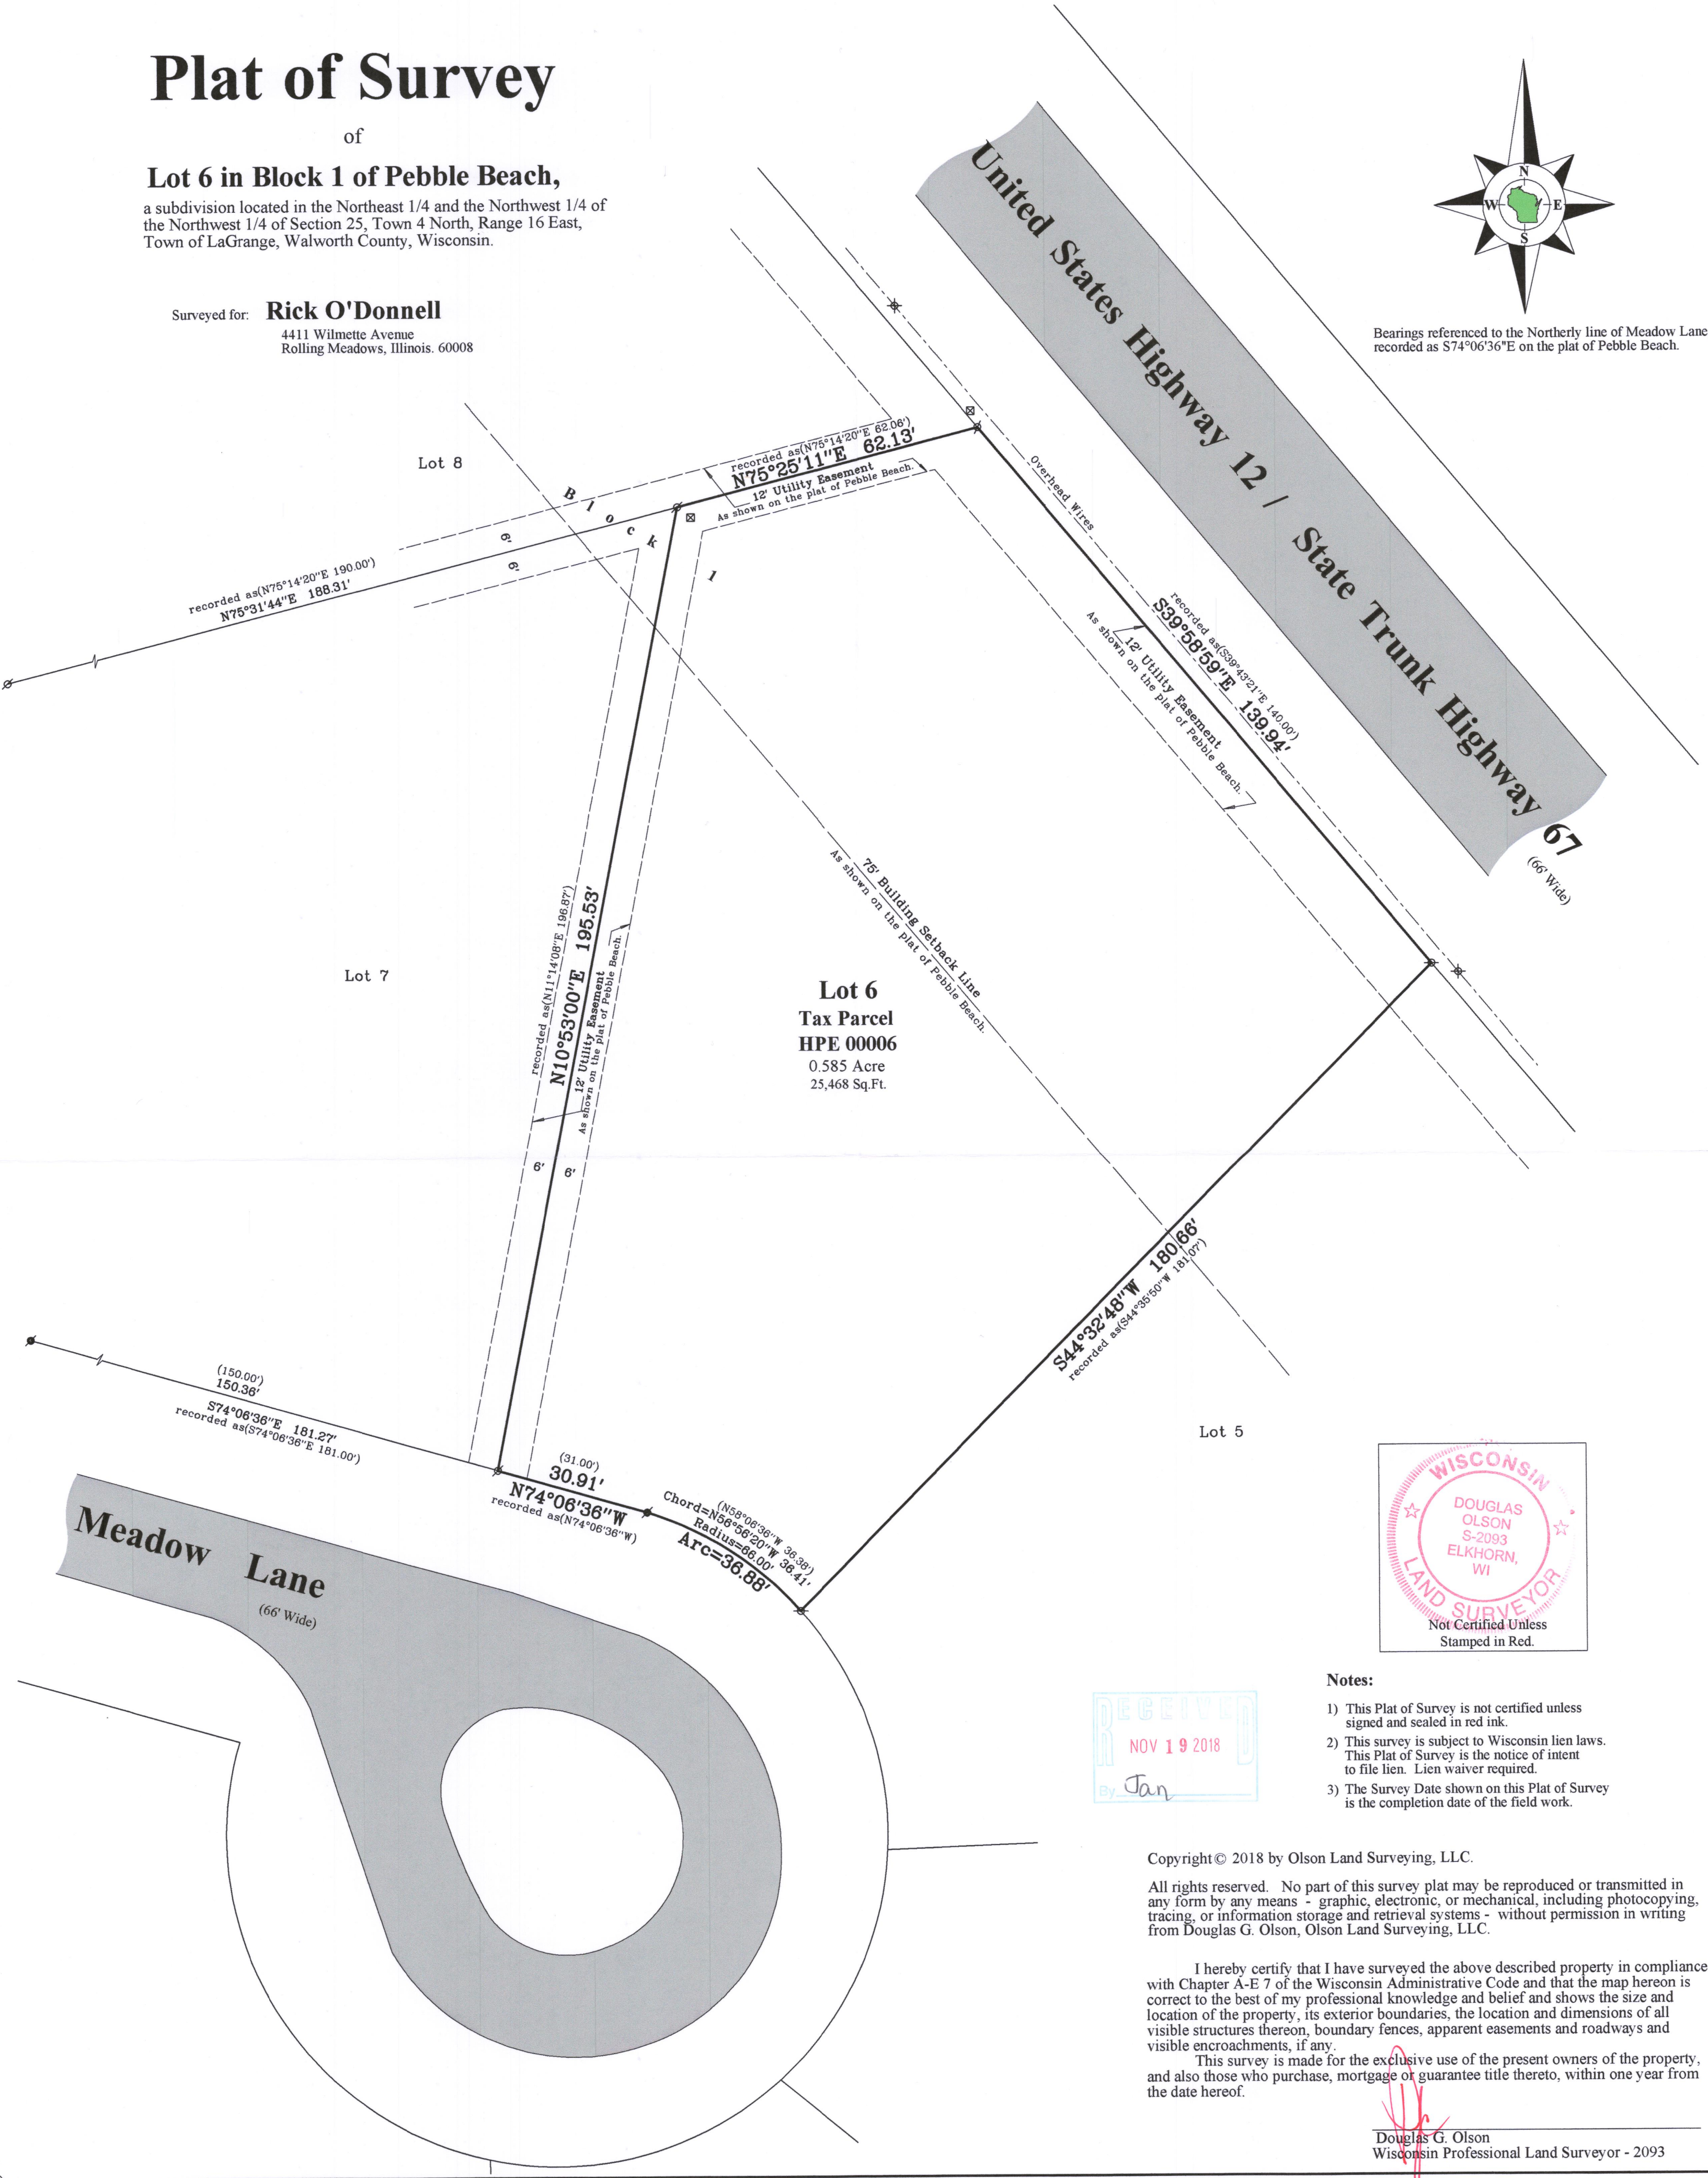

- Notes:**
- 1) This Plat of Survey is not certified unless signed and sealed in red ink.
 - 2) This survey is subject to Wisconsin lien laws. This Plat of Survey is the notice of intent to file lien. Lien waiver required.
 - 3) The Survey Date shown on this Plat of Survey is the completion date of the field work.



Copyright © 2018 by Olson Land Surveying, LLC.

All rights reserved. No part of this survey plat may be reproduced or transmitted in any form by any means - graphic, electronic, or mechanical, including photocopying, tracing, or information storage and retrieval systems - without permission in writing from Douglas G. Olson, Olson Land Surveying, LLC.

I hereby certify that I have surveyed the above described property in compliance with Chapter A-E 7 of the Wisconsin Administrative Code and that the map hereon is correct to the best of my professional knowledge and belief and shows the size and location of the property, its exterior boundaries, the location and dimensions of all visible structures thereon, boundary fences, apparent easements and roadways and visible encroachments, if any.

This survey is made for the exclusive use of the present owners of the property, and also those who purchase, mortgage or guarantee title thereto, within one year from the date hereof.

Douglas G. Olson
Wisconsin Professional Land Surveyor - 2093

HPE-6 416-3049