
FARRIS, HANSEN & COOPER, INC.

ENGINEERING, SURVEYING AND LAND PLANNING

715 W. WALWORTH ST. - P.O. BOX 487 - ELKHORN, WI 53121

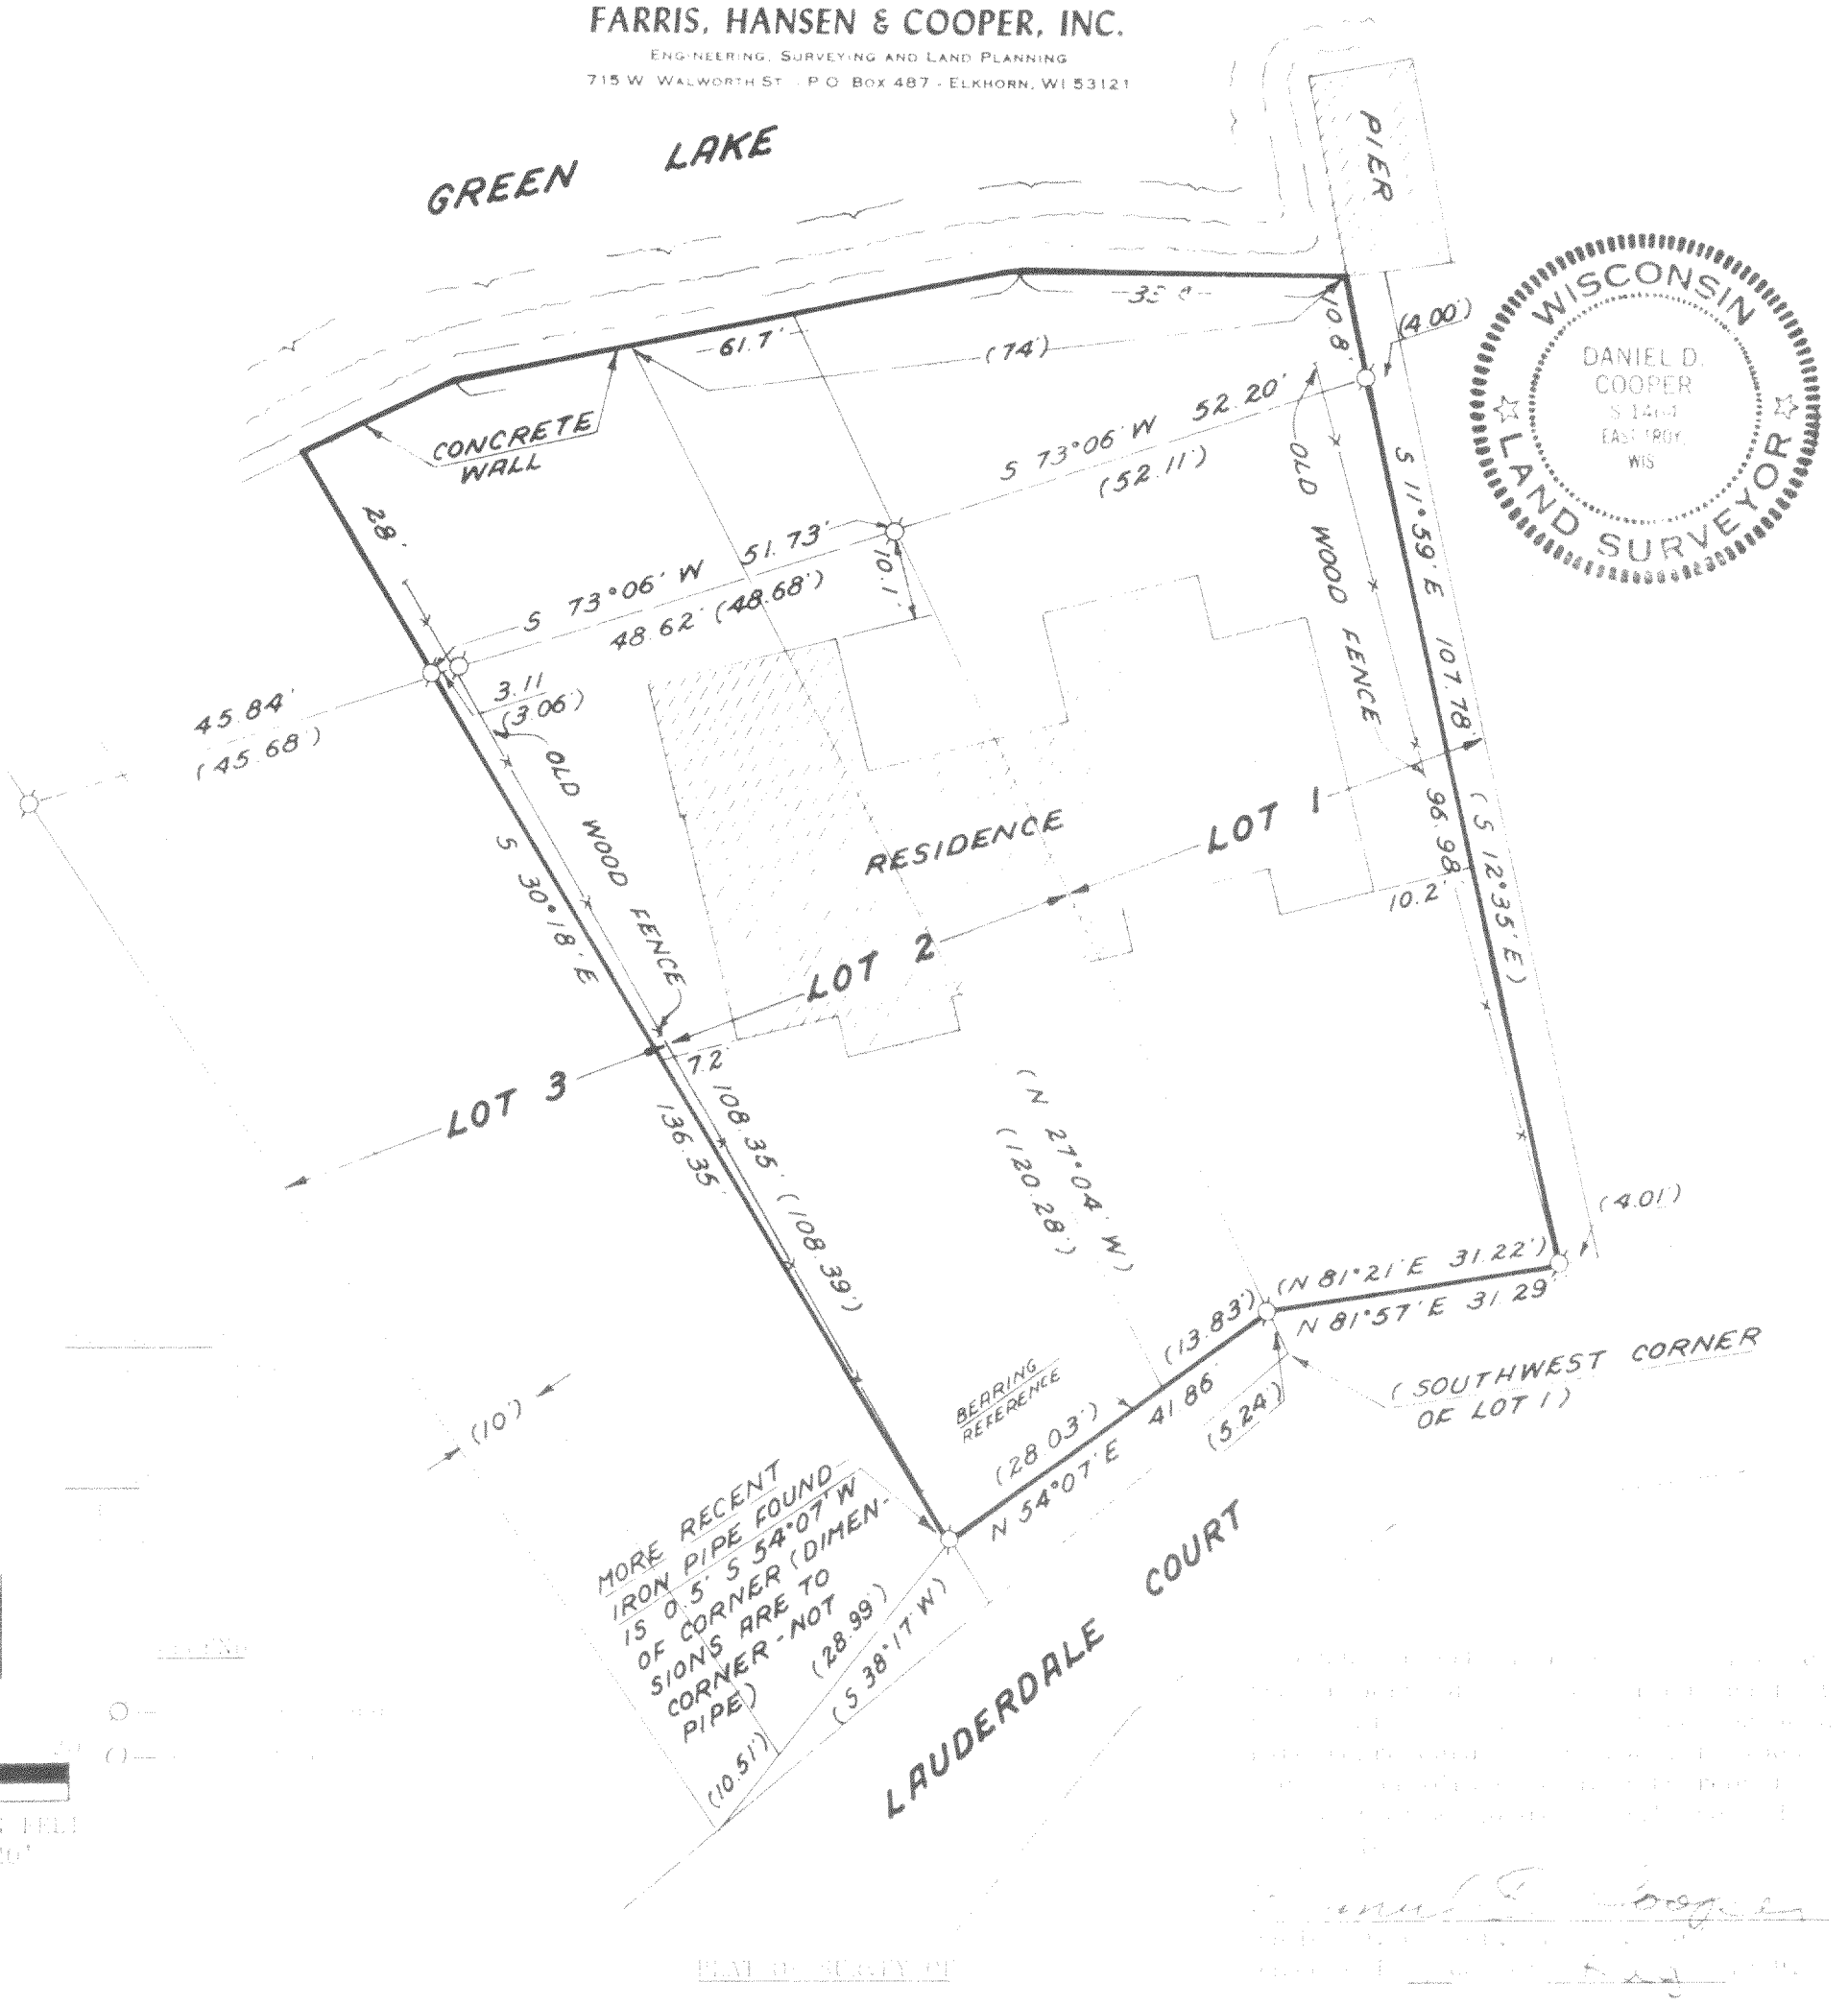


PLAT OF SURVEY OF

PART OF LOT 1, IN SAID SUBDIVISION, SECTION 26, TOWN 4 NORTH, RANGE 16 EAST, WALWORTH COUNTY, WISCONSIN, DESCRIBED AS FOLLOWS:

A parcel of land located in Green Island Subdivision, located in Section 26, Town 4 North, Range 16 East of Walworth County, Wisconsin, described as follows, to-wit: Beginning at a point on the westerly line of Lot 1 at a point that is located 5.24 feet northerly of the southwest corner of said lot; thence south 54° 07' W. 13.83 feet; thence north 27° 04' West 120.28 feet to the shore of Green Lake; thence northeasterly along the shore of said lake 74 feet, thence south 12° 35' east 126.09 feet, thence south 81° 21' West 31.22 feet to the place of beginning, the above described land consists of part of Lots 1 and 2 and part of Lauderdale Court that is now vacated. Also the east half of the following described premises: A parcel of land consisting of part of Lots 2 and 3 of Green Island Subdivision, which Subdivision is located in Section 26, Town 4 North, Range 16 East of Walworth County, Wisconsin, described as follows: Commencing at the most southerly corner of Lot 1 of said subdivision, thence northerly 5.24 feet along the westerly line of said Lot 1; thence south 54° 07' west 13.83 feet to the place of beginning; thence continue south 54° 07' west 28.03 feet to the southwesterly line of Lot 2 of said Subdivision; thence south 38° 17' west to a point that is located 10 feet northeasterly of (measured at right angles) the southwesterly line of said Lot 3; thence northwesterly along a line parallel to and 10 feet from said southwesterly line of Lot 3 to the shore of Green Lake; thence northeasterly along the shore to a point that is located north 27° 04' West 120.28 feet from the place of beginning; thence south 27° 04' east 120.28 feet to the place of beginning.

It is understood and agreed that the East half means that portion east of an imaginary line from a point equal distance from the limits of the above described shore line and an equal distance from the limits of the above described rear line.

Excepting from the above parcel a roadway 20 feet in width the center line of which commences at the center of the bridge to Green Island and meanders along the center of the road as it now exists to a point 75 ft. N.E. of the S.E. corner of Lot 12 then continue in a circle around West Park over the road as it now exists, including the right to remove two large trees.

PROJ. NO. 1564

WG1-1A

WG-30HF