FARRIS, HANSEN & COOPER, INC.
ENGINEERING, SURVEYING AND LAND PLANNING
715 W. WALWORTH ST. - P.O. BOX 487 - ELKHORN, WI 53121

PLAT OF SURVEY OF

LOT 13, BLOCK 1, THANSLAND SUBDIVISION, SECTION 35, TOWN 4 NORTH, RANGE 16 EAST, TOWN OF LA GRANGE, WALWORTH COUNTY, WISCONSIN.

ORDERED BY: ANGIE STENSTROM, COLONY REALTY OWNER: JINA EIESLAND


NOTE: THE NORTHERLY LINE OF LOTS 13-15 IS ASSUMED TO BEAR N 66-3/4° E AS SHOWN ON THE PLAT OF THANSLAND SUBDIVISION.

I HEREBY CERTIFY THAT I HAVE SURVEYED THE PROPERTY DESCRIBED HEREON AND THAT THIS PLAT OF SURVEY IS A TRUE AND ACCURATE REPRESENTATION OF THE LOT LINES AND THE BUILDINGS LOCATED THEREON TO THE BEST OF MY PROFESSIONAL KNOWLEDGE AND BELIEF.

Daniel D. Cooper
DANIEL D. COOPER, RLS NO. 1464

DATED THIS 7 DAY OF July, 1979.
REVISED: AUGUST 13, 1979

WISCONSIN DANIEL D. COOPER S-1464 EAST TROY, WIS LAND SURVEYOR

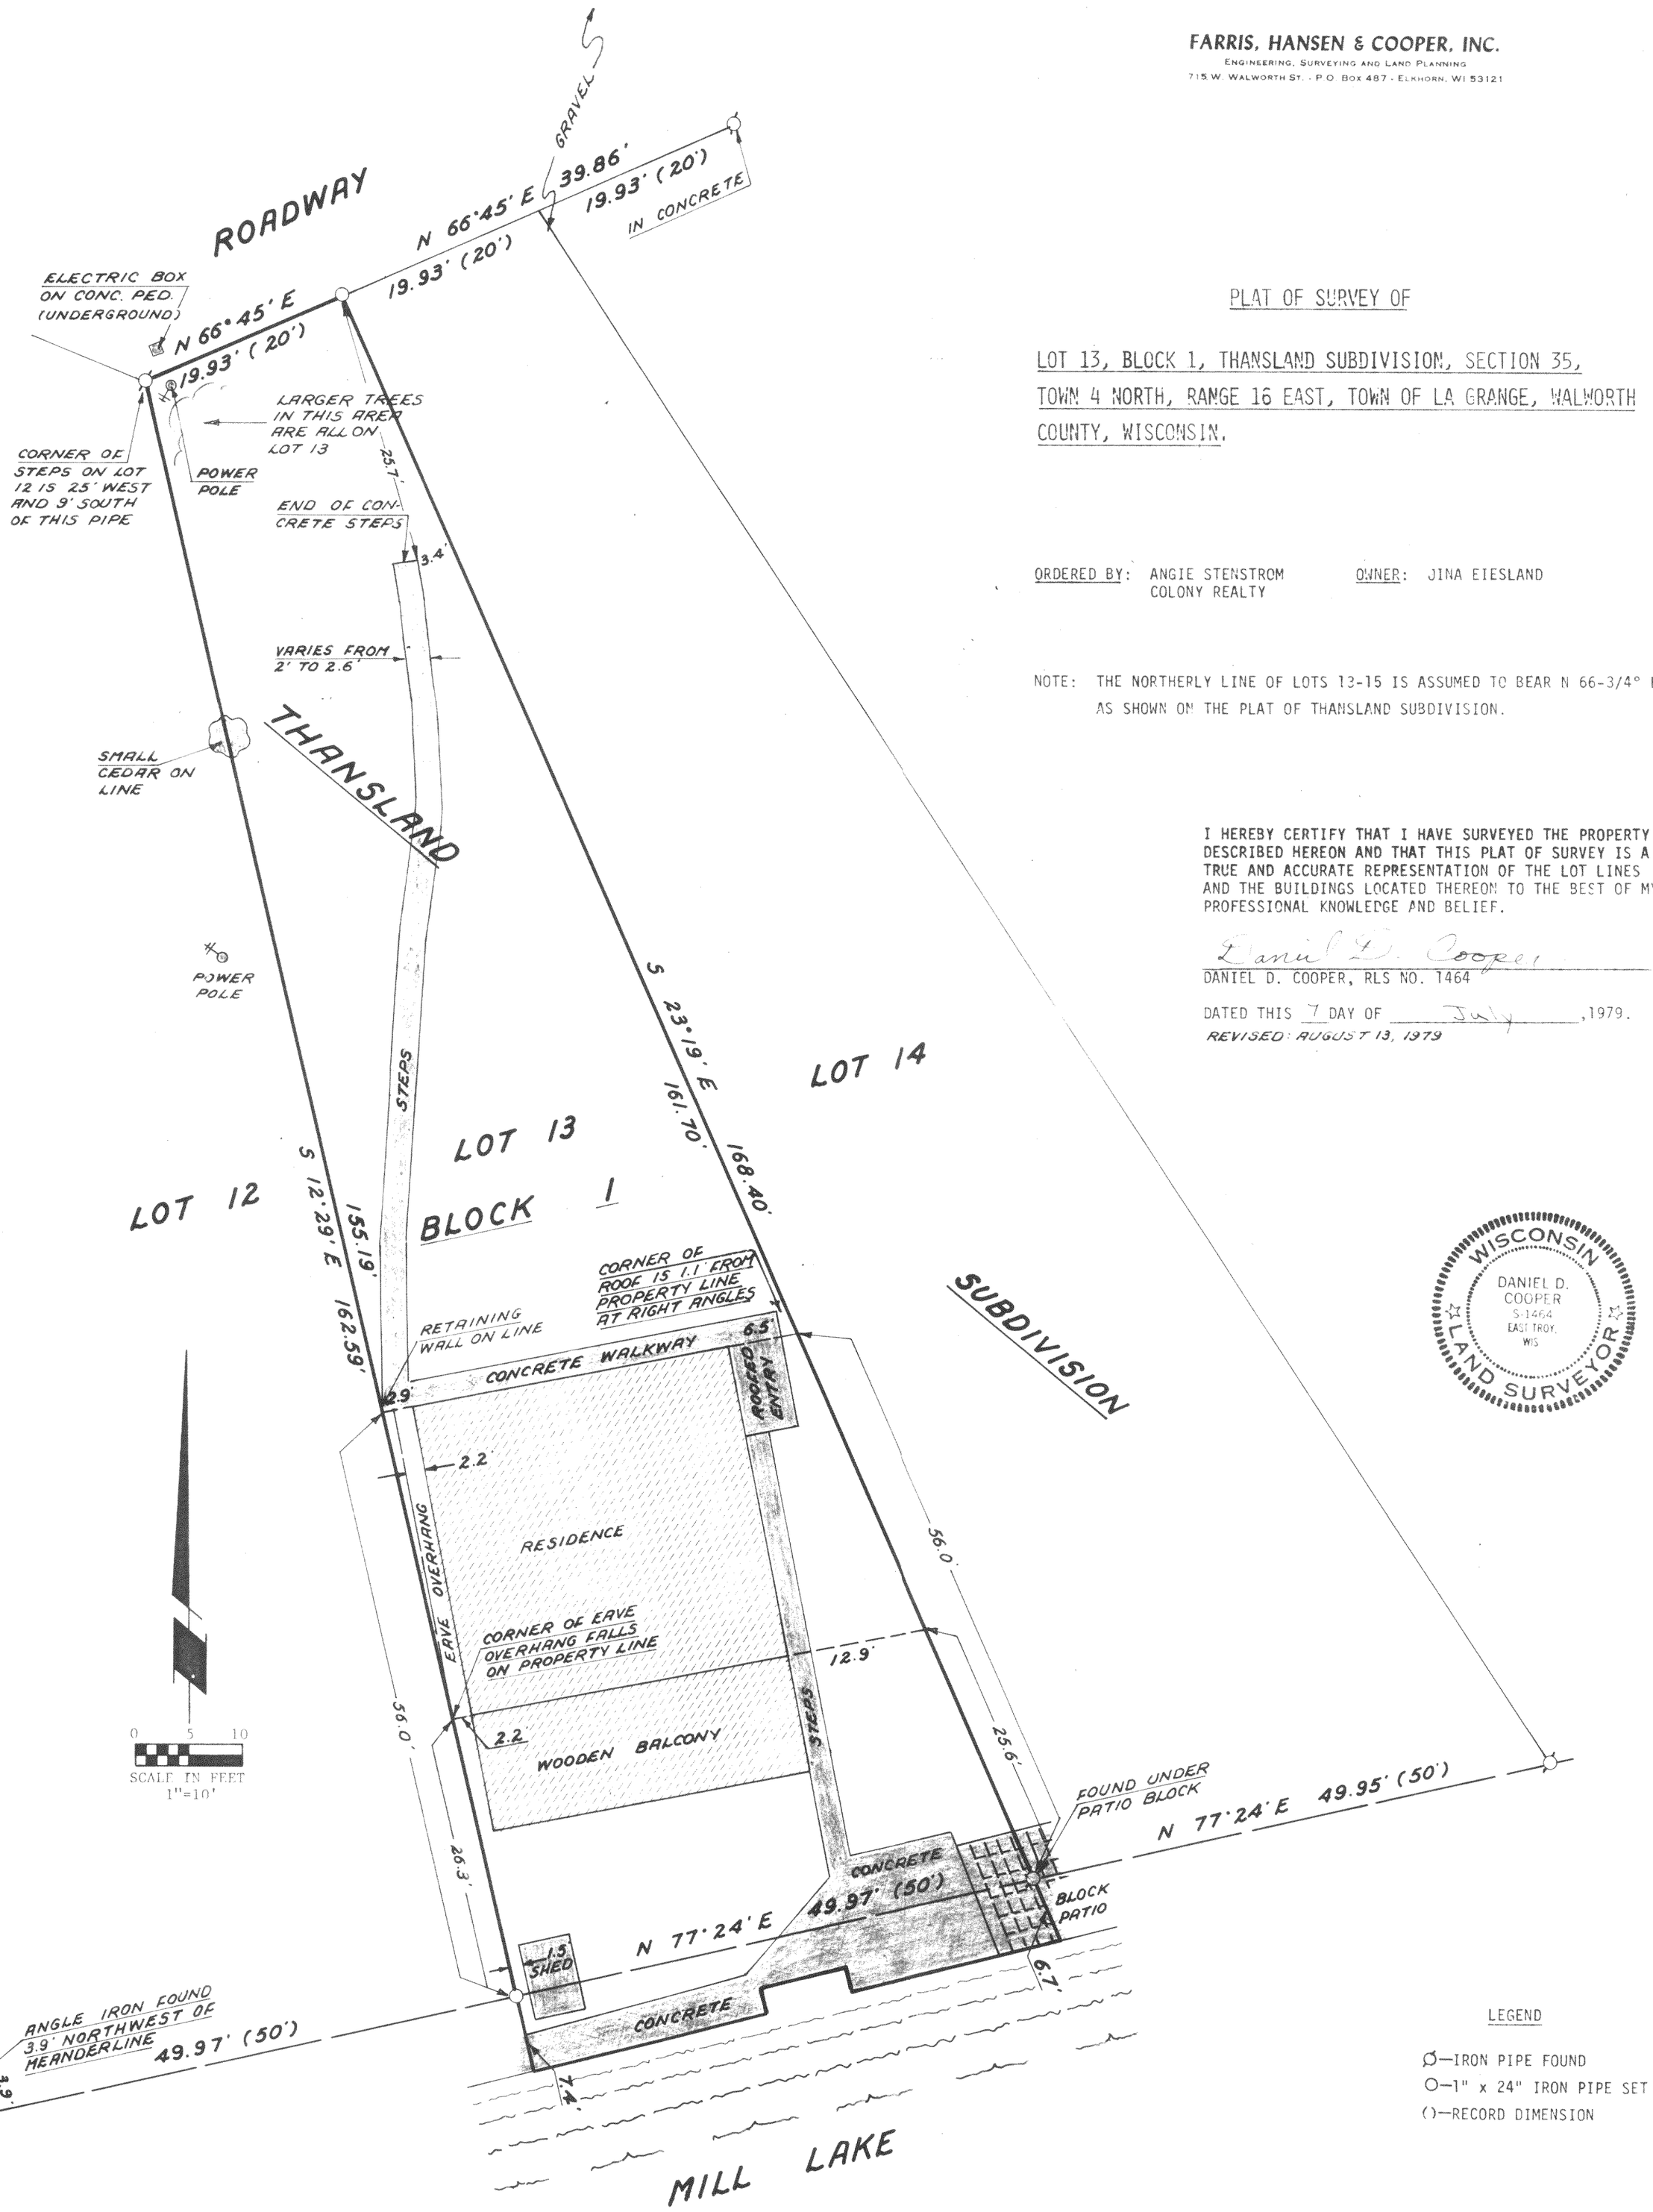

LEGEND

Ø—IRON PIPE FOUND
O—1" x 24" IRON PIPE SET
()—RECORD DIMENSION

PROJECT NO. 1569

HTL-3

416-305