
WORK ORDERED BY GODFREY, PFEIL, & NESHEK, S.C. FOR PAUL VAN MIEGHEM

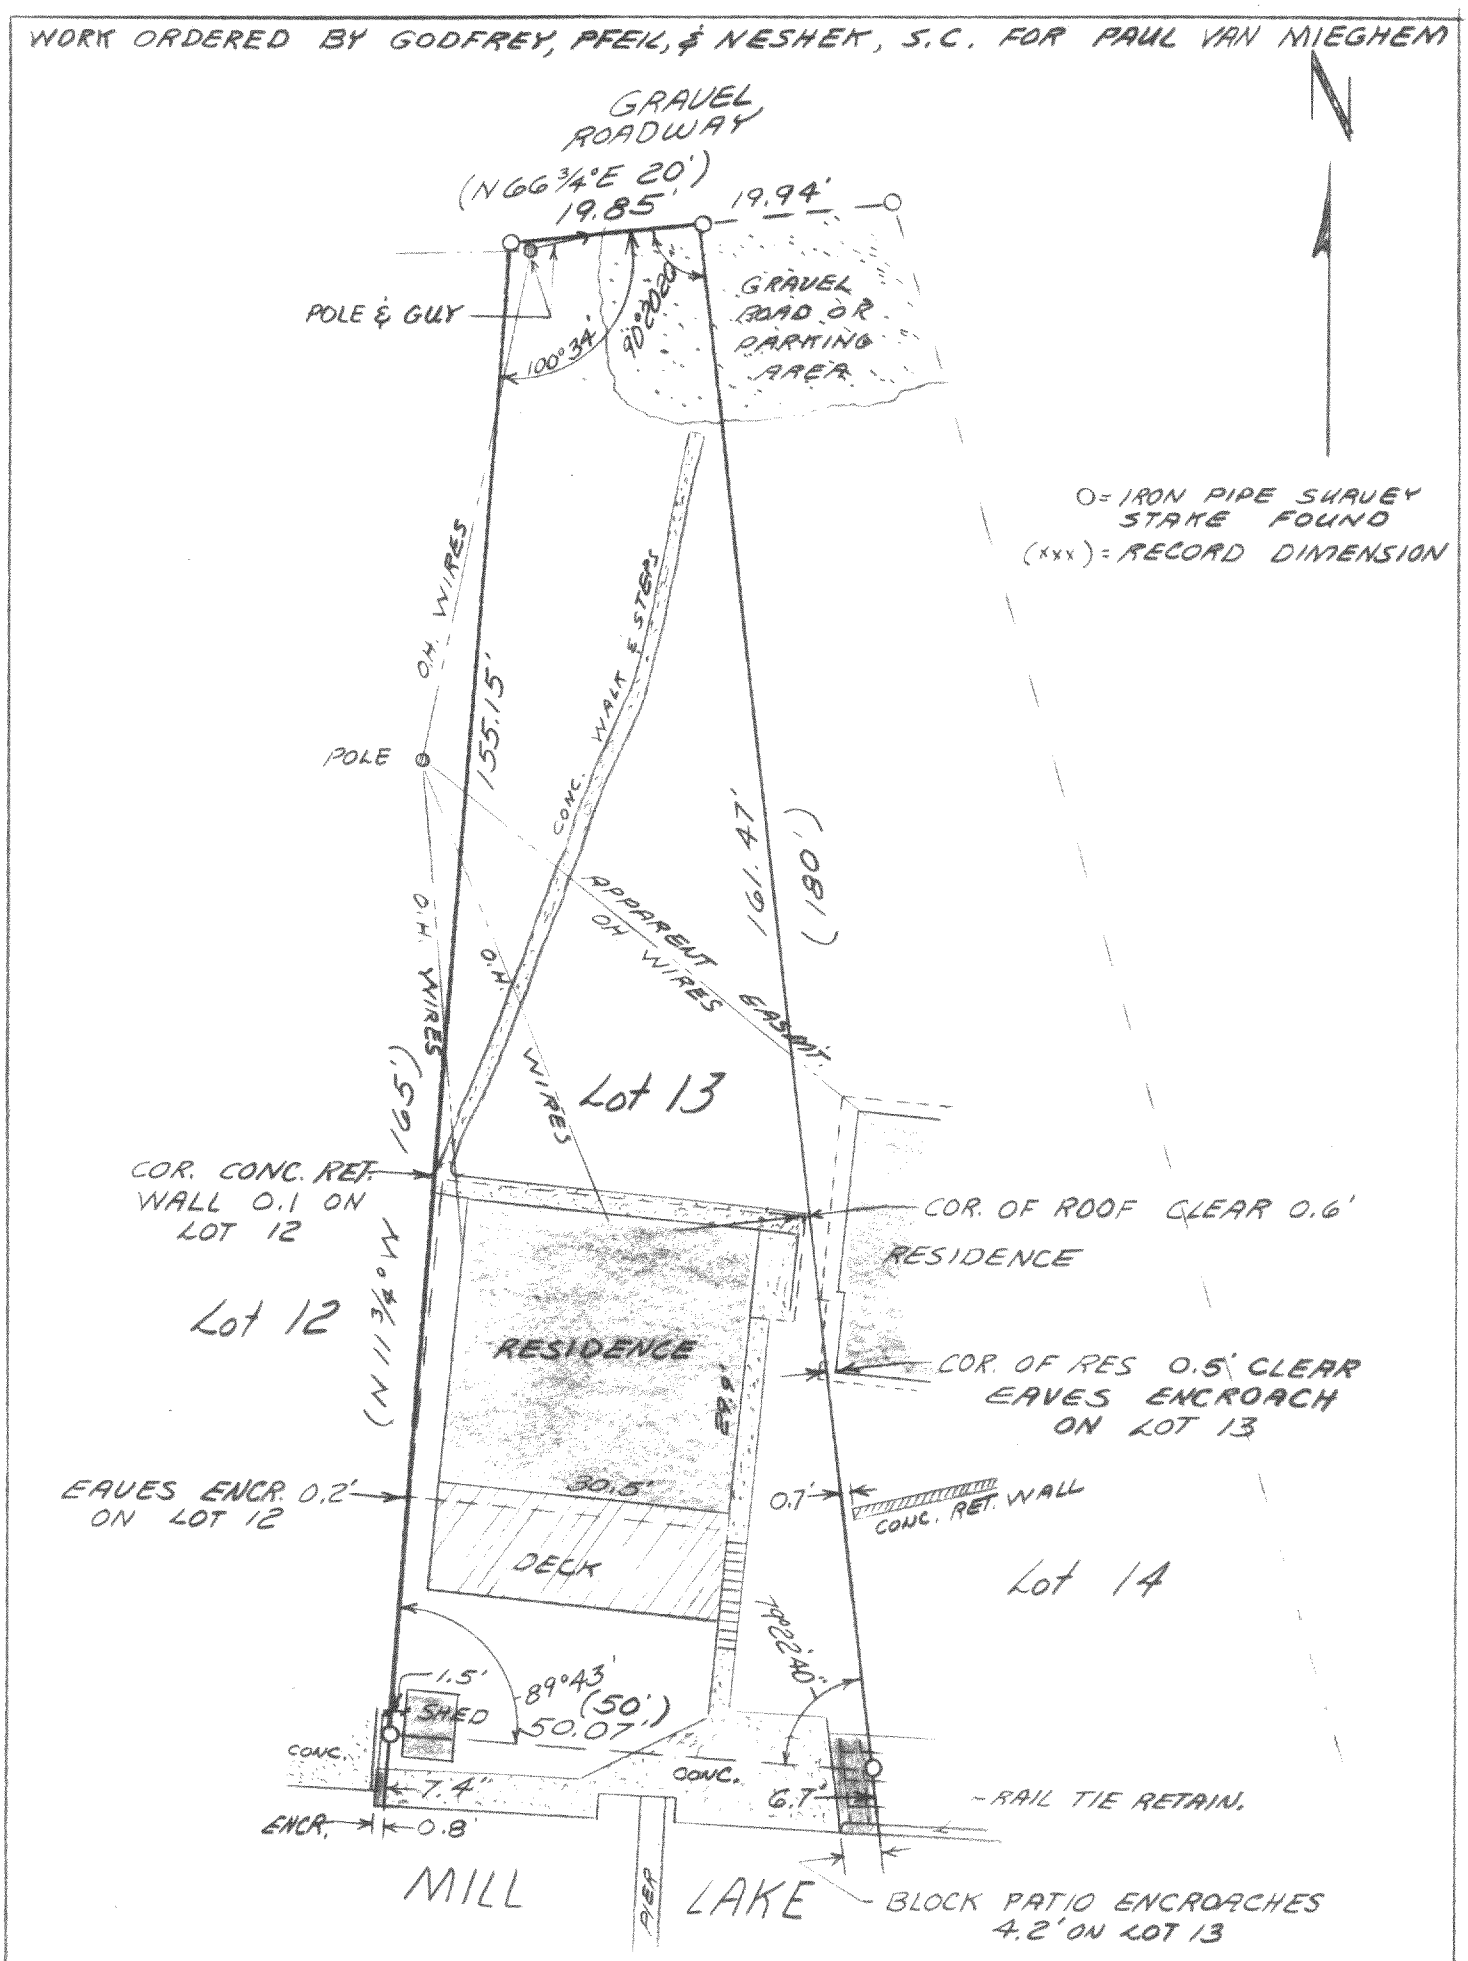

PLAT OF SURVEY: LOT 13 OF BLOCK 1 OF THANSLAND SUBDIVISION SEC. 35, T. 4N., R. 16E. TOWN OF LAGRANGE, WALWORTH COUNTY, WISCONSIN

WISCONSIN
ROBERT A FARRIS
S-1293
ELKHORN WIS
LAND SURVEYOR

I hereby certify that I have surveyed the above described property and that the above map is a true representation thereof and shows the size and location of the property, its exterior boundaries, the location of all visible structures and dimensions of all principal buildings thereon, boundary fences, apparent easements, roadways and visible encroachments, if any.

This survey is made for the use of the present owners of the property, and also those who purchase, mortgage, or guarantee the title thereto within one (1) year from date hereof.

Robert A. Farris

31 MAY 1984 PROJ 2260

Farris, Hansen & Associates, Inc.
Engineering, Surveying & Land Planning
P.O. BOX 487
715 W. WALWORTH STREET
ELKHORN, WISCONSIN 53121

HTL-3

416-308 F