
Plat of Survey

Survey For: Wisconsin Department of Natural Resources

Location: W6942 County Road "O", Town of La Grange, Walworth County, Wisconsin.

Description: Lot 1 of Certified Survey Map No. 2857 as recorded in the Walworth County Register of Deeds Office in Volume 15 of Certified Survey Maps on Pages 33 and 34, as Document No. 356130, being a part of the NE 1/4 of the NE 1/4 of Section 19, T4N, R16E, Town of La Grange, Walworth County, Wisconsin.

Subject to all rights, reservations, restrictive covenants, and easements recorded or unrecorded.

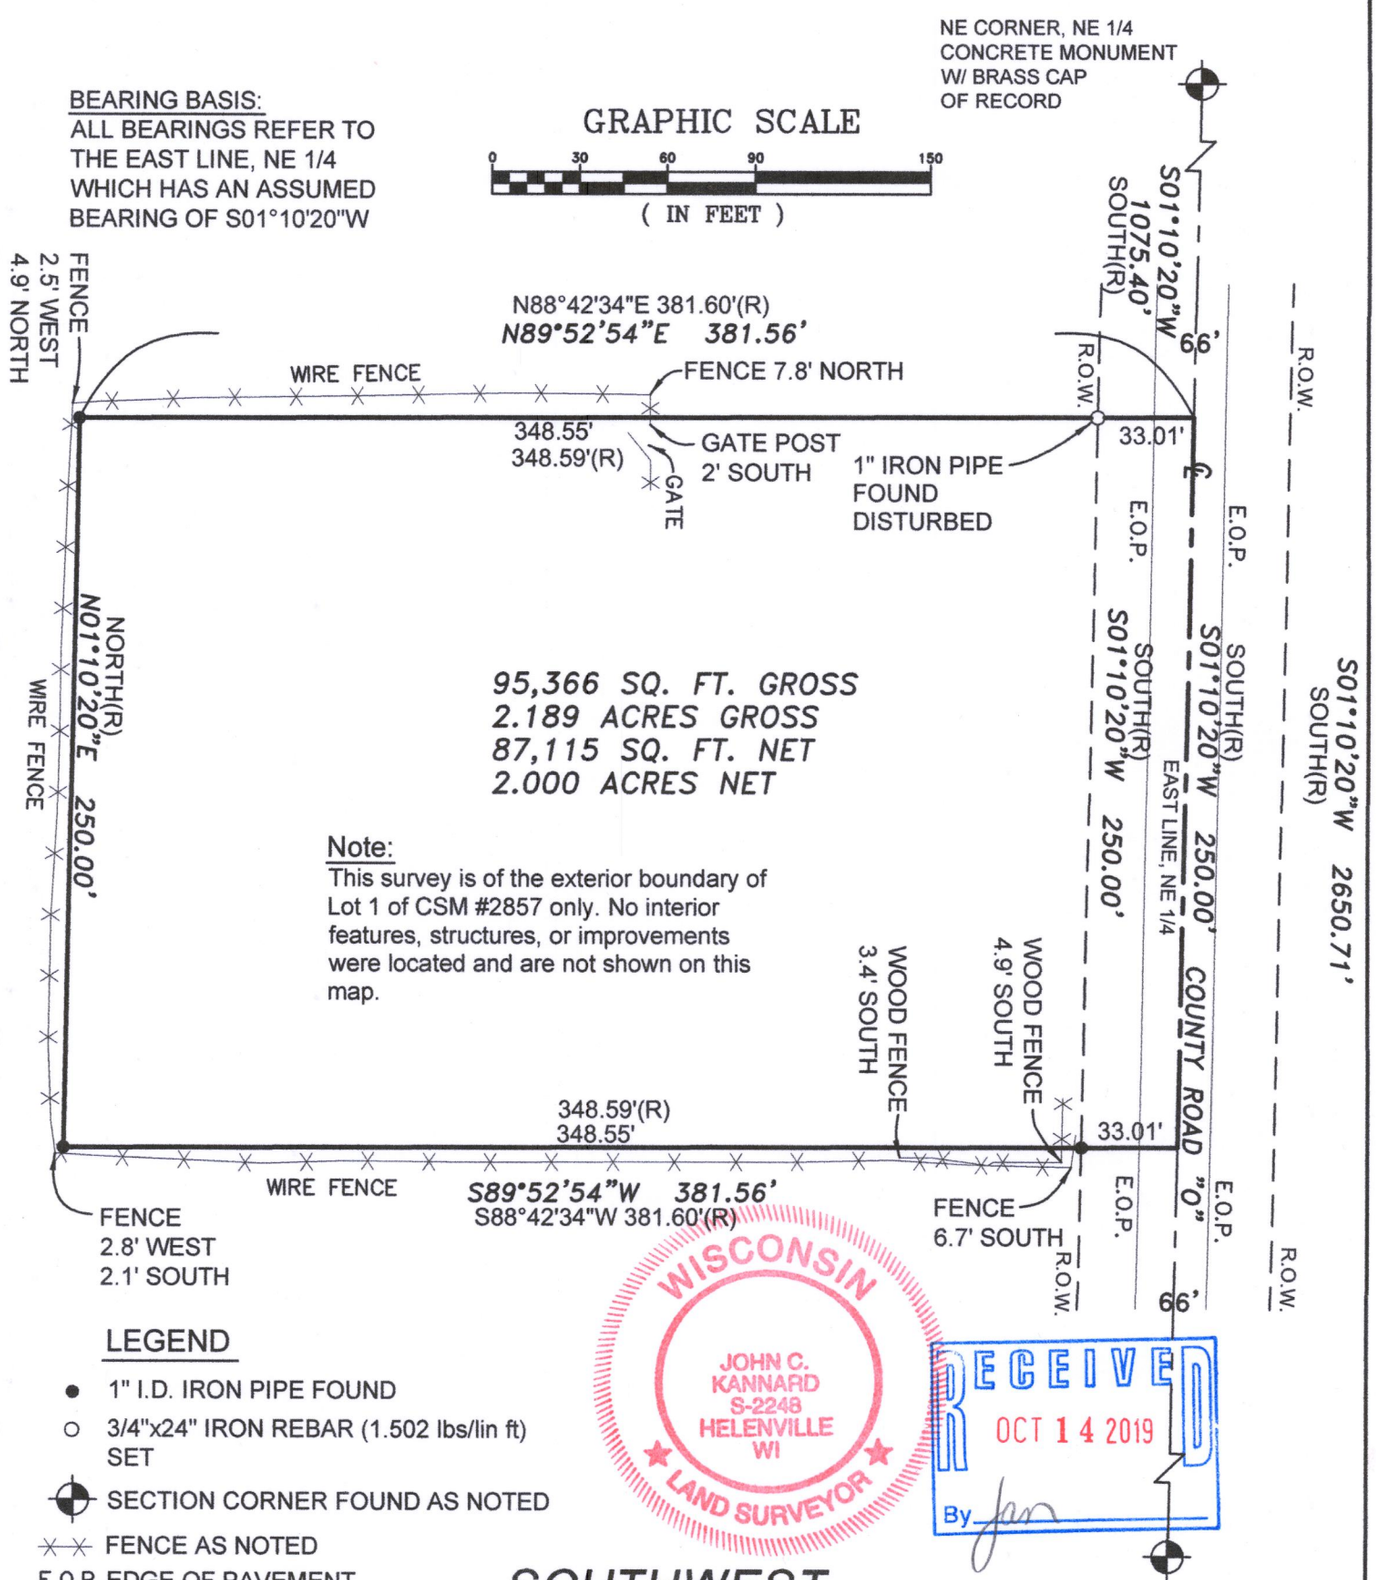

SOUTHWEST
SURVEYING & ASSOCIATES, Inc.
P.O. BOX K, PALMYRA, WI. 53156
262-495-4910
920-674-4884

State of Wisconsin) ss Jefferson County) *I certify that I have surveyed the above described (property) and the above map is a true representation thereof and shows the size and location of the Property, its exterior boundaries, exterior fences, apparent easements and roadways and visible encroachments, if any, this survey complies with Chapter A-E 7, to the best of my knowledge and belief.*

THIS IS A JOHN C. KANNARD AUTHORIZED PRINT ONLY IF SIGNATURE APPEARS IN RED INK ON BLACK LINE PRINT.

JOHN C. KANNARD, Professional Land Surveyor

SHEET 1 OF 1
DATE: JUNE 20, 2019
JOB NO: W-219109

HA2857-1 416-3119