
FARRIS, HANSEN & ASSOC
715 W. WALWORTH ST., BX. 487
ELKHORN, WI. 53121 723-2098

PLAT OF SURVEY OF

LOT 6 OF BLOCK 7 OF COOL HILL PARK ADDITION NO. 1, LOCATED IN THE NORTHWEST 1/4 OF THE SOUTHWEST 1/4 OF SECTION 35, TOWN 4 NORTH, RANGE 16 EAST, WALWORTH COUNTY, WISCONSIN

ORDERED BY: COLONY REALTY

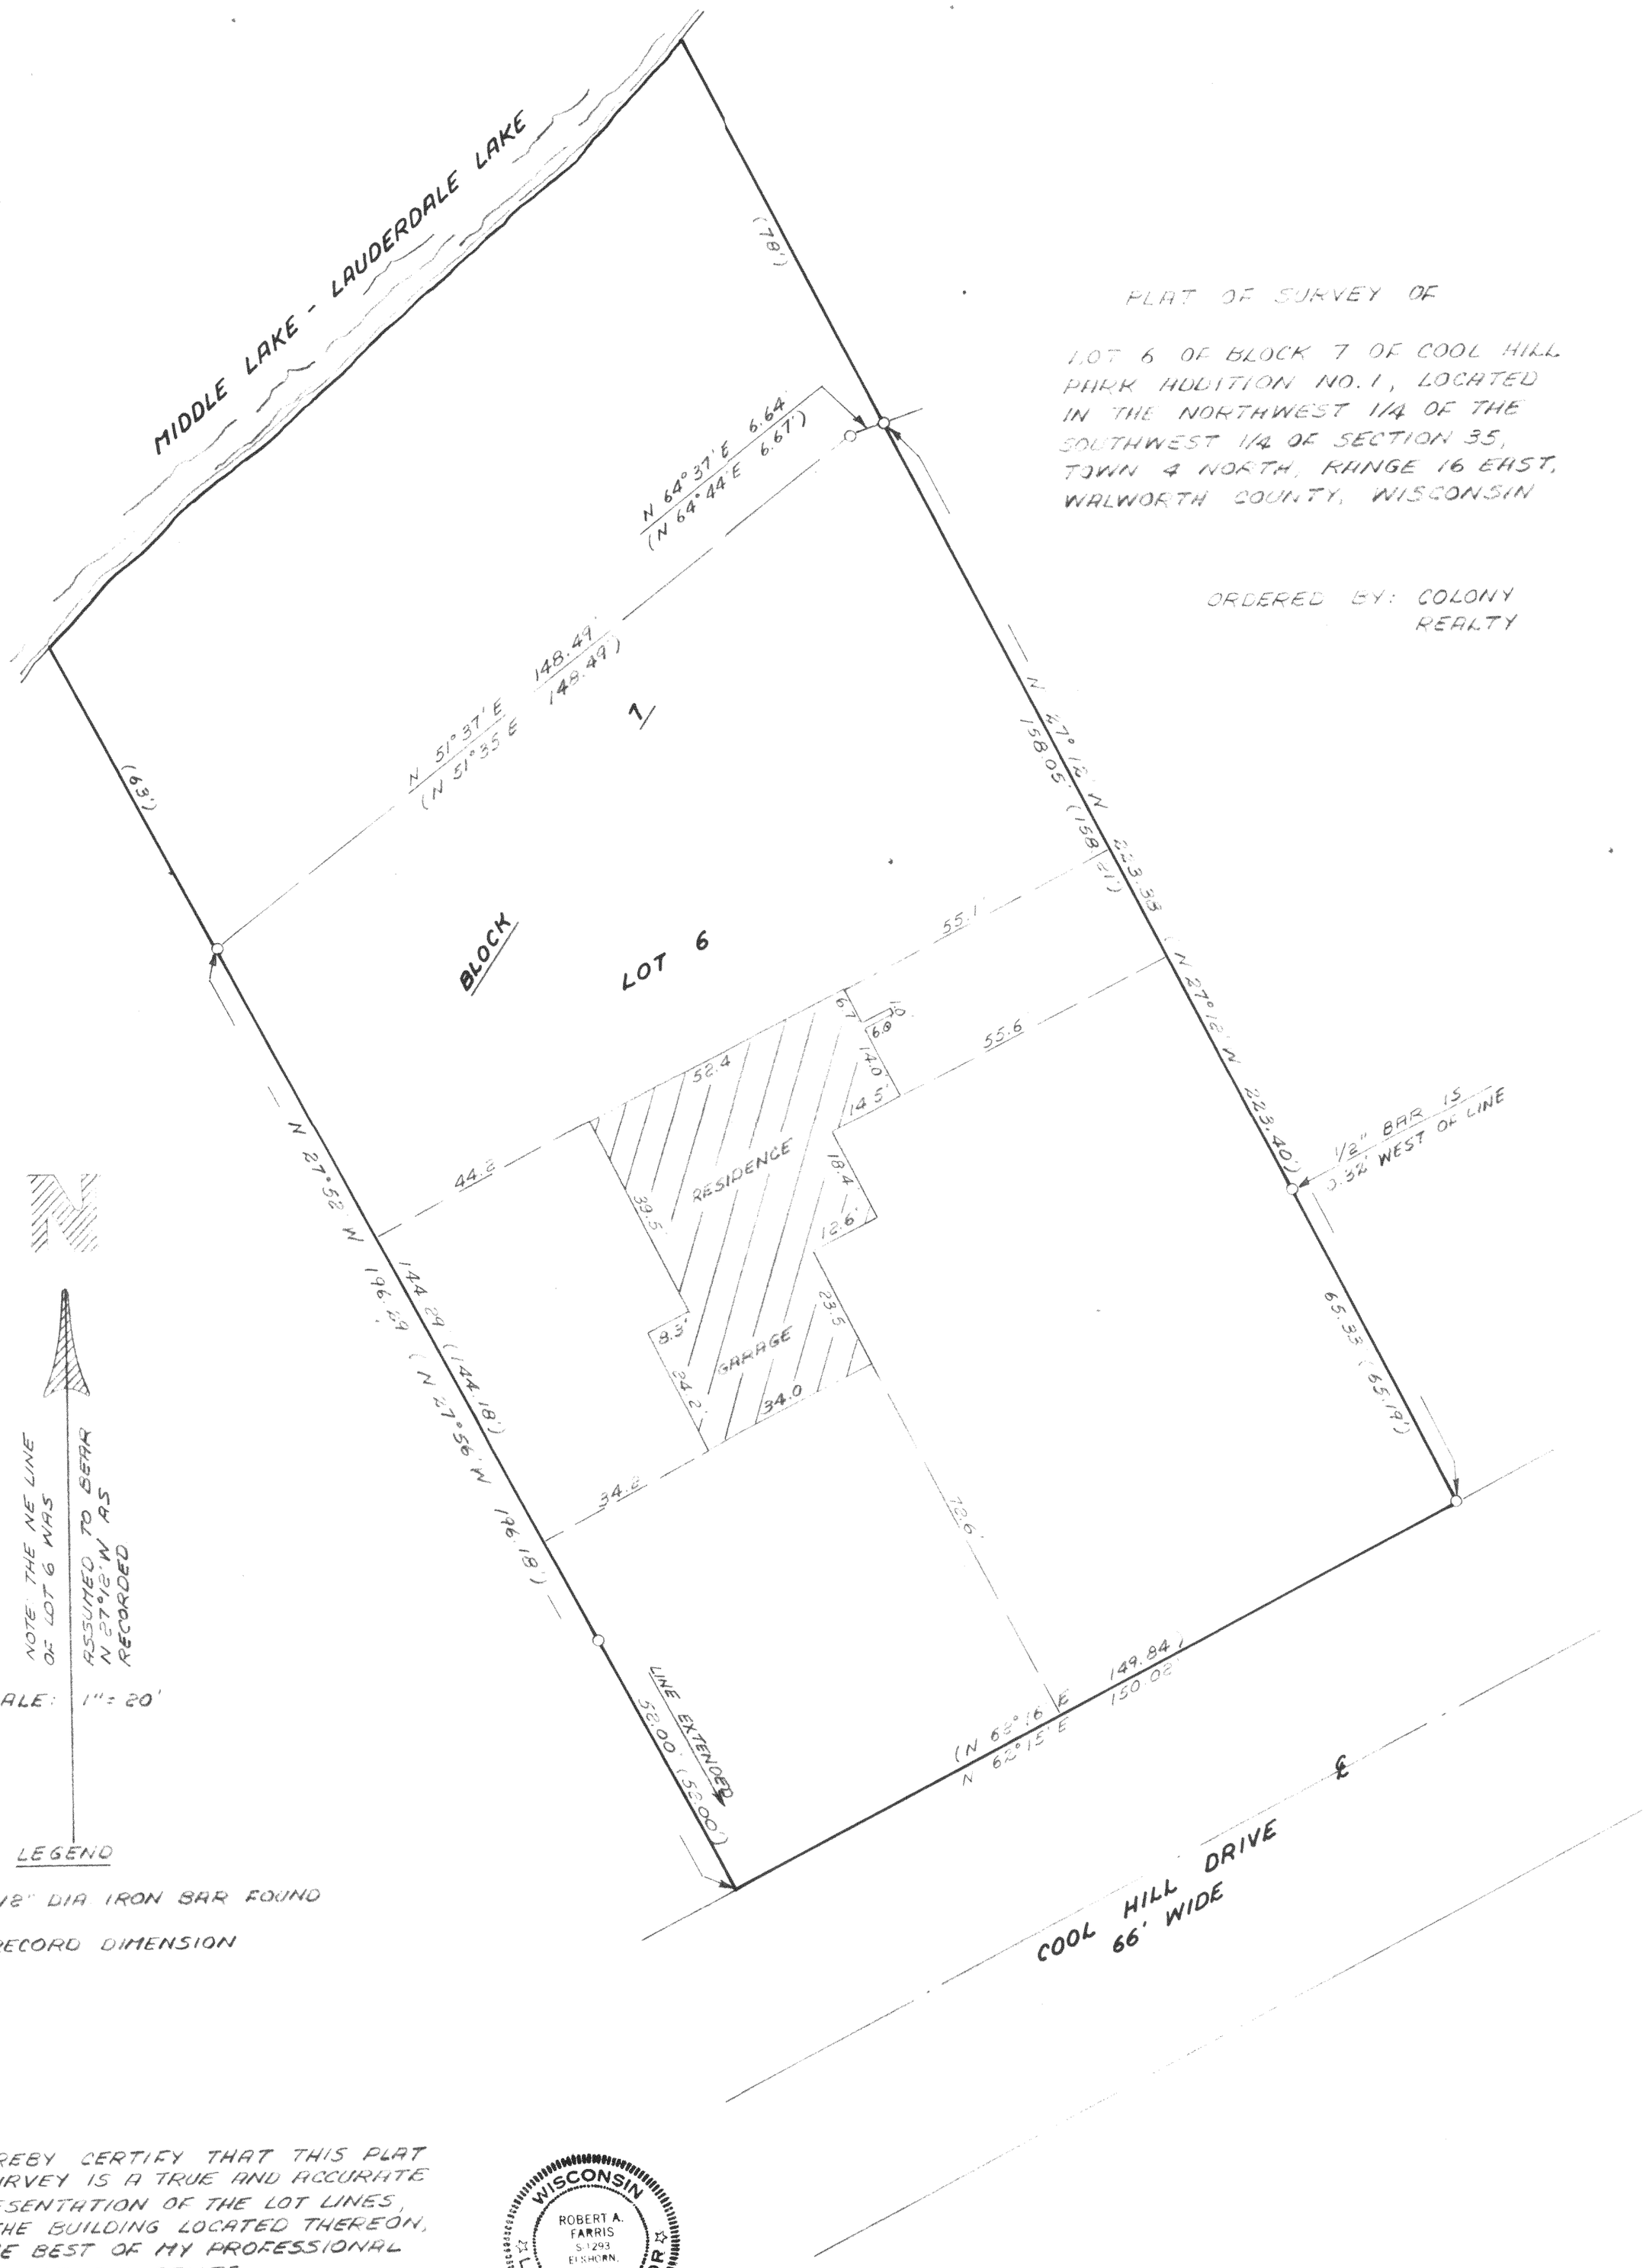

NOTE: THE NE LINE OF LOT 6 WAS ASSUMED TO BEAR N 27°12' W AS RECORDED

SCALE: 1" = 20'

LEGEND

O — 1/2" DIA. IRON BAR FOUND

( ) — RECORD DIMENSION

I HEREBY CERTIFY THAT THIS PLAT OF SURVEY IS A TRUE AND ACCURATE REPRESENTATION OF THE LOT LINES, AND THE BUILDING LOCATED THEREON, TO THE BEST OF MY PROFESSIONAL KNOWLEDGE AND BELIEF.

Robert A. Farris

ROBERT A FARRIS, RLS NO. 1293
DATED THIS 11th DAY OF July, 1983.

WISCONSIN
ROBERT A. FARRIS
S-1293
ELKHORN, WIS
LAND SURVEYOR

PROJECT NO. 2129
416-314-F

WCAH-9