
PLAT OF SURVEY

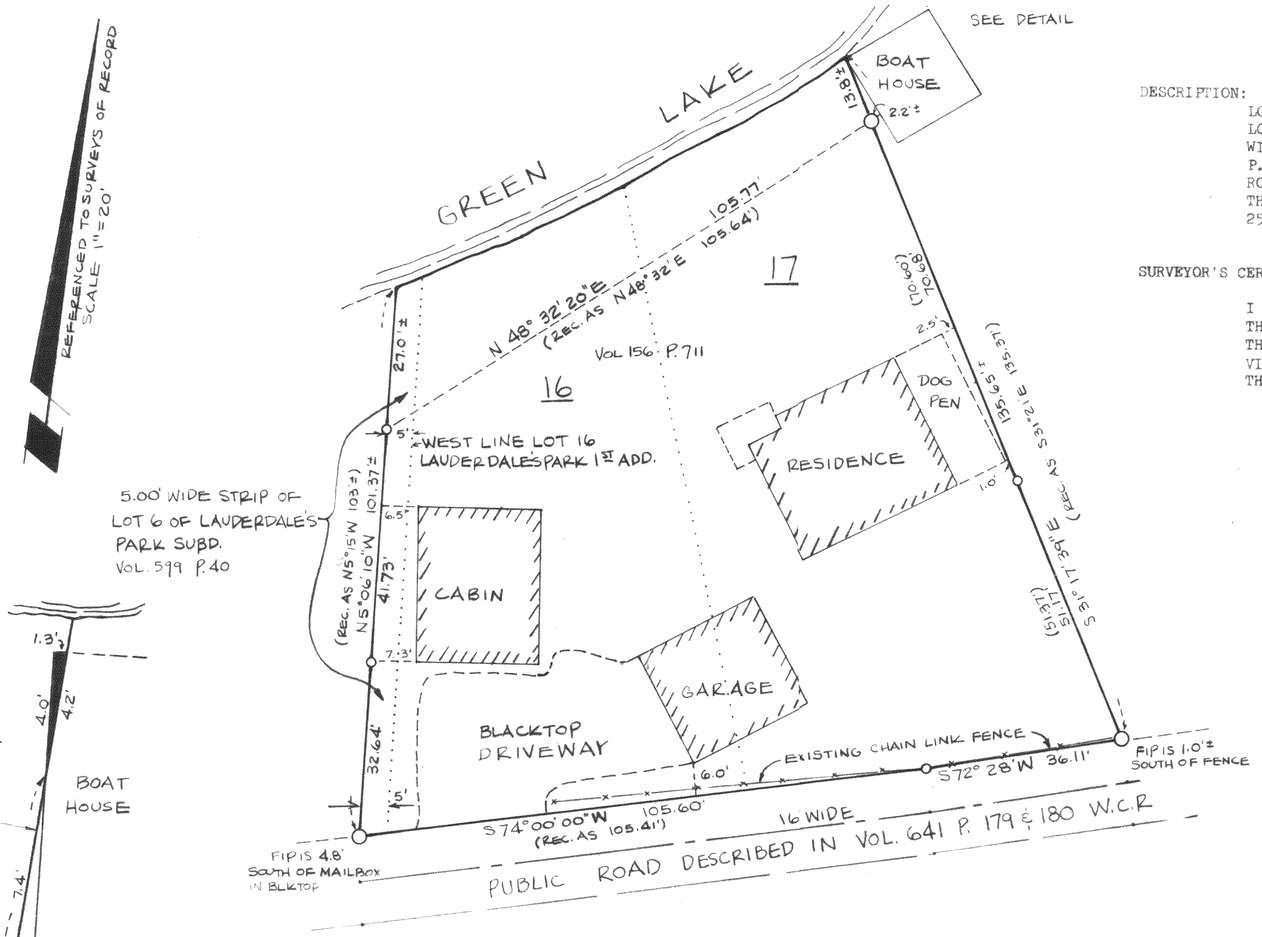

DESCRIPTION:

LOTS 16 AND 17 OF THE FIRST ADDITION TO LAUDERDALE'S PARK SUBDIVISION, LOCATED IN SECTION 25, TOWN 4 NORTH, RANGE 16 EAST, WALWORTH COUNTY, WISCONSIN, EXCEPTING THEREFROM A PARCEL OF LAND DESCRIBED IN VOL. 641, P. 179 of the WALWORTH COUNTY RECORDS; SAID PARCEL OF LAND TO BE USED FOR ROAD PURPOSES; ALSO THE EAST 5.00 FEET , AS MEASURED AT RIGHT ANGLES TO THE EAST LINE OF LOT 6 OF LAUDERDALE'S PARK SUBDIVISION, LOCATED IN SECTION 25, TOWN 4NORTH, RANGE 16 EAST, WALWORTH COUNTY, WISCONSIN.

SURVEYOR'S CERTIFICATE:

I HEREBY CERTIFY THAT I HAVE SURVEYED THE ABOVE DESCRIBED PROPERTY, THAT THE PLAT SHOWN HEREON IS AN ACCURATE SURVEY , A TRUE REPRESENTATION THEREOF, CORRECTLY SHOWS THE EXTERIOR BOUNDARY LINES, IMPROVEMENTS AND VISIBLE ENCROACHMENTS OF SAID PROPERTY AND THE CORRECT MEASUREMENTS THEREOF, TO THE BEST OF MY PROFESSIONAL BELIEF.

DATED THIS 8 DAY OF SEPTEMBER 1983

Kenneth B. Abernathy Jr.

KENNETH B. ABERNATHY JR. S- 1594

surveyed for; KEEFE REAL ESTATE
surveyed by; ABERNATHY AND ASSOCIATES
RT 3 BOX 273, ELKHORN, WIS. 723-4260

SCALE 1" = 20'

LEGEND

- O ~ 1" DIA. IRON PIPE FOUND
- O ~ 2" DIA. " " "
- ( ) ~ RECORD DIMENSION
- ▬ ~ ENCROACHMENT

TAX KEY NO. HLPA-6 & HLP-7A

CURRENT OWNERS: GEORGE & SHIRLEY NEVINS

WISCONSIN
KENNETH B. ABERNATHY, JR.
S-1594
ELKHORN, WI
LAND SURVEYOR

HLPA-6, HLP-7A

416-318-A ✓

#1983.901