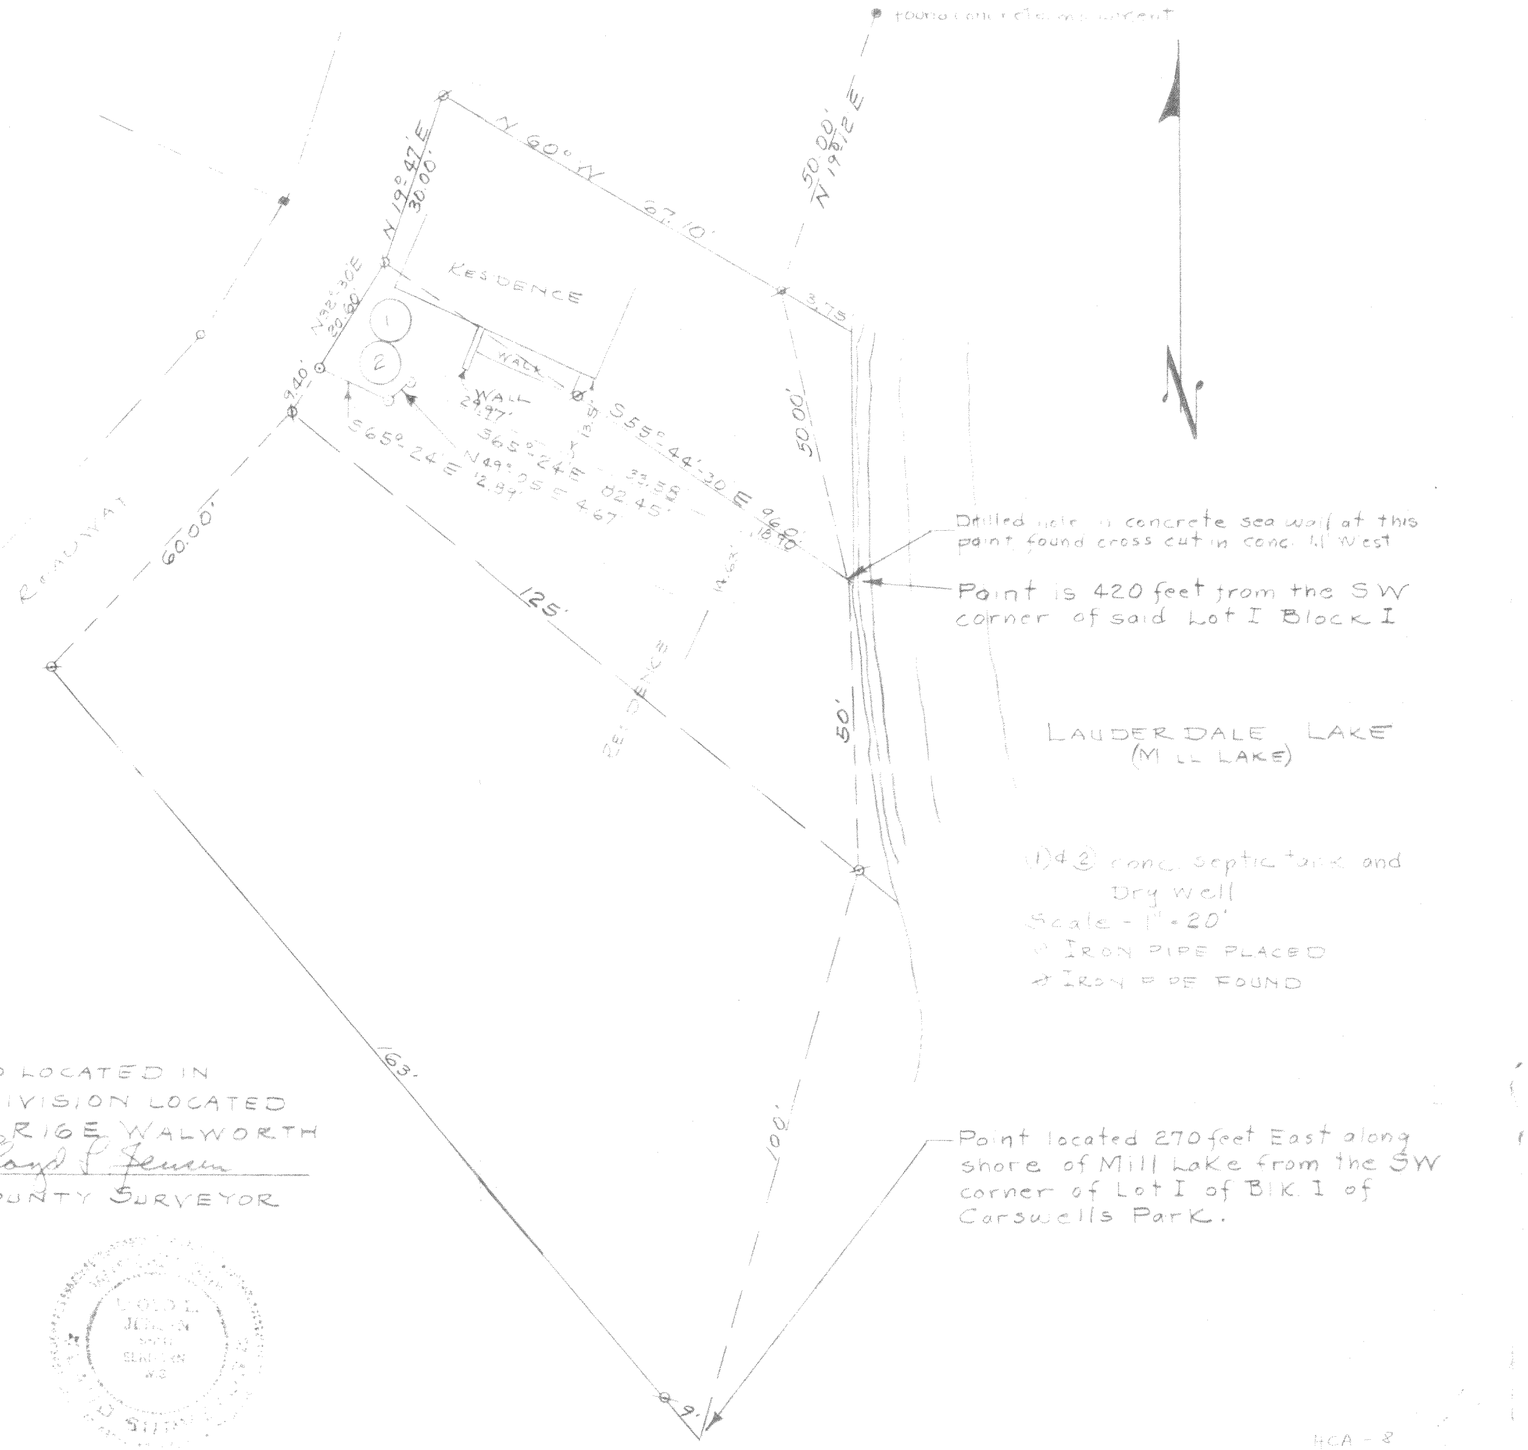



PLAT OF A SURVEY OF LAND LOCATED IN CARSWELLS PARK, A SUBDIVISION LOCATED IN SECTIONS 35 & 36 T4N R16E WALWORTH COUNTY WIS.
JUNE 1978

Lloyd P. Jensen
COUNTY SURVEYOR

HCA-8

416-320 J

The northerly line of the Kopeny property was assumed to bear N 60° W as recorded in earlier surveys in this area.

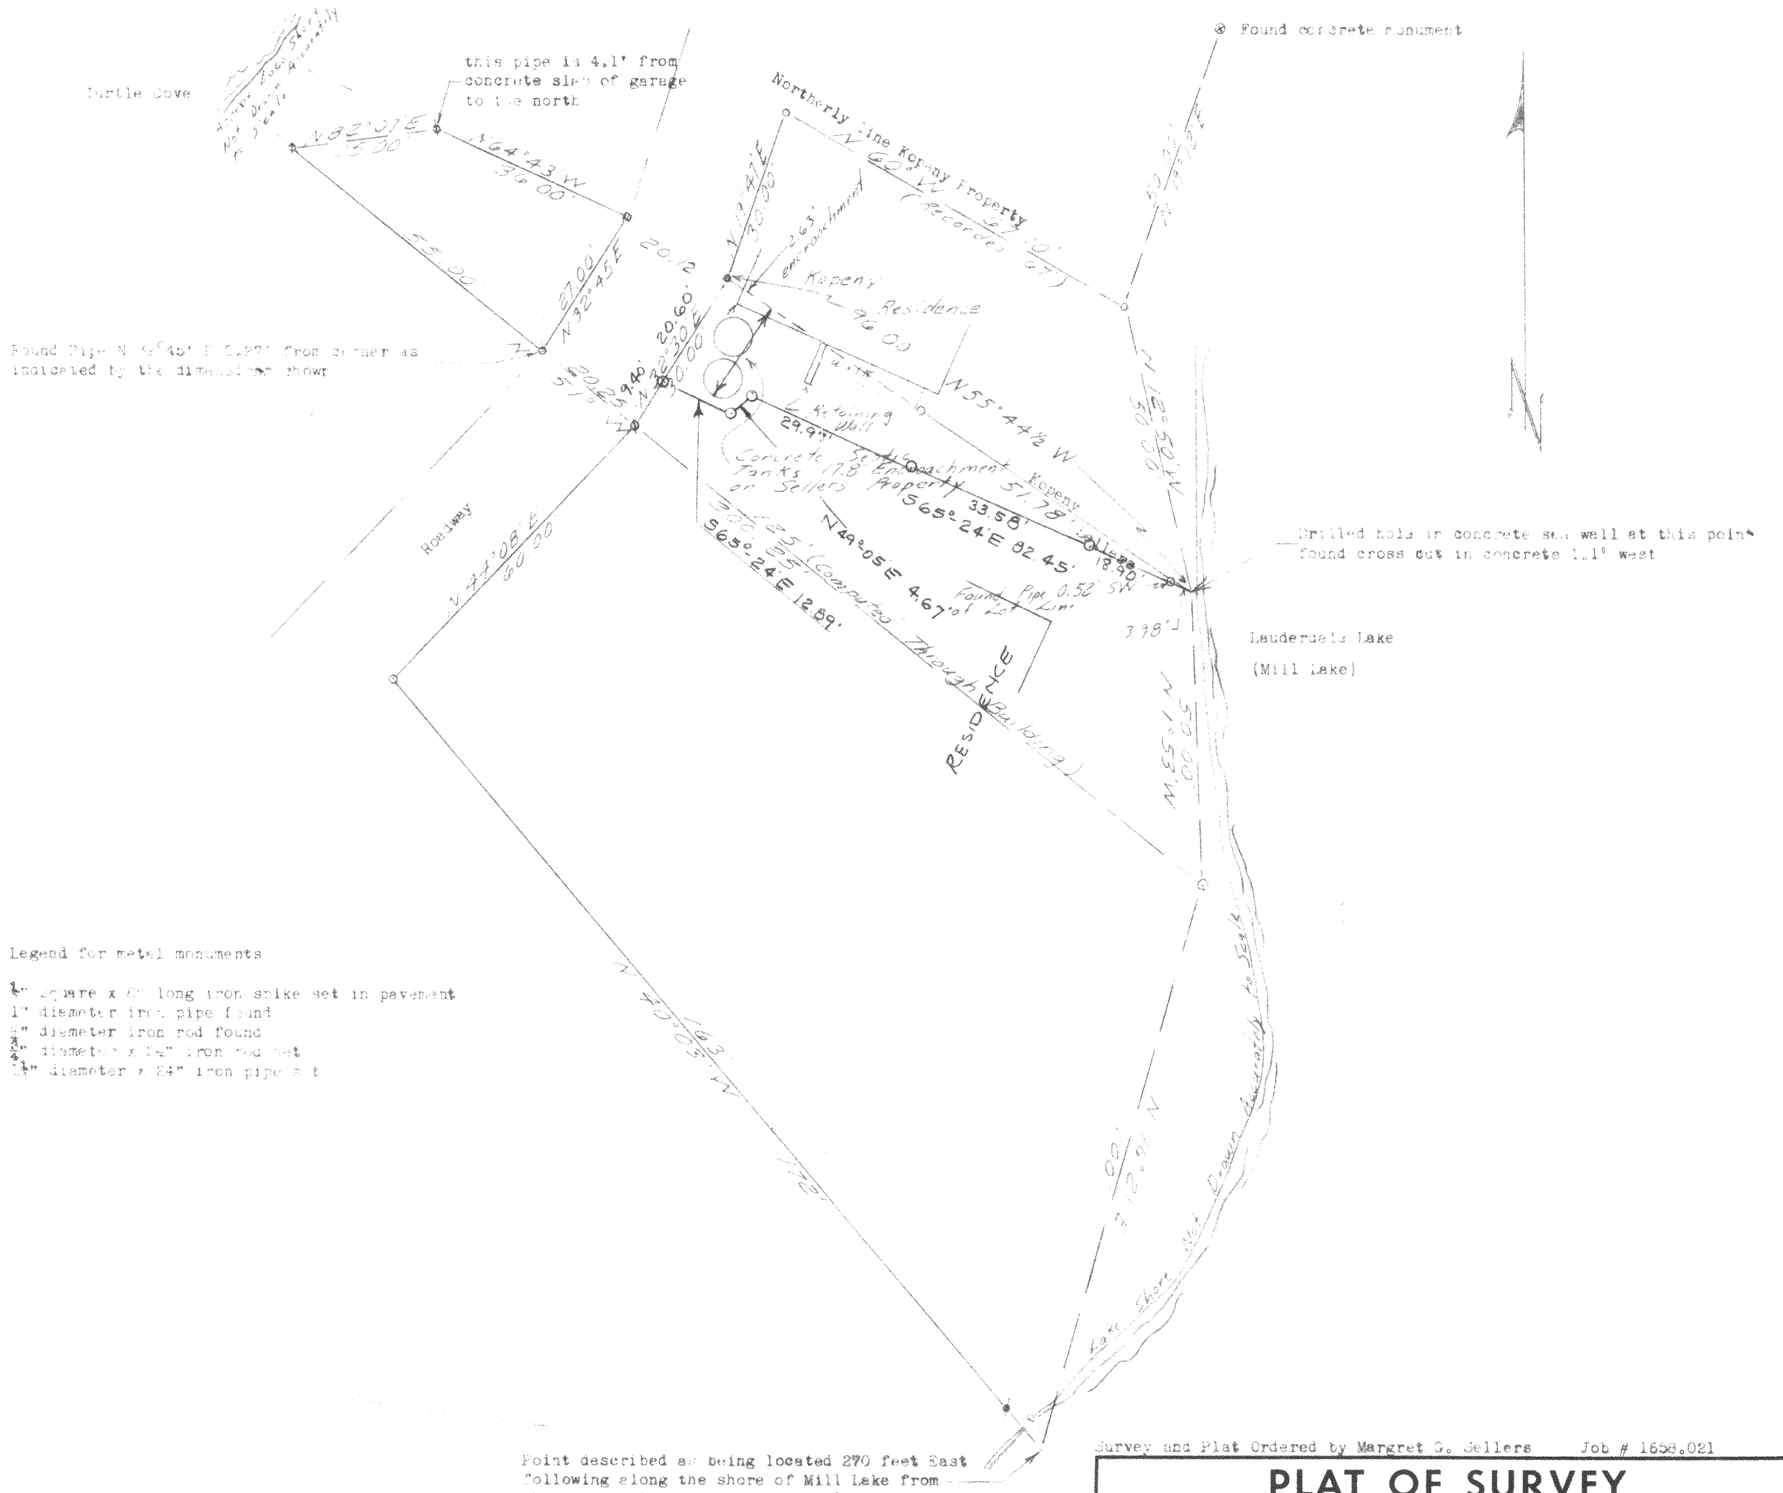

Legend for metal monuments

- ⊡ denotes ½" square x 24" long iron spike set in pavement
- o denotes 1" diameter iron pipe found
- ⚑ denotes ¾" diameter iron rod found
- • denotes ¾" diameter x 24" iron rod set
- ⊗ denotes 1¼" diameter x 24" iron pipe set

Point described as being located 270 feet East following along the shore of Mill Lake from the southwest corner of Lot No. 1 Block No. 1 of Carsewells Park

Survey and Plat Ordered by Margret G. Sellers Job # 1658.021

PLAT OF SURVEY
OF

Lands located in Carsewells Park, a subdivision located in sections 35 and 36, town 4 north, range 16 east, Walworth County, Wisconsin and being more particularly described in Volume 528 of deeds, page 393 as document #502120 -- Clifton to Sellers

I, Lloyd L. Jensen, surveyor, do hereby certify that under my direction the lands shown hereon have been surveyed and mapped, and that this Plat of Survey is a true and accurate representation of the lot lines to the best of my knowledge and belief.

Dated this 9th day of Sept., 1976
REVISED JUNE 1978

Lloyd L. Jensen S - 211

Lloyd L. Jensen
SURVEYOR

SCALE 1" = 30 feet

DATE Drafted 26 Aug. 1976
REVISED JUNE 1978 ~~#15~~ 253g

NCA-8

POST NO 175H 300 9-68

416-159