


PLAT OF SURVEY & TOPOGRAPHIC MAPPING
PART OF LOT 3 OF MORRIS PARK, A SUBDIVISION
LOCATED IN PART OF THE NE 1/4 & NW 1/4 OF THE SW 1/4 OF SECTION 26, TOWN 4 NORTH,
RANGE 16 EAST, WALWORTH COUNTY, WISCONSIN

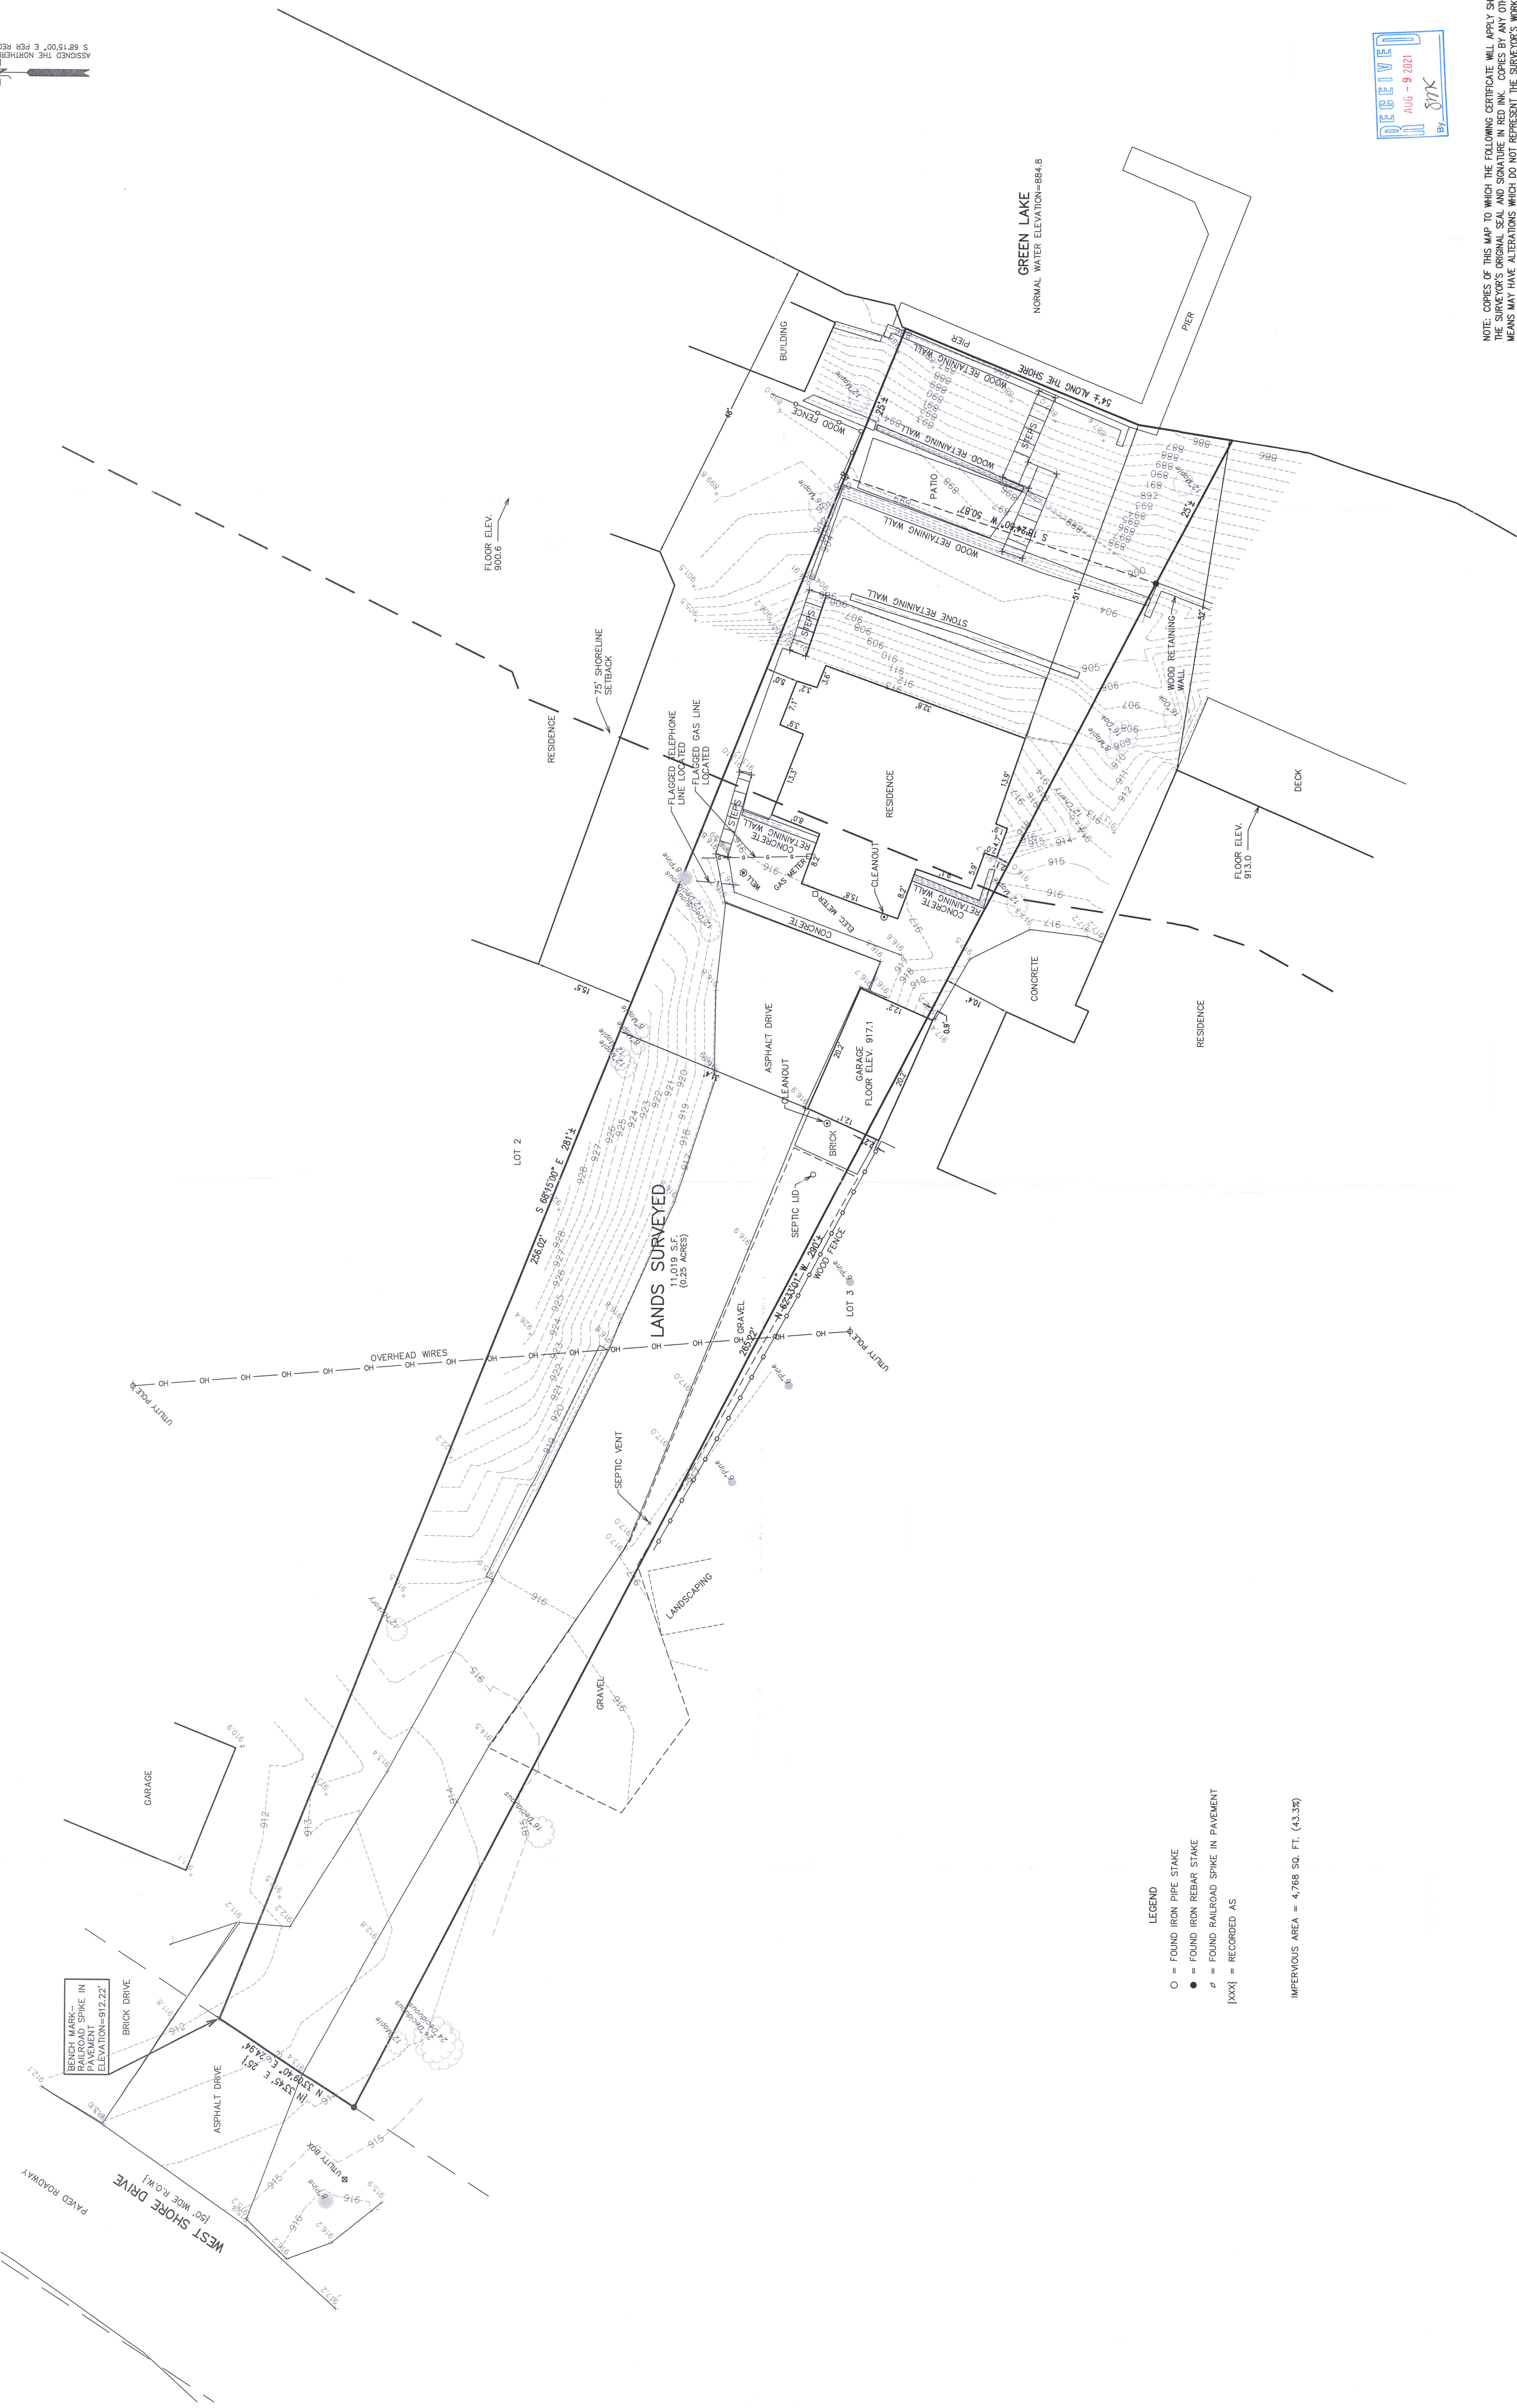

TOPOGRAPHIC SURVEY

W7906 WEST SHORE DRIVE
ELKHORN, WISCONSIN

WORK ORDERED BY -
STEVEN WAECHTE
2407 INDIAN GRASS ROAD
NAAPERVILLE, IL 60564

FARRIS, HANSEN & ASSOCIATES, INC.
ENGINEERING - ARCHITECTURE - SURVEYING
7 RIDGWAY COURT P.O. BOX 437
ELKHORN, WISCONSIN 53121
OFFICE: (262) 723-2098 FAX: (262) 723-5886

REVISIONS

PROJECT NO.
5347.21
DATE
06/01/2021
SHEET NO.
1 OF 1

NOTE: COPIES OF THIS MAP TO WHICH THE FOLLOWING CERTIFICATE WILL APPLY SHOW THE SURVEYOR'S ORIGINAL SIGNATURE AND SEAL. ANY COPIES BY ANY OTHER MEANS MAY HAVE ALTERATIONS WHICH DO NOT REPRESENT THE SURVEYOR'S WORK PRODUCT.

I HEREBY CERTIFY THAT THE ABOVE DESCRIBED PROPERTY HAS BEEN SURVEYED UNDER MY DIRECTION AND THAT THE ABOVE MAP IS A TRUE REPRESENTATION THEREOF AND SHOWS THE SIZE AND LOCATION OF THE PROPERTY AND ITS EXTERIOR BOUNDARIES. THIS SURVEY IS MADE FOR THE USE OF THE PRESENT OWNERS OF THE PROPERTY AND NO GUARANTEE OF ACCURACY OR GUARANTEE OF THE TITLE THERETO WITHIN ONE YEAR FROM THE DATE HEREOF.

DATE: 6/1/2021

CHRISTOPHER A. HODGES P.L.S. 2760



- LEGEND
- O = FOUND IRON PIPE STAKE
 - = FOUND IRON REBAR STAKE
 - σ = FOUND RAILROAD SPIKE IN PAVEMENT
 - {XXX} = RECORDED AS

IMPERVIOUS AREA = 4,768 SQ. FT. (43.3%)



TMP-2