PLAT OF SURVEY

OF LOT 2 FIELDS SUBDIVISION, LOCATED IN THE SE ¼ OF THE N.E. ¼ OF SECTION 26, T4N, R16E, WALWORTH CO., WIS.

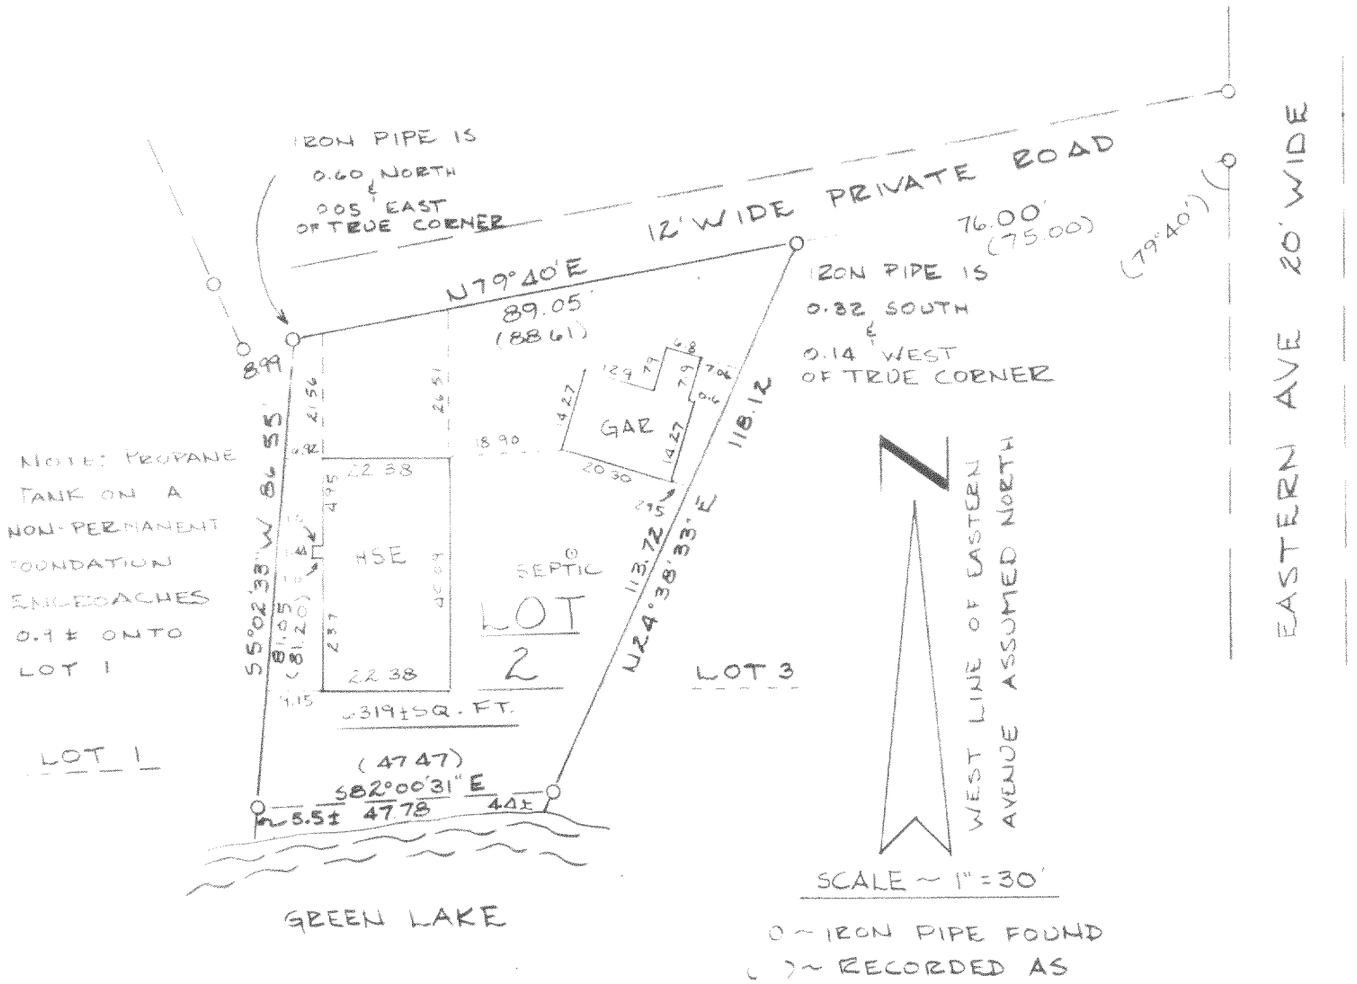

O ~ IRON PIPE FOUND
( ) ~ RECORDED AS

I HEREBY CERTIFY THAT THE ABOVE DESCRIBED PROPERTY HAS BEEN SURVEYED UNDER MY DIRECTION, THAT THE PLAT SHOWN HEREON IS AN ACCURATE SURVEY, A TRUE REPRESENTATION THEREOF, CORRECTLY SHOWS THE EXTERIOR BOUNDARY LINES ON SAID PROPERTY AND THE CORRECT MEASUREMENTS THEREOF AND THE BUILDINGS THEREON.

WISCONSIN
THOMAS P. A. JENSEN
S-1084
ELKHORN, WIS.
LAND SURVEYOR

THOMAS P.A. JENSEN R.L.S. # 1084

JENSEN SURVEYING
&
MAPPING S.C.
P.O. BOX 322
ELKHORN, WI. 53121
(414) 723-3434

1984.005
HFH-2

416-327-J