
PLAT OF SURVEY & TOPOGRAPHIC MAPPING
LOT 2 OF BAYWOOD ESTATES, A SUBDIVISION

LOCATED IN PART OF THE NE 1/4 OF THE NW 1/4 OF SECTION 1, TOWN 3 NORTH, RANGE 16 EAST AND IN PART OF THE SE 1/4 OF THE SW 1/4 OF SECTION 36, TOWN 4 NORTH, RANGE 16 EAST, WALWORTH COUNTY, WISCONSIN

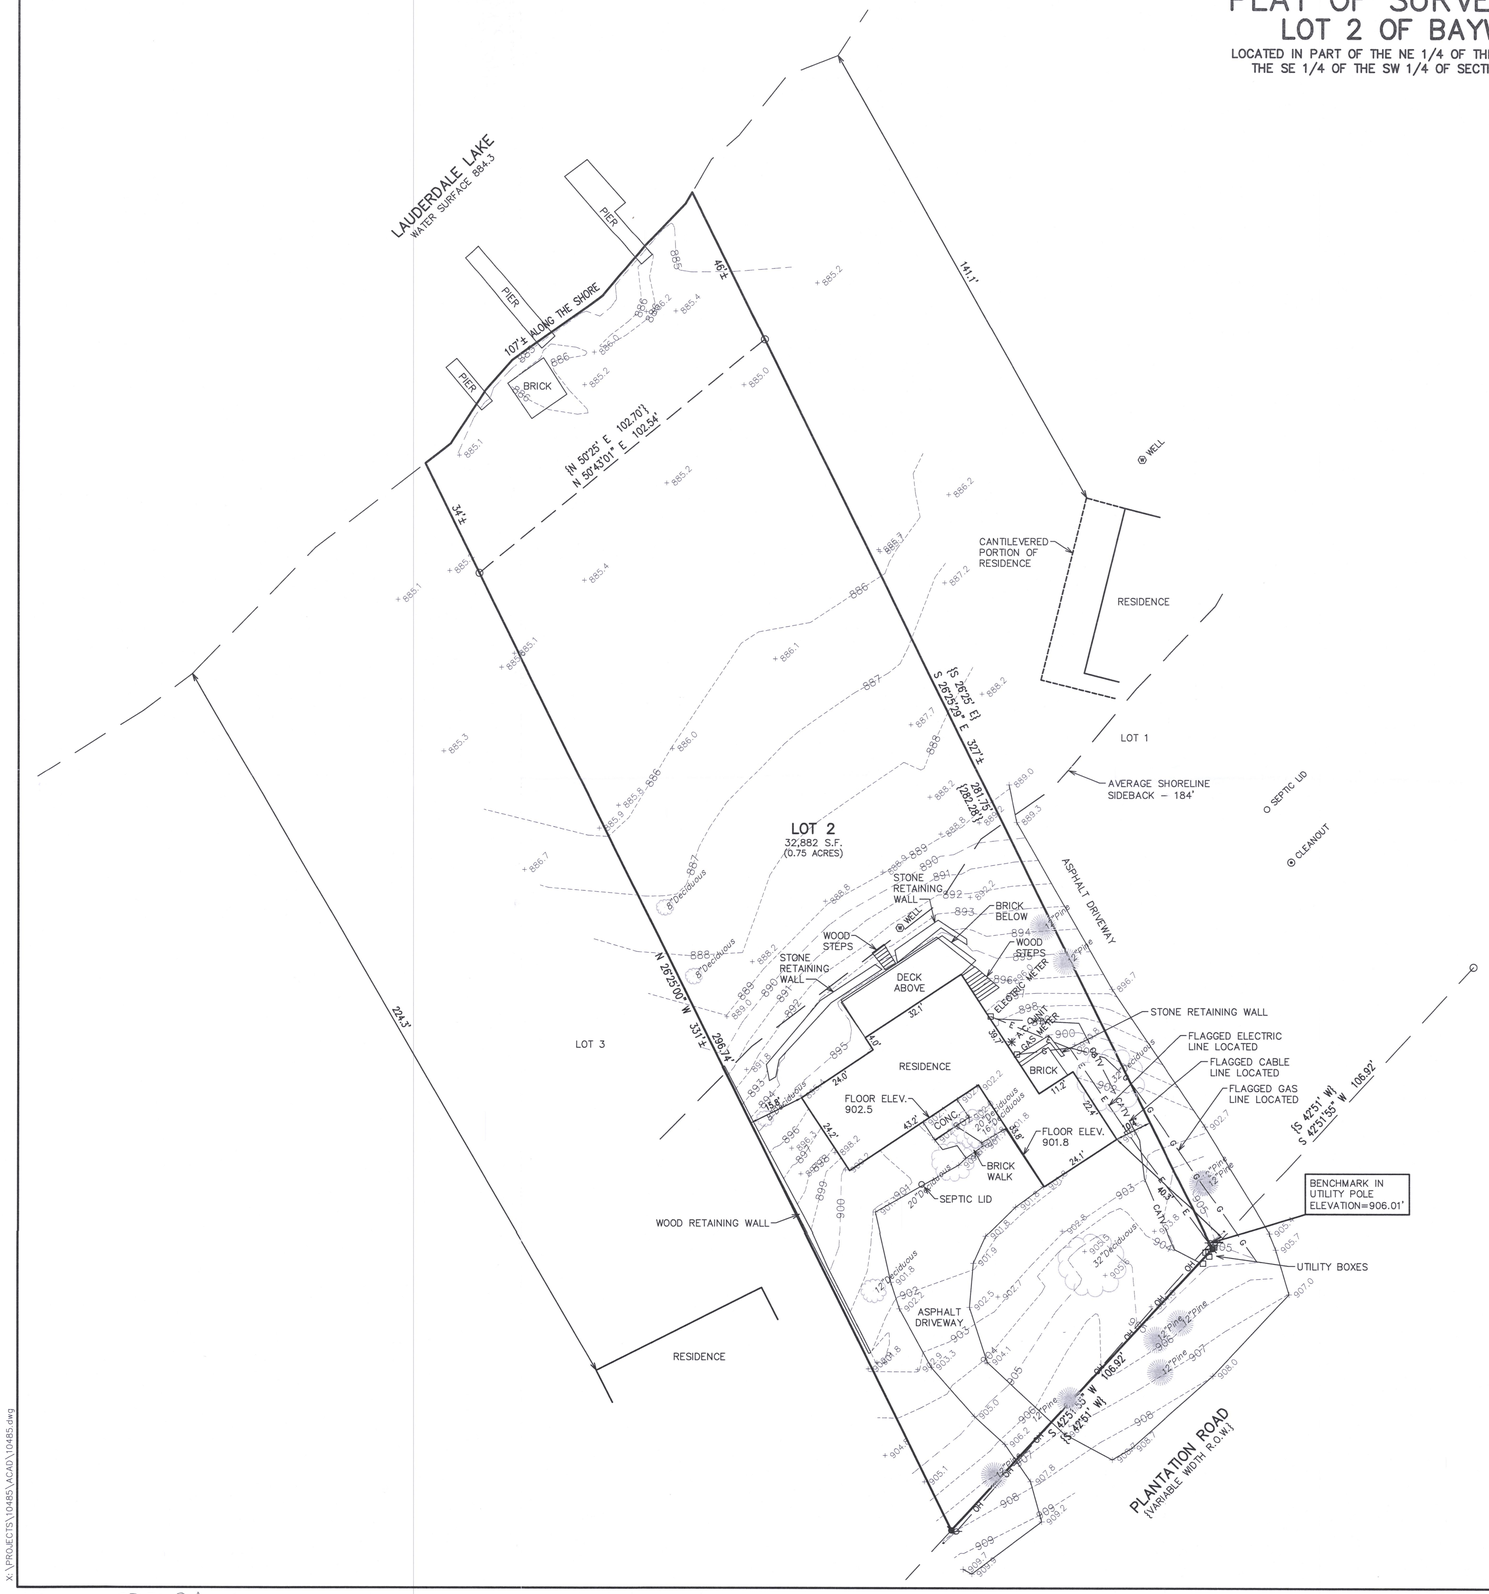





LEGEND

- O = FOUND IRON PIPE STAKE
- = SET IRON REBAR STAKE
- = UTILITY POLE LOCATED
- = GUY WIRE LOCATED
- OH — = OVERHEAD WIRES
- {XXX} = RECORDED AS

RECEIVED
SEP - 7 2021
BY

NOTE: COPIES OF THIS MAP TO WHICH THE FOLLOWING CERTIFICATE WILL APPLY SHOW THE SURVEYOR'S ORIGINAL SEAL AND SIGNATURE IN RED INK. COPIES BY ANY OTHER MEANS MAY HAVE ALTERATIONS WHICH DO NOT REPRESENT THE SURVEYOR'S WORK PRODUCT.

I HEREBY CERTIFY THAT THE ABOVE DESCRIBED PROPERTY HAS BEEN SURVEYED UNDER MY DIRECTION AND THAT THE ABOVE MAP IS A TRUE REPRESENTATION THEREOF AND SHOWS THE SIZE AND LOCATION OF THE PROPERTY AND ITS EXTERIOR BOUNDARIES. THIS SURVEY IS MADE FOR THE USE OF THE PRESENT OWNERS OF THE PROPERTY, AND ALSO THOSE WHO PURCHASE, MORTGAGE, OR GUARANTEE THE TITLE THERETO WITHIN ONE YEAR FROM THE DATE HEREOF.

WISCONSIN
CHRISTOPHER A HODGES
2760
PALMYRA
WIS.
LAND SURVEYOR

DATED: 7/26/2021

CHRISTOPHER A. HODGES P.L.S. 2760

TOPOGRAPHIC SURVEY

W5190 PLANTATION ROAD
ELKHORN, WISCONSIN

– WORK ORDERED BY –
KEN & KATHY KLANCNIK
527 S. BRIGHTON LANE
PALATINE, IL 60067

FARRIS, HANSEN & ASSOCIATES, INC.
ENGINEERING – ARCHITECTURE – SURVEYING
7 RIDGWAY COURT P.O. BOX 437
ELKHORN, WISCONSIN 53121
OFFICE: (262) 723-2098 FAX: (262) 723-5886

REVISIONS

PROJECT NO.
10485

DATE
07/26/2021

SHEET NO.
1 OF 1

X:\PROJECTS\10485\ACAD\10485.dwg

HBE-2, GBE-2A

4116-3289