Farris, Hansen & Associates, Inc.
Engineering, Surveying & Land Planning
P.O. BOX 487
715 W. WALWORTH STREET
ELKHORN, WISCONSIN 53121

PLAT OF SURVEY OF

Lot 71, Bubbling Springs 1st Addition,
Town of LaGrange, Walworth County, Wisconsin.


Work Ordered By:

Bob Rogowski
1840 W. 22nd Pl
Chicago, IL 60608

LEGEND

○ - 2" Iron Pipe Found

() - Record Dimension

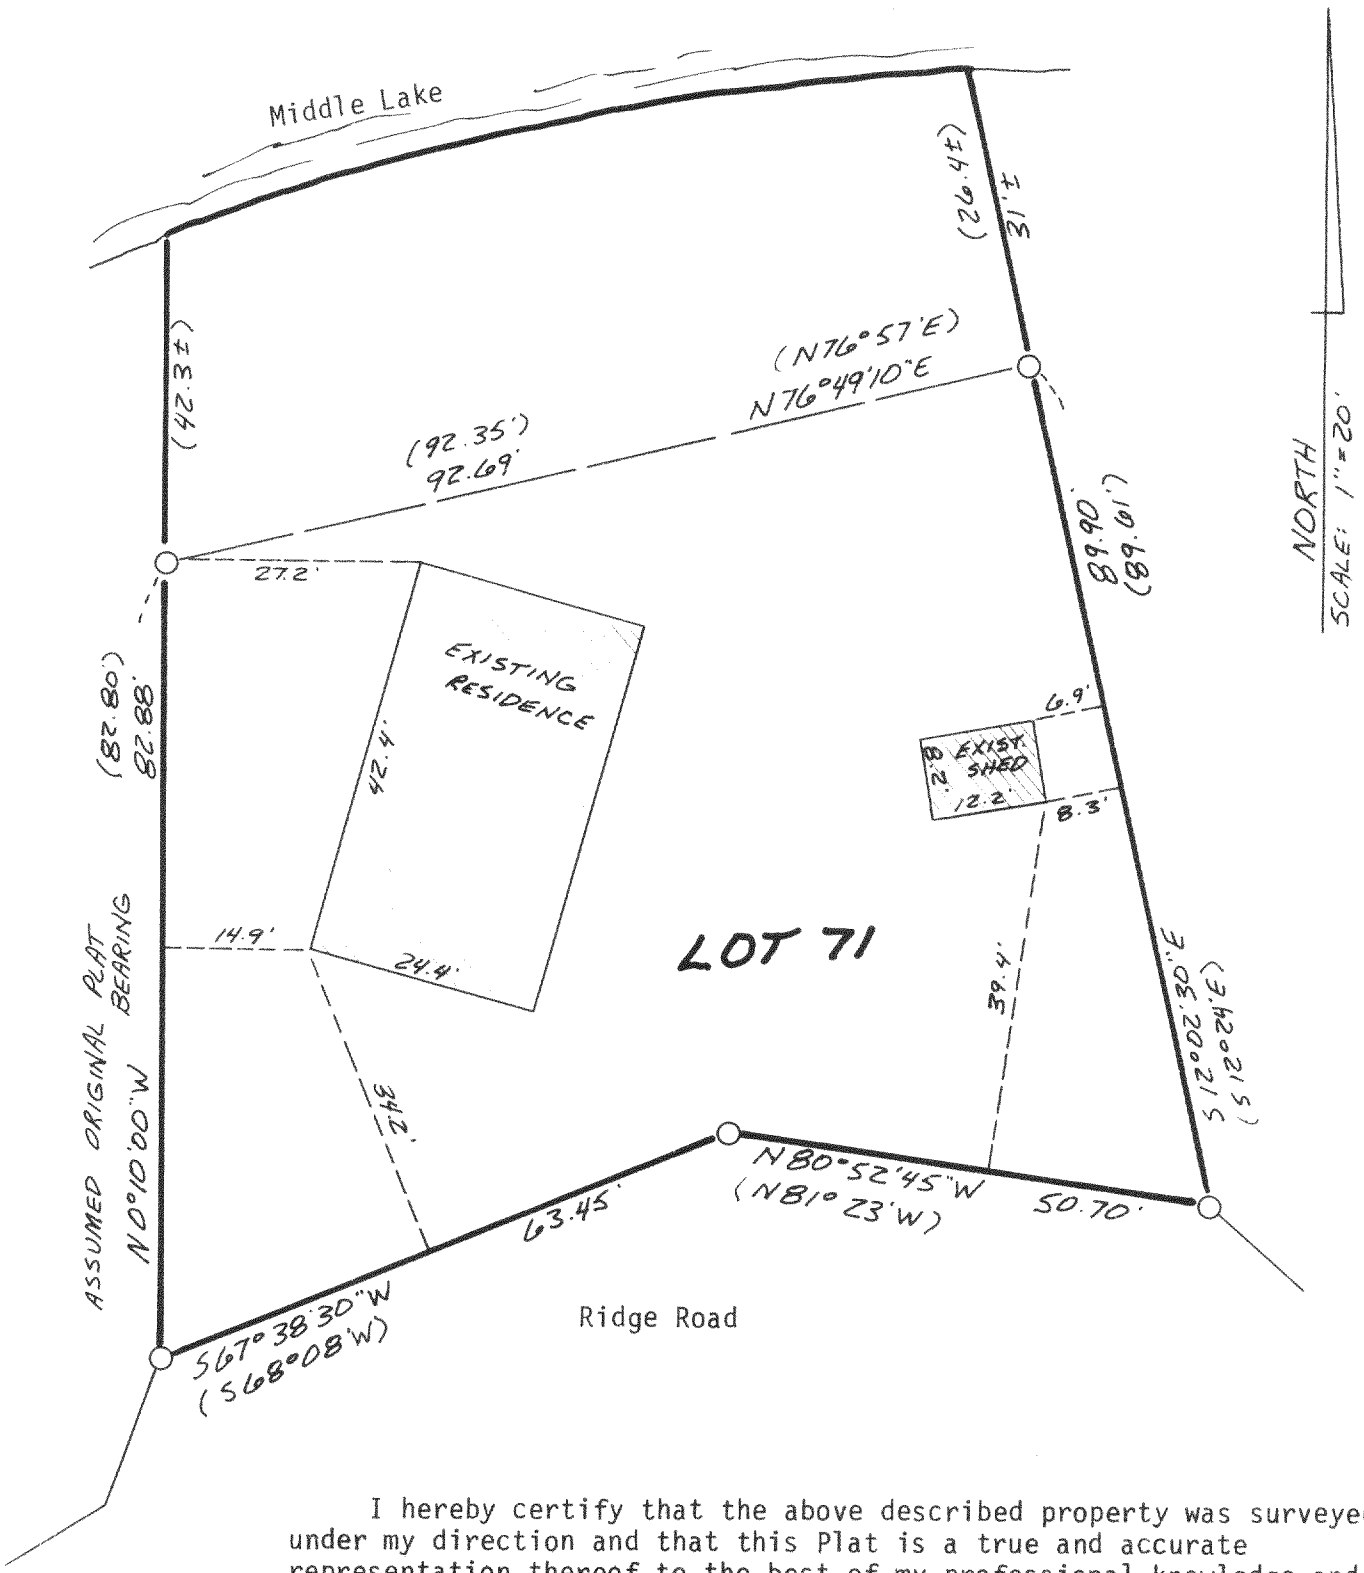

I hereby certify that the above described property was surveyed under my direction and that this Plat is a true and accurate representation thereof to the best of my professional knowledge and belief.

Robert A. Farris, R.L.S.

Dated this 29th day of June, 1984

WISCONSIN
ROBERT A FARRIS
S-1293
ELKHORN WIS
LAND SURVEYOR

Sheet 1 of 1

PROJECT #2279

HBS1-40

416-328-F