PLAT OF SURVEY

LOT 7 OF BLOCK 7 OF COOL HILL PARK ADDITION NO. 1, LOCATED IN THE NORTHWEST $\frac{1}{4}$ OF THE SOUTHWEST $\frac{1}{4}$ OF SECTION 35, TOWN 4 NORTH, RANGE 16 EAST, WALWORTH COUNTY, WISCONSIN

SURVEYOR'S CERTIFICATE:

I hereby certify that, I have surveyed the above described property, that the plat shown hereon is an accurate survey, a true representation thereof, correctly shows the exterior boundaries, and the correct measurements thereof, and correctly shows the improvements thereon, to the best of my professional knowledge and belief.


ORDERED BY-- KEEFE REALTORS, Elkhorn, Wis.
JOHN LAW REALTORS, Lake Geneva, Wis.

Kenneth B. Abernathy Jr.
Wis. Reg. No. S-1594
6/20/84

Abernathy and Associates
Rt.3 Box 273
Elkhorn, Wis. 53121
(414) 723-4260

PLATTED NORTH

SCALE 1"=40'

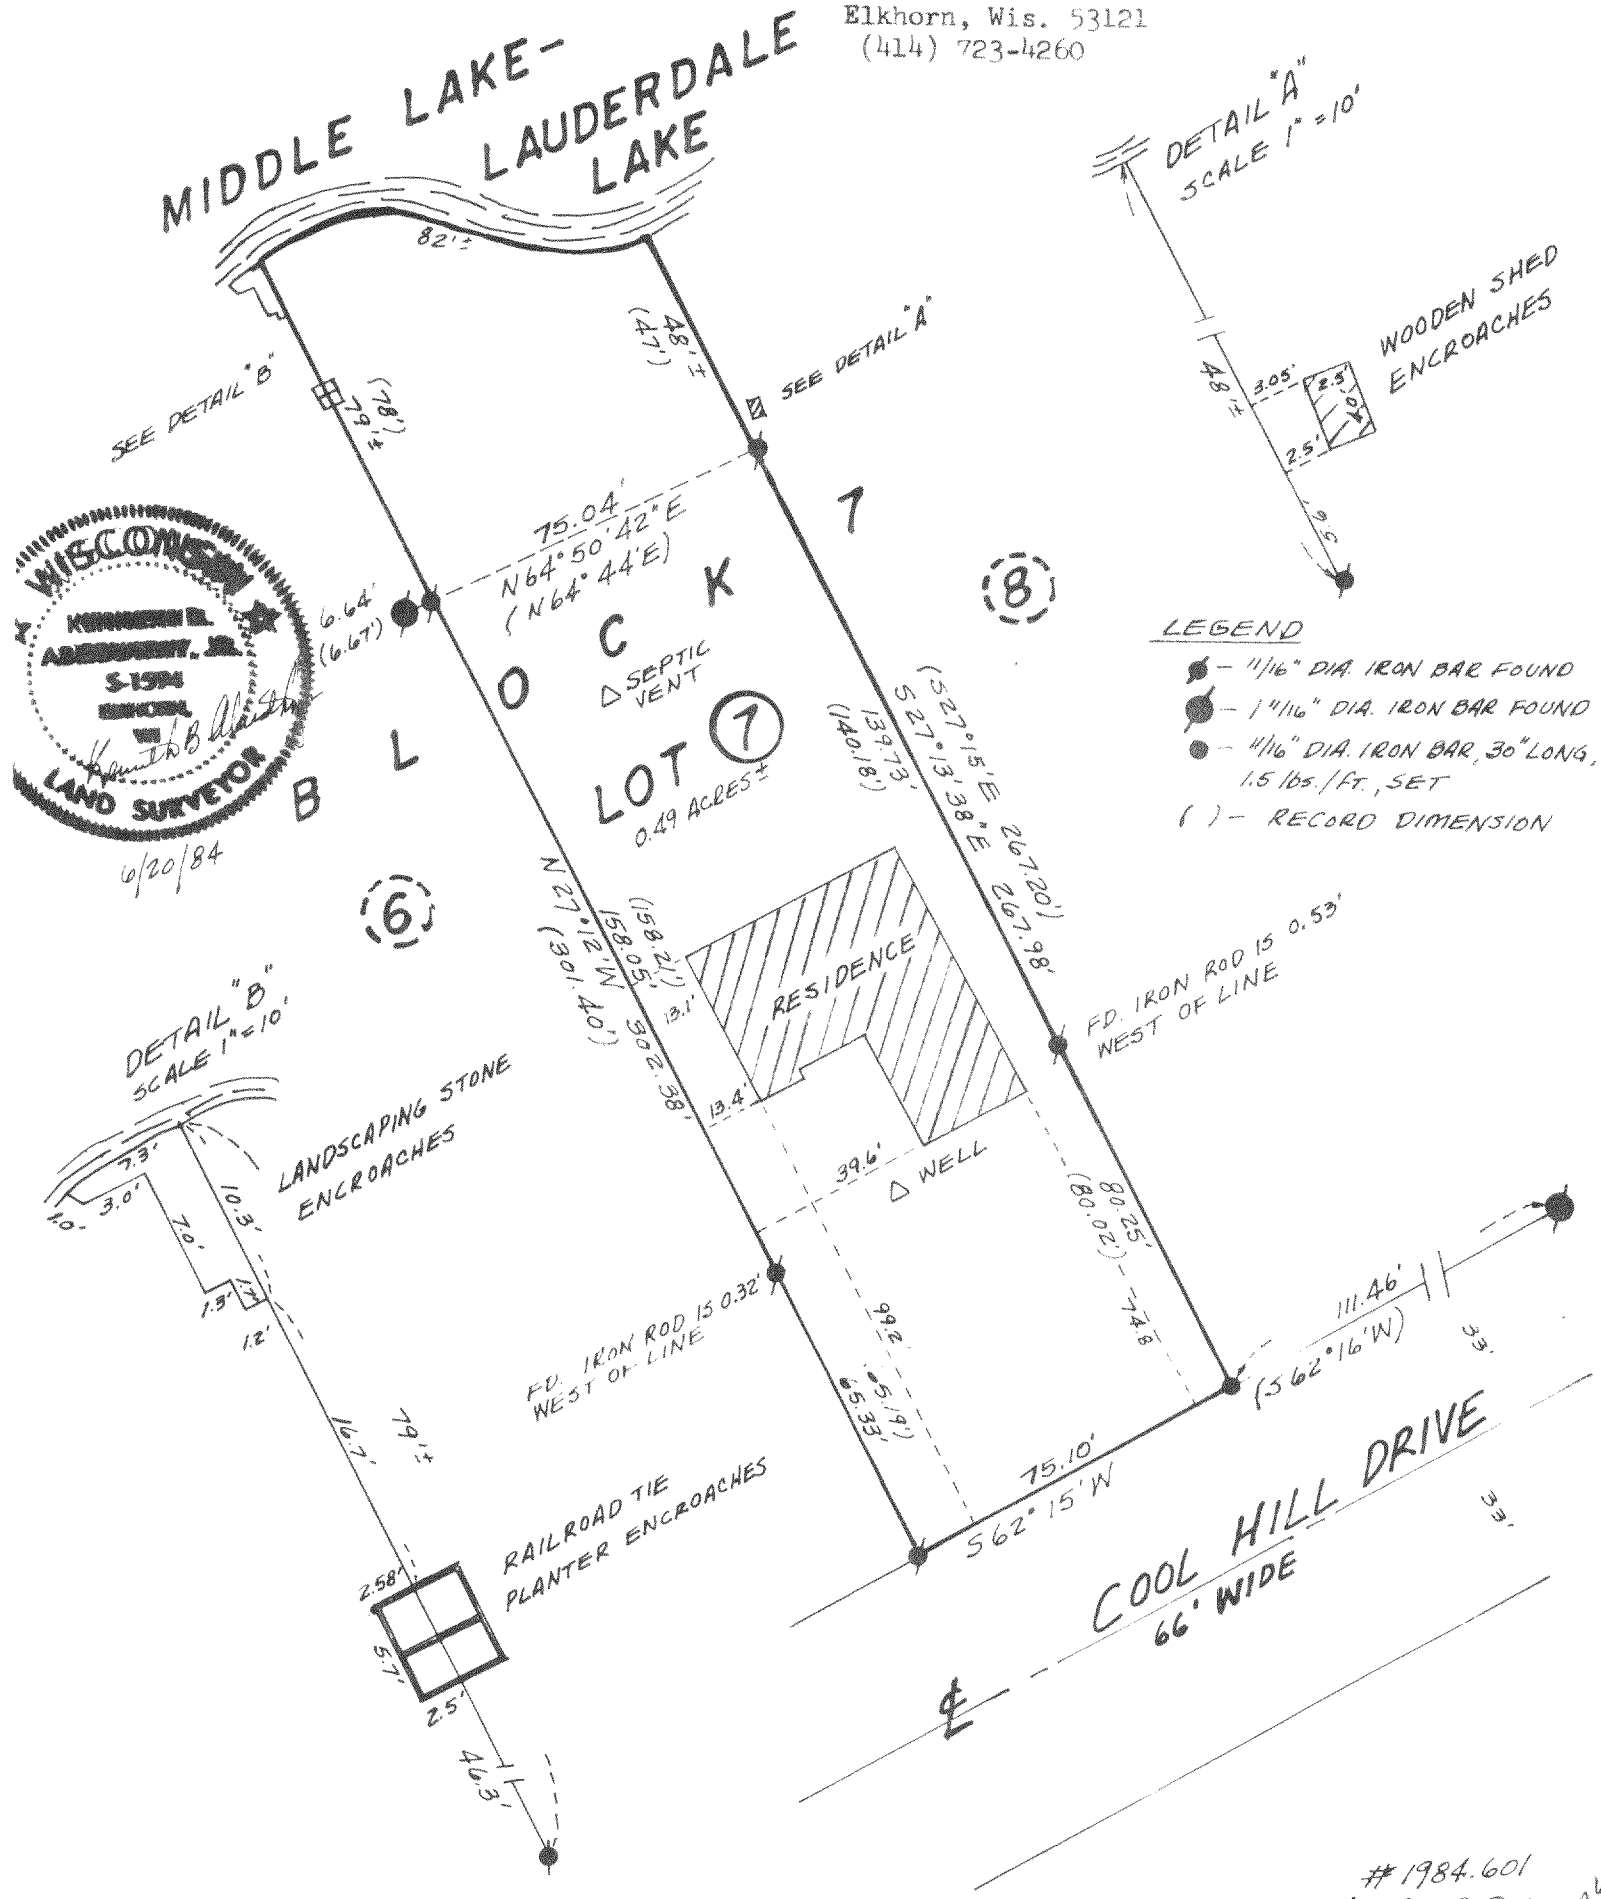

#1984.601
416-330-A