
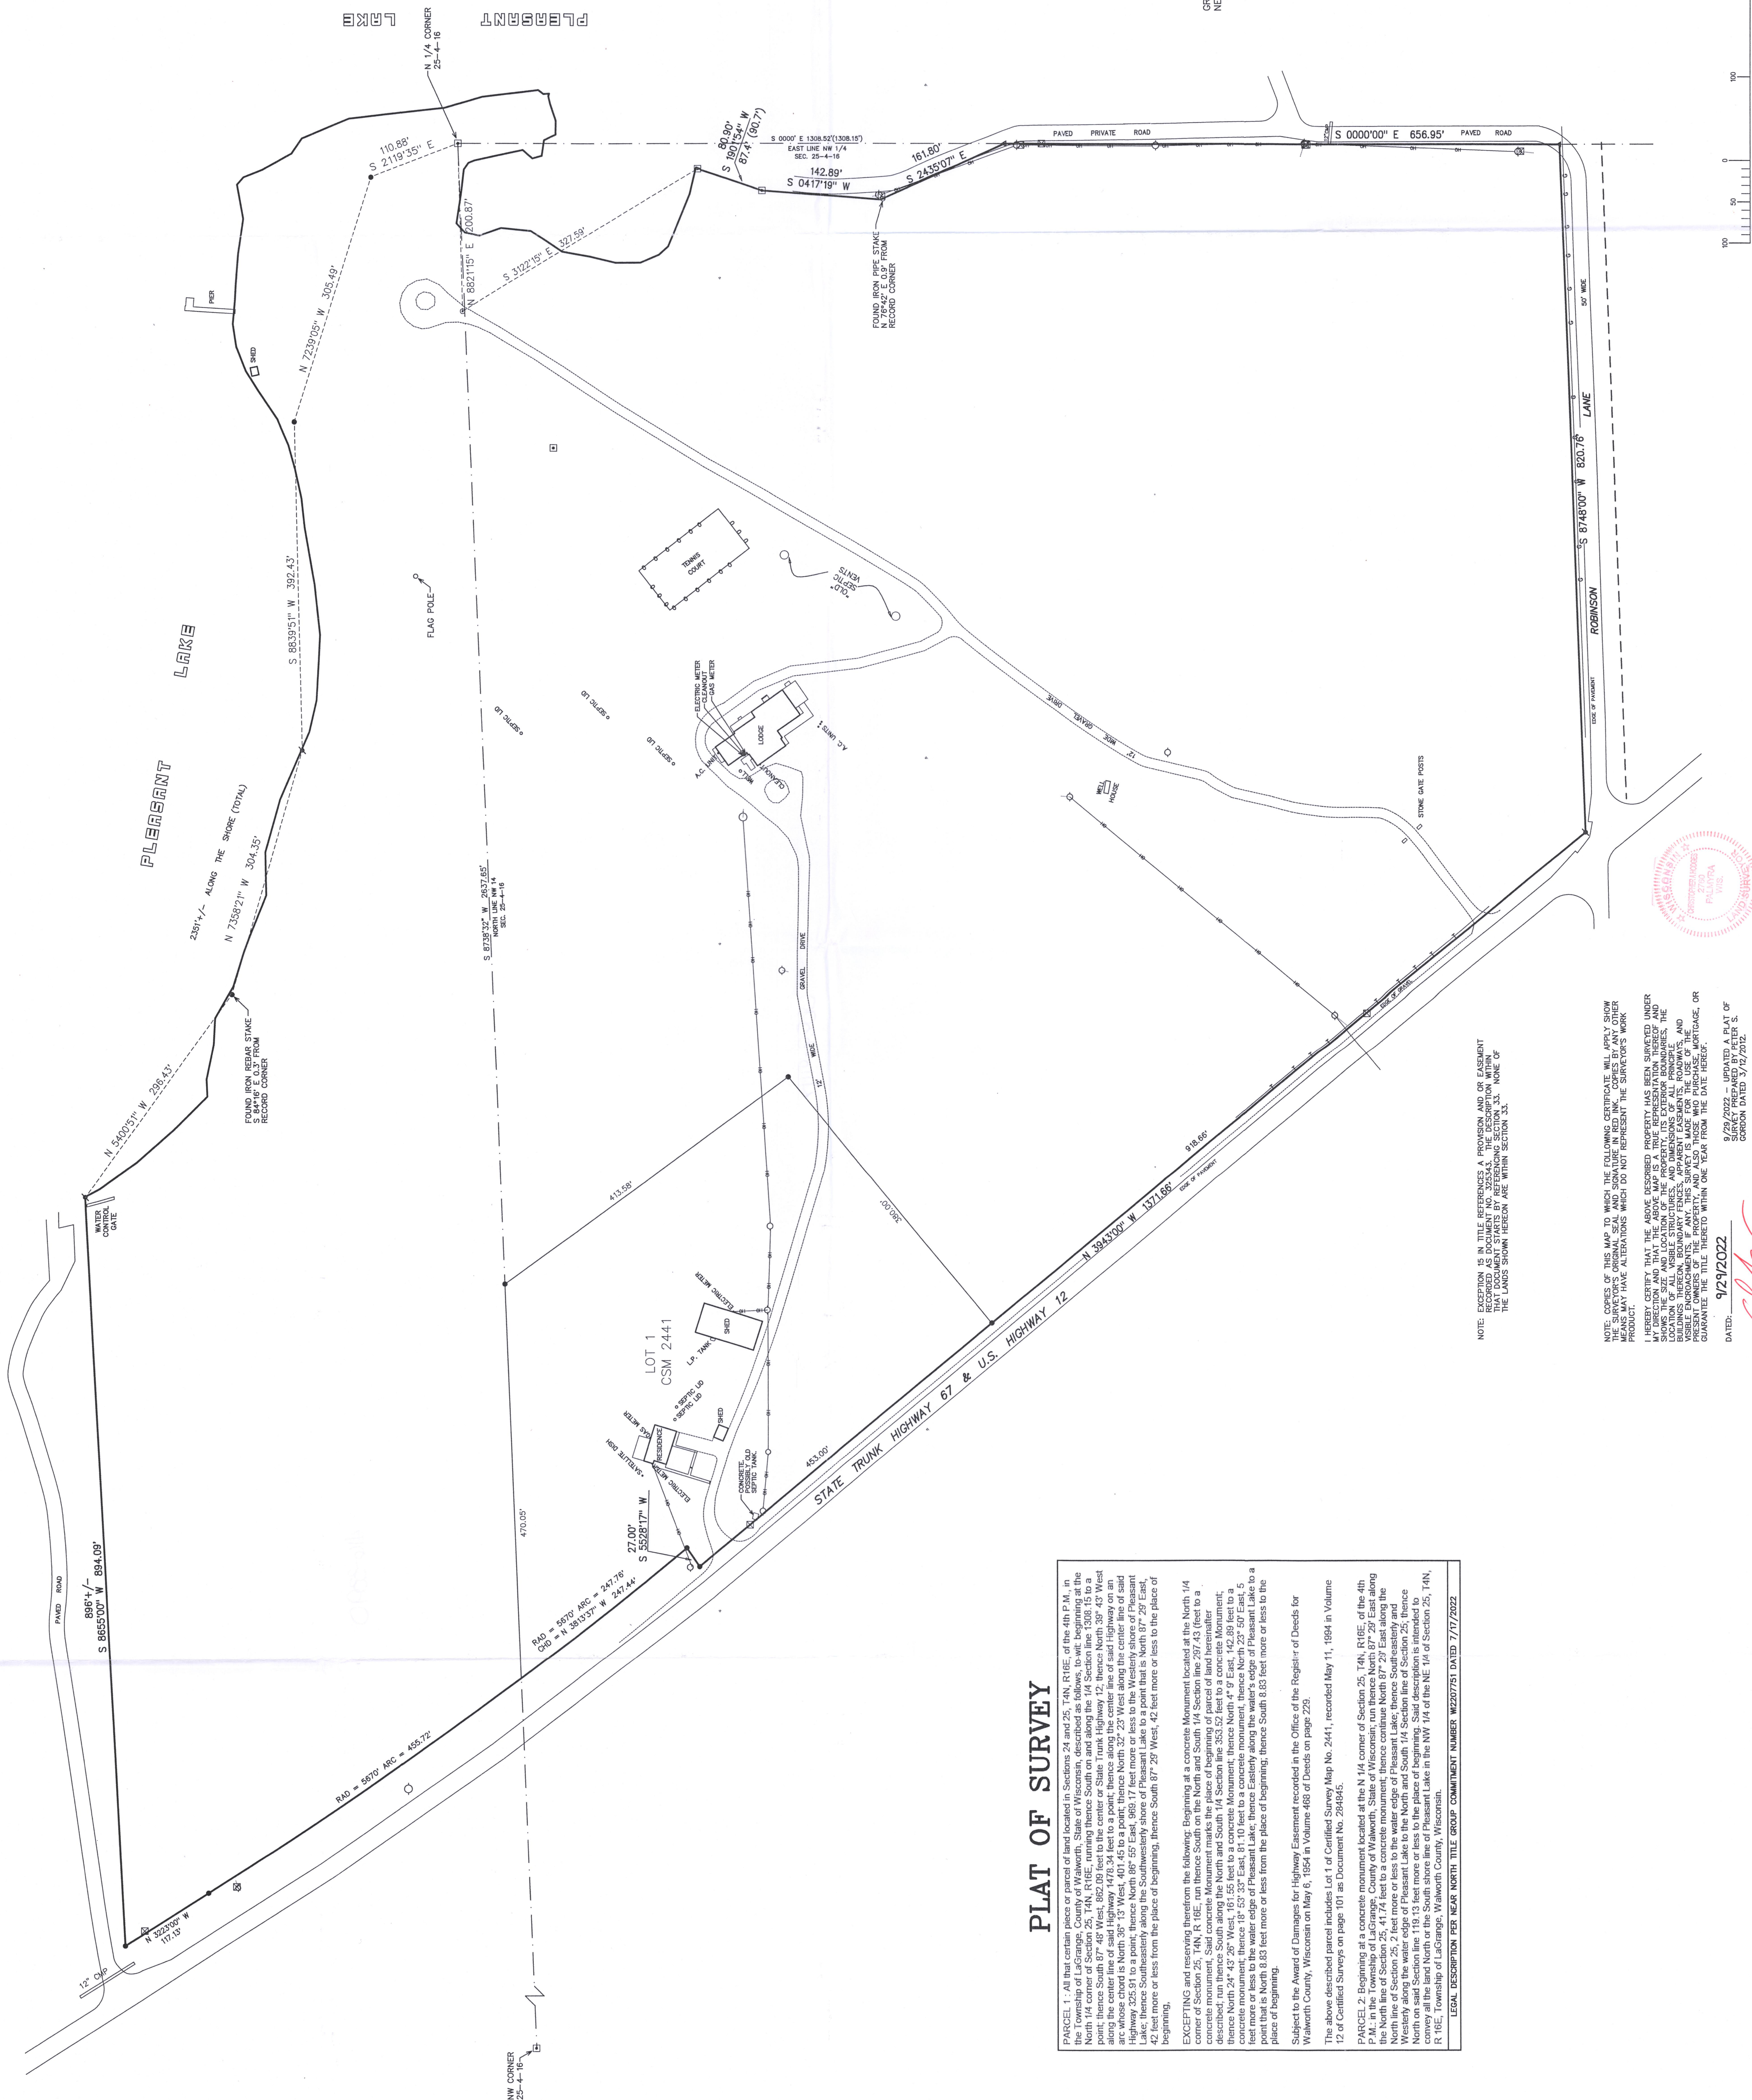


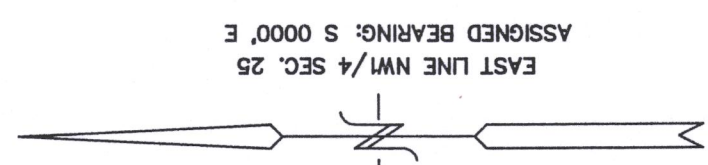

PLAT OF SURVEY



Subject to the Award of Damages for Highway Easement recorded in the Office of the Registrar of Deeds for Walworth County, Wisconsin on May 6, 1994 in Volume 468 of Deeds on page 229.

The above described parcel includes Lot 1 of Certified Survey Map No. 2441, recorded May 11, 1994 in Volume 12 of Certified Surveys on page 101 as Document No. 284845.

Said description is intended to convey all the land North or the South shore line of Pleasant Lake in the NW 1/4 of the NE 1/4 of Section 25, T4N, R10E, Township of LaGrange, Walworth County, Wisconsin.

LEGAL DESCRIPTION PER NEAR NORTH TITLE GROUP COMMITMENT NUMBER W12207751 DATED 7/17/2022

NOTE: EXCEPTION 15 IN TITLE REFERENCES A PROVISION AND OR EASEMENT RECORDED AS DOCUMENT NO. 325343. THE DESCRIPTION WITHIN THAT DOCUMENT STARTS BY REFERENCE SECTION 33. NONE OF THE LANDS SHOWN HEREON ARE WITHIN SECTION 33.

NOTE: COPIES OF THIS MAP TO WHICH THE FOLLOWING CERTIFICATE WILL APPLY SHOW THE SURVEYOR'S ORIGINAL SEAL AND SIGNATURE IN RED INK. COPIES BY ANY OTHER MEANS MAY HAVE ALTERATIONS WHICH DO NOT REPRESENT THE SURVEYOR'S WORK PRODUCT.

DATED: 9/29/2022 9/29/2022 – UPDATED A PLAT OF SURVEY PREPARED BY PETER S. GORDON DATED 3/12/2012.

CHRISTOPHER A. HOOGES P.L.S. 2760

4A241F	4UG24-31	H 625-25
--------	----------	----------

4/6, 3390