
PLAT OF SURVEY

LOTS 9 AND 9A, ARROWHEAD PARK, LOCATED IN GOVERNMENT LOT 3, IN THE NORTHWEST 1/4 OF THE SOUTHEAST 1/4 OF SECTION 35, TOWN 4 NORTH, RANGE 16 EAST, TOWN OF LAGRANGE, WALWORTH COUNTY, WISCONSIN.

SURVEYD FOR: GREG OLSEN/GLEN WILLMENG

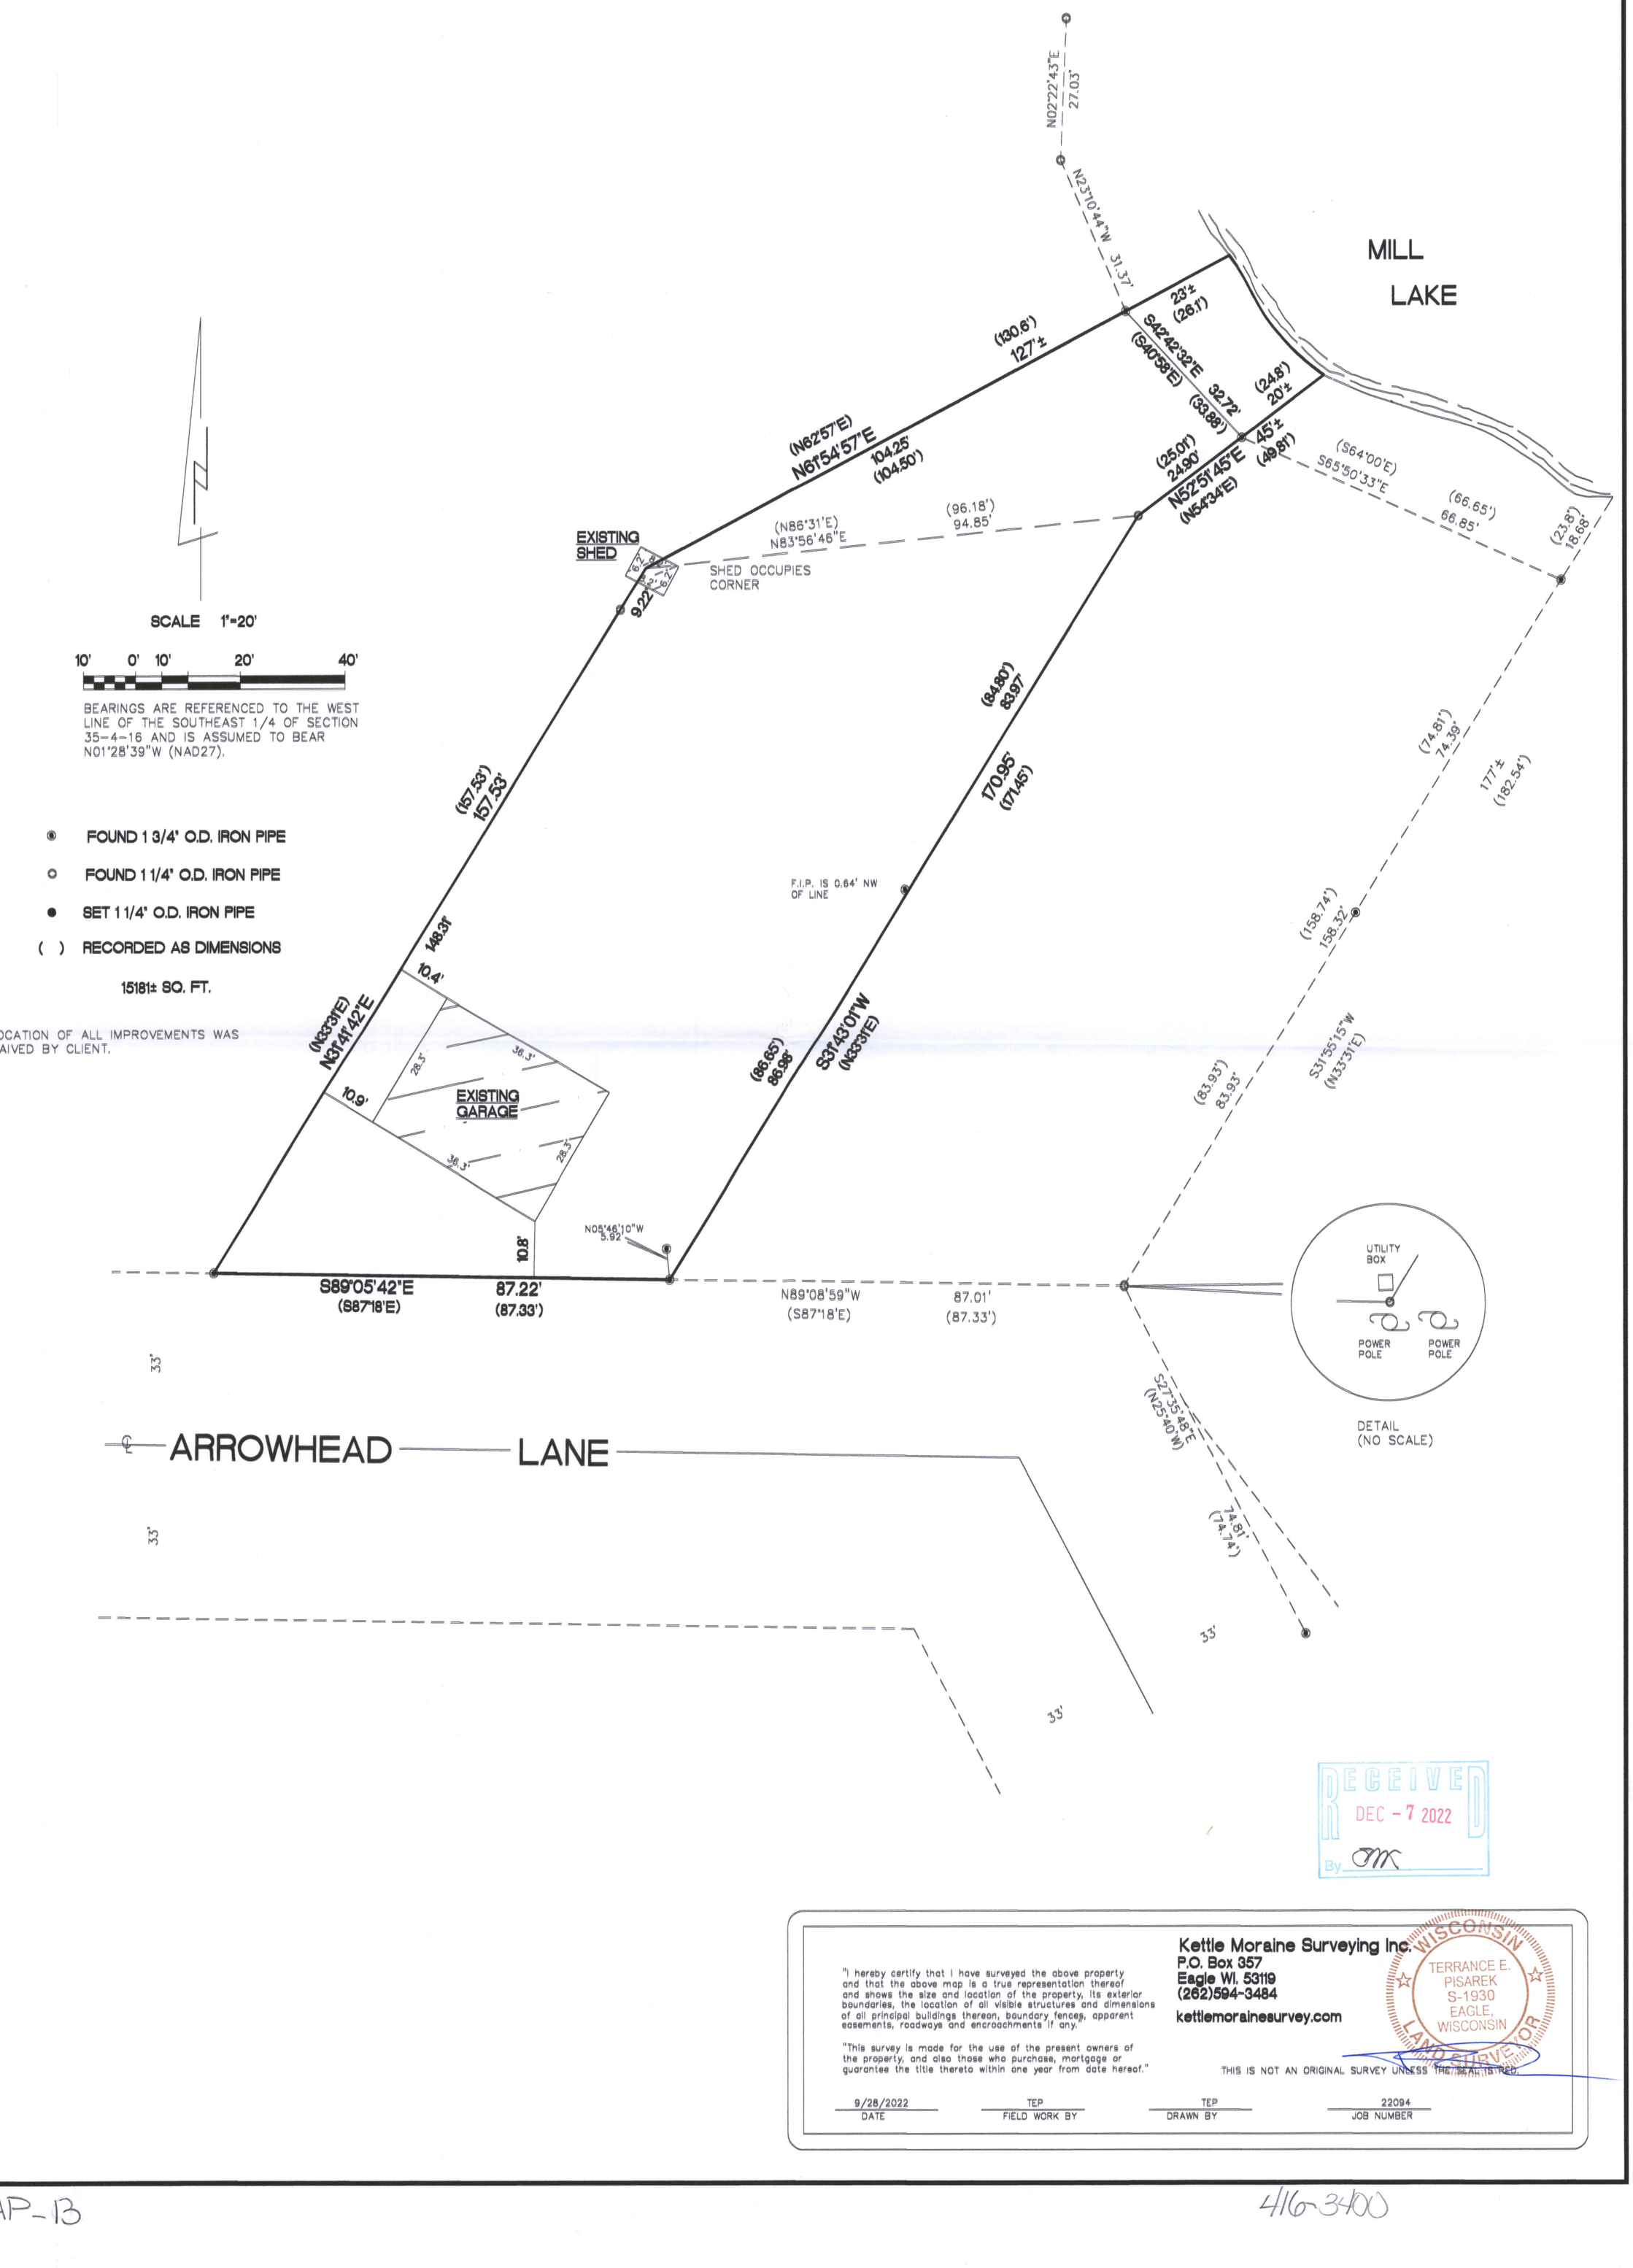

DETAIL
(NO SCALE)

SCALE 1"=20'

10' 0' 10' 20' 40'

BEARINGS ARE REFERENCED TO THE WEST LINE OF THE SOUTHEAST 1/4 OF SECTION 35-4-16 AND IS ASSUMED TO BEAR N01°28'39"W (NAD27).

- FOUND 1 3/4" O.D. IRON PIPE
- FOUND 1 1/4" O.D. IRON PIPE
- SET 1 1/4" O.D. IRON PIPE
- ( ) RECORDED AS DIMENSIONS

15181± SQ. FT.

LOCATION OF ALL IMPROVEMENTS WAS WAIVED BY CLIENT.

RECEIVED
DEC - 7 2022
By

Kettle Moraine Surveying Inc.
P.O. Box 357
Eagle WI. 53119
(262)594-3484
kettlemorainesurvey.com

"I hereby certify that I have surveyed the above property and that the above map is a true representation thereof and shows the size and location of the property, its exterior boundaries, the location of all visible structures and dimensions of all principal buildings thereon, boundary fences, apparent easements, roadways and encroachments if any."

"This survey is made for the use of the present owners of the property, and also those who purchase, mortgage or guarantee the title thereto within one year from date hereof."

WISCONSIN
TERRANCE E. PISAREK
S-1930
EAGLE, WISCONSIN
LAND SURVEYOR

THIS IS NOT AN ORIGINAL SURVEY UNLESS THE SEAL IS RED.

9/28/2022	TEP	TEP	22094
DATE	FIELD WORK BY	DRAWN BY	JOB NUMBER

HAP-13

4/16-3400