
FARRIS, HANSEN & ASSOCIATES, INC.
7 Ridgeway Court - P.O. Box 487
Elkhorn, Wisconsin
414-723-2098

RECEIVED
SEP 18 1985

PLAT OF SURVEY OF LOT 6 BLOCK 2 OF BAY VIEW MANOR, A SUBDIVISION LOCATED IN SECTION 36, TOWN 4 NORTH, RANGE 16 EAST WALWORTH COUNTY, WISCONSIN

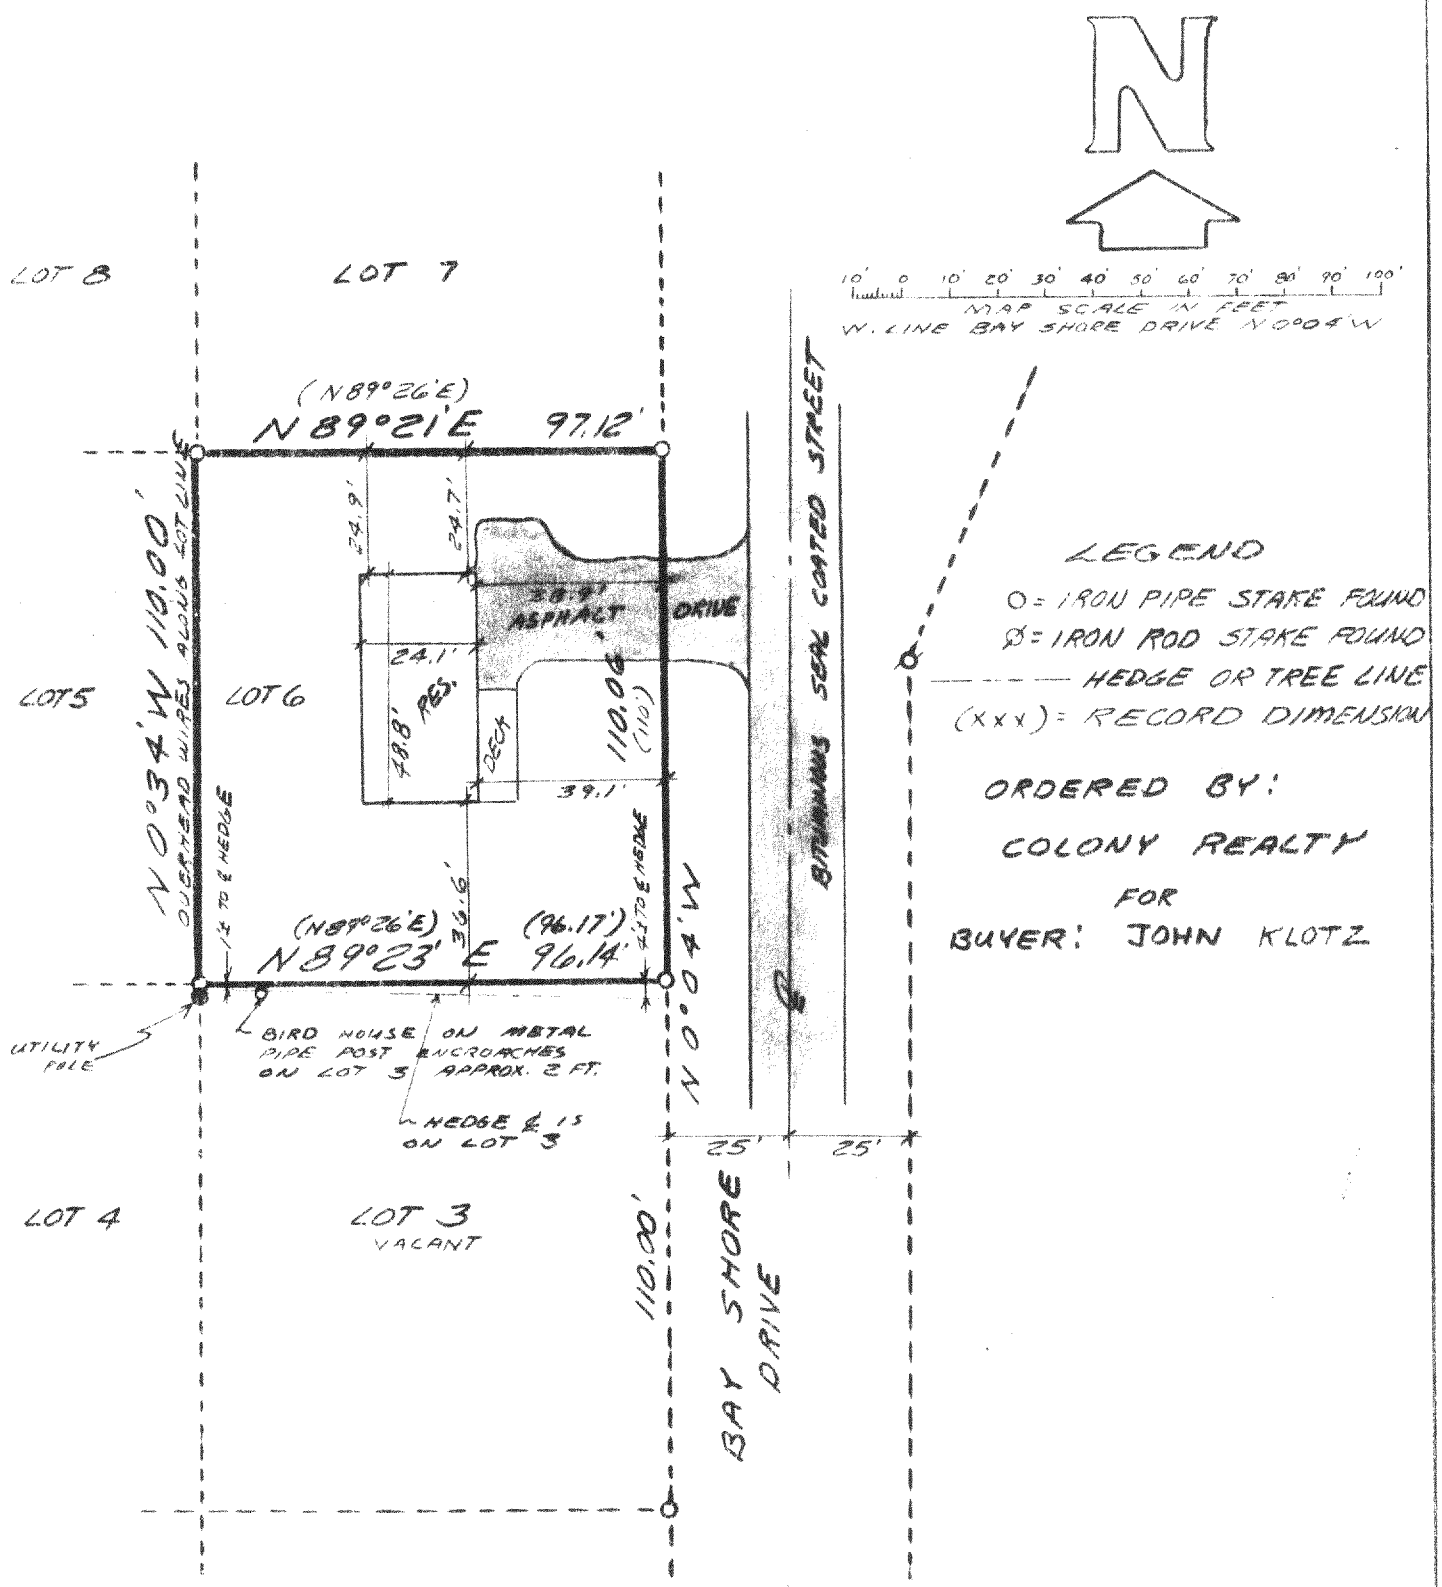

LEGEND

O = IRON PIPE STAKE FOUND

Ø = IRON ROD STAKE FOUND

——— HEDGE OR TREE LINE

(xxx) = RECORD DIMENSION

ORDERED BY:

COLONY REALTY

FOR

BUYER: JOHN KLOTZ

I hereby certify that I have surveyed the above described property and that the above map is a true representation thereof and shows the size and location of the property, its exterior boundaries, the location of all visible structures and dimensions of all principal buildings thereon, boundary fences, apparent easements, roadways and visible encroachments, if any.
This survey is made for the use of the present owners of the property, and also those who purchase, mortgage, or guarantee the title thereto within one (1) year from the date hereof.

Robert A. Farris

DATED AUG. 12, 1985



416-344-F

PROJECT NO. 2455

Key # HB-00031