
LAND-MARK SURVEYING
Mark L. Miritz
Wisconsin Professional Land Surveyor S-2582

N9330 Knuteson Drive
Whitewater, WI 53190
Phone:(262)949-1239
MARKMIRITZ@
LAND-MARKSURVEYING.COM

OWNER:
N & L JOHNSON TRUST
W5159 BAY SHORE DRIVE
ELKHORN, WI 53121

PLAT OF SURVEY

LOT 2 OF CERTIFIED SURVEY MAP NO. 575, LOCATED IN THE NORTHWEST 1/4 OF SECTION 36, TOWN 4 NORTH, RANGE 16 EAST, TOWN OF LAGRANGE, WALWORTH COUNTY, WISCONSIN.

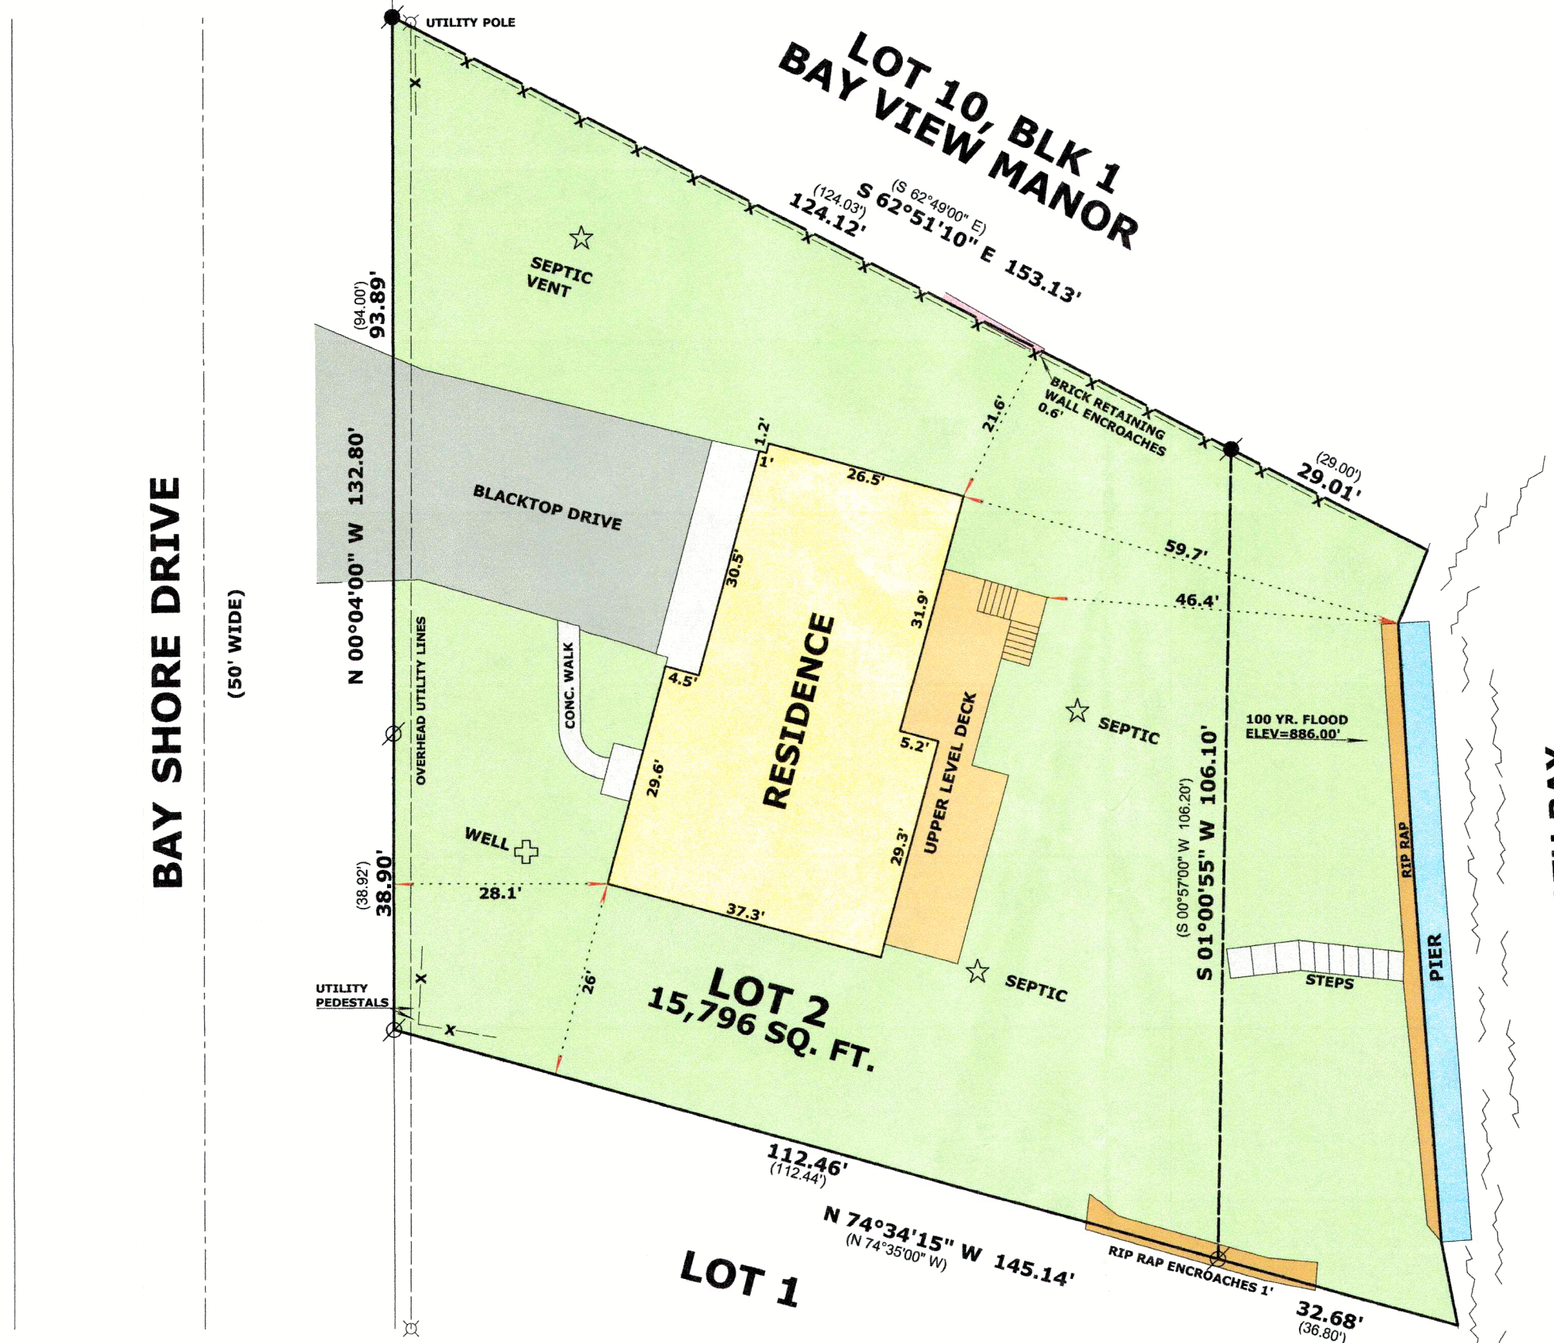



RECEIVED
SEP 20 2023
By SMF

LEGEND

- ⌀ FOUND IRON PIPE
- ● FOUND IRON ROD
- (xx) RECORDED AS DIMENSION
- —x—x— EXISTING SPLIT RAIL FENCE

SCALE: 1 INCH = 20 FEET

"I hereby certify that the above described property has been surveyed by me or under my direction and that the above map is a true representation thereof and shows the size and location of the property, its exterior boundaries, the location of all visible structures and dimensions of all principal buildings thereon, boundary fences, apparent easements, roadways and visible encroachments, if any."
"This survey is made for the use of the present owners of the property, and also those who purchase, mortgage, or guarantee the title thereto within one year from date hereof."

Mark L. Miritz
MARK L. MIRITZ
WISCONSIN PROFESSIONAL LAND SURVEYOR S-2582

DATE: JUNE 12, 2023 **JOB NO.** 23.601

HA575-2

4116-34/53