ABERNATHY and ASSOCIATES
Kenneth B. Abernathy Jr.
Wisconsin Registered Land Surveyor S-1594

Rt. 3, Box 273
Elkhorn, Wisconsin 53121
Phone: (414) 723-4260 (office)
(414) 723-4813 (residence)


PLAT OF SURVEY

Lots 51 and 52 of Lauderdale Heights Subdivision, Lagrange Township, Walworth County, Wisconsin.

Vol. 9 Page 23 of Plats
Cabinet I Slide 97

Owner: Dorothy Dow
P.O. Box 594
Elkhorn, Wi. 53121

Ordered by: Kathleen B.
Seymour - Keefe
Real Estate

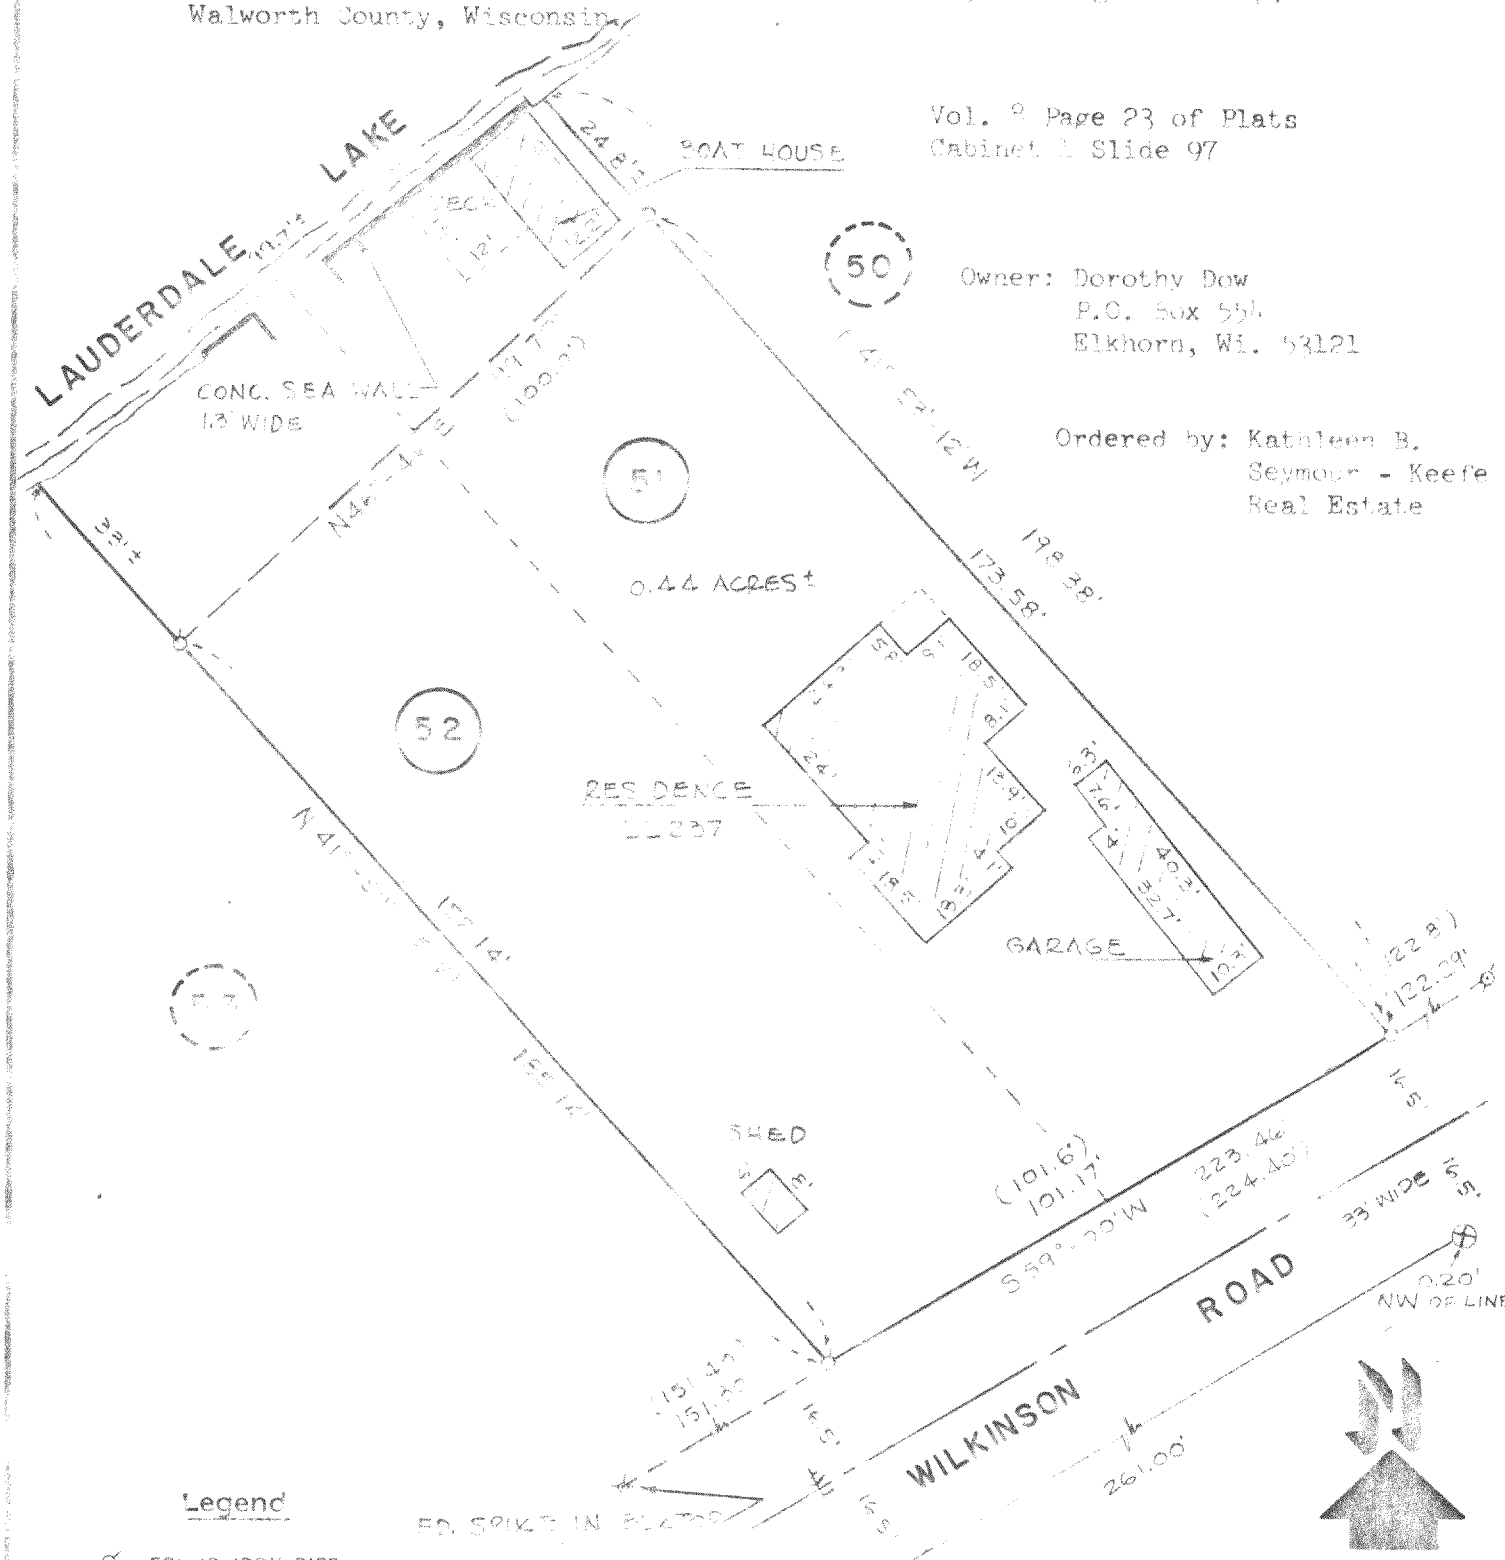

Legend

- FOUND IRON PIPE
- FOUND IRON ROD
- FOUND BRASS CAPPED MONUMENT
- FOUND CONCRETE MONUMENT
- CHISEL CUT IN CONCRETE
- SET IRON ROD, 24" LONG, WEIGHING 1.5 LBS./LINEAL FT., 3/4" DIA.
- SET IRON ROD, 30" LONG, WEIGHING 4.5 LBS./LINEAL FT., 1 1/4" DIA.
- (xx) RECORDED AS DIMENSION
- —x—x— EXISTING FENCE

SCALE: 1"=30 FEET

I hereby certify that I have surveyed the above described property and that the above map is a true representation thereof and shows the size and location of the property, its exterior boundaries, the location of all visible structures and dimensions of all principal buildings thereon, boundary fences, apparent easements, roadways and visible encroachments, if any."

"This survey is made for the use of the present owners of the property, and also those who purchase, mortgage, or guarantee the title thereto within one year from date hereof."

Kenneth B. Abernathy Jr.

KENNETH B. ABERNATHY, JR.
WISCONSIN REGISTERED LAND SURVEYOR,
S-1594

Date: 5-24-85 Job No. 1985.502

WISCONSIN KENNETH B. ABERNATHY, JR. S-1594 ELKHORN, WI LAND SURVEYOR

WLM-15

416-346