# PLAT OF SURVEY & AS-BUILT
## PART OF LOT 3 OF MORRIS PARK, A SUBDIVISION

LOCATED IN PART OF THE NE 1/4 & NW 1/4 OF THE SW 1/4 OF SECTION 26, TOWN 4 NORTH, RANGE 16 EAST, WALWORTH COUNTY, WISCONSIN

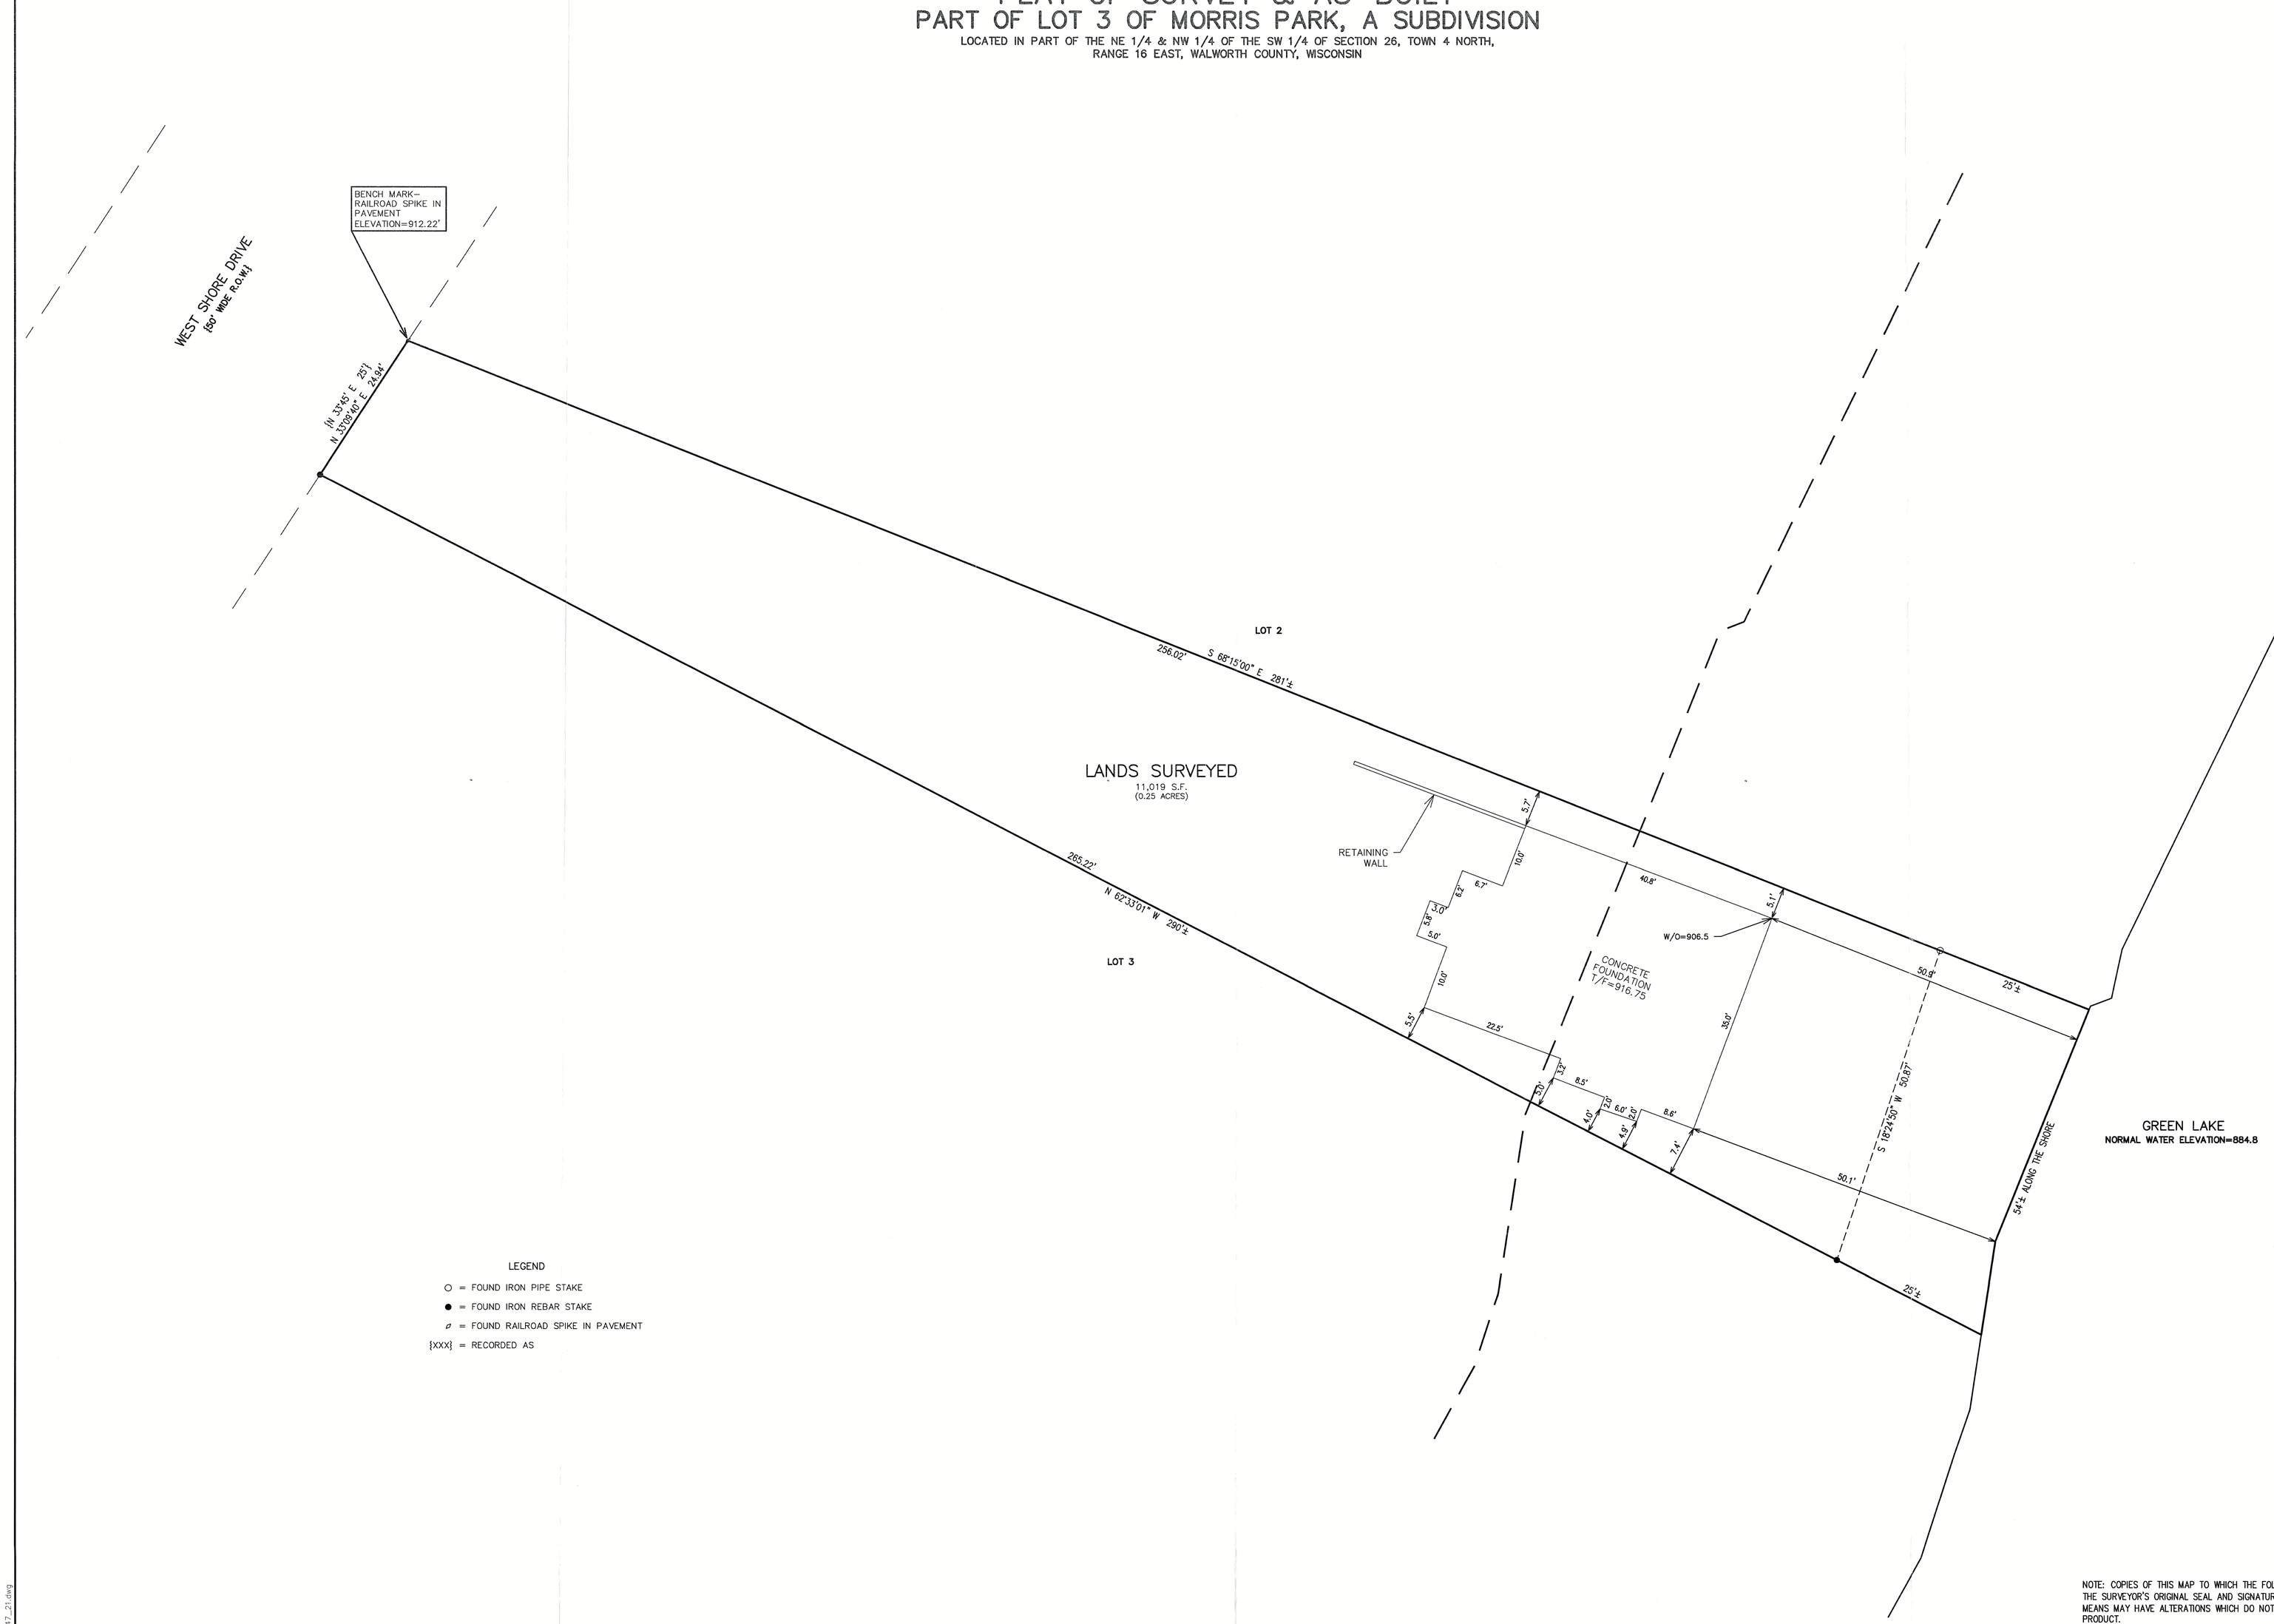


LEGEND

- ○ = FOUND IRON PIPE STAKE
- ● = FOUND IRON REBAR STAKE
- ⌀ = FOUND RAILROAD SPIKE IN PAVEMENT
- {XXX} = RECORDED AS

10 5 0 10 20 30 40

MAP SCALE IN FEET - ORIGINAL 1"=10'

NOTE: COPIES OF THIS MAP TO WHICH THE FOLLOWING CERTIFICATE WILL APPLY SHOW THE SURVEYOR'S ORIGINAL SEAL AND SIGNATURE IN RED INK. COPIES BY ANY OTHER MEANS MAY HAVE ALTERATIONS WHICH DO NOT REPRESENT THE SURVEYOR'S WORK PRODUCT.

I HEREBY CERTIFY THAT THE ABOVE DESCRIBED PROPERTY HAS BEEN SURVEYED UNDER MY DIRECTION AND THAT THE ABOVE MAP IS A TRUE REPRESENTATION THEREOF AND SHOWS THE SIZE AND LOCATIONS THAT WERE AS-BUILTED.

DATED: 1/20/2025

CHRISTOPHER A. HODGES P.L.S. 2760

CHRISTOPHER A. HODGES S-2760 ELKHORN WIS. LAND SURVEYOR

X:\PROJECTS\5347\5347.21\ACAD\5347_21.dwg

TOPOGRAPHIC SURVEY

N7906 WEST SHORE DRIVE
ELKHORN, WISCONSIN

- WORK ORDERED BY -
STEVEN WAEGHE
325 S JULIAN STREET
NAPERVILLE, IL 60540


FARRIS, HANSEN & ASSOCIATES, INC.
ENGINEERING - ARCHITECTURE - SURVEYING
7 RIDGWAY COURT P.O. BOX 437
ELKHORN, WISCONSIN 53121
OFFICE: (262) 723-2098 FAX: (262) 723-5886


REVISIONS
RPS - 1/20/25

PROJECT NO.
5347.21

DATE
06/01/2021

SHEET NO.
1 OF 1

HMP-2 416-3588