
PLAT OF SURVEY

OF

LOT 71 OF LAUDERDALE HEIGHTS, A SUBDIVISION LOCATED IN SECTION 36, T4N R16E, WALWORTH COUNTY, WISCONSIN.

Surveyed for ~
Sue Stenstrom
Colonel Realty
16 E. Walworth St.
Elkhorn, Wisc. 53121

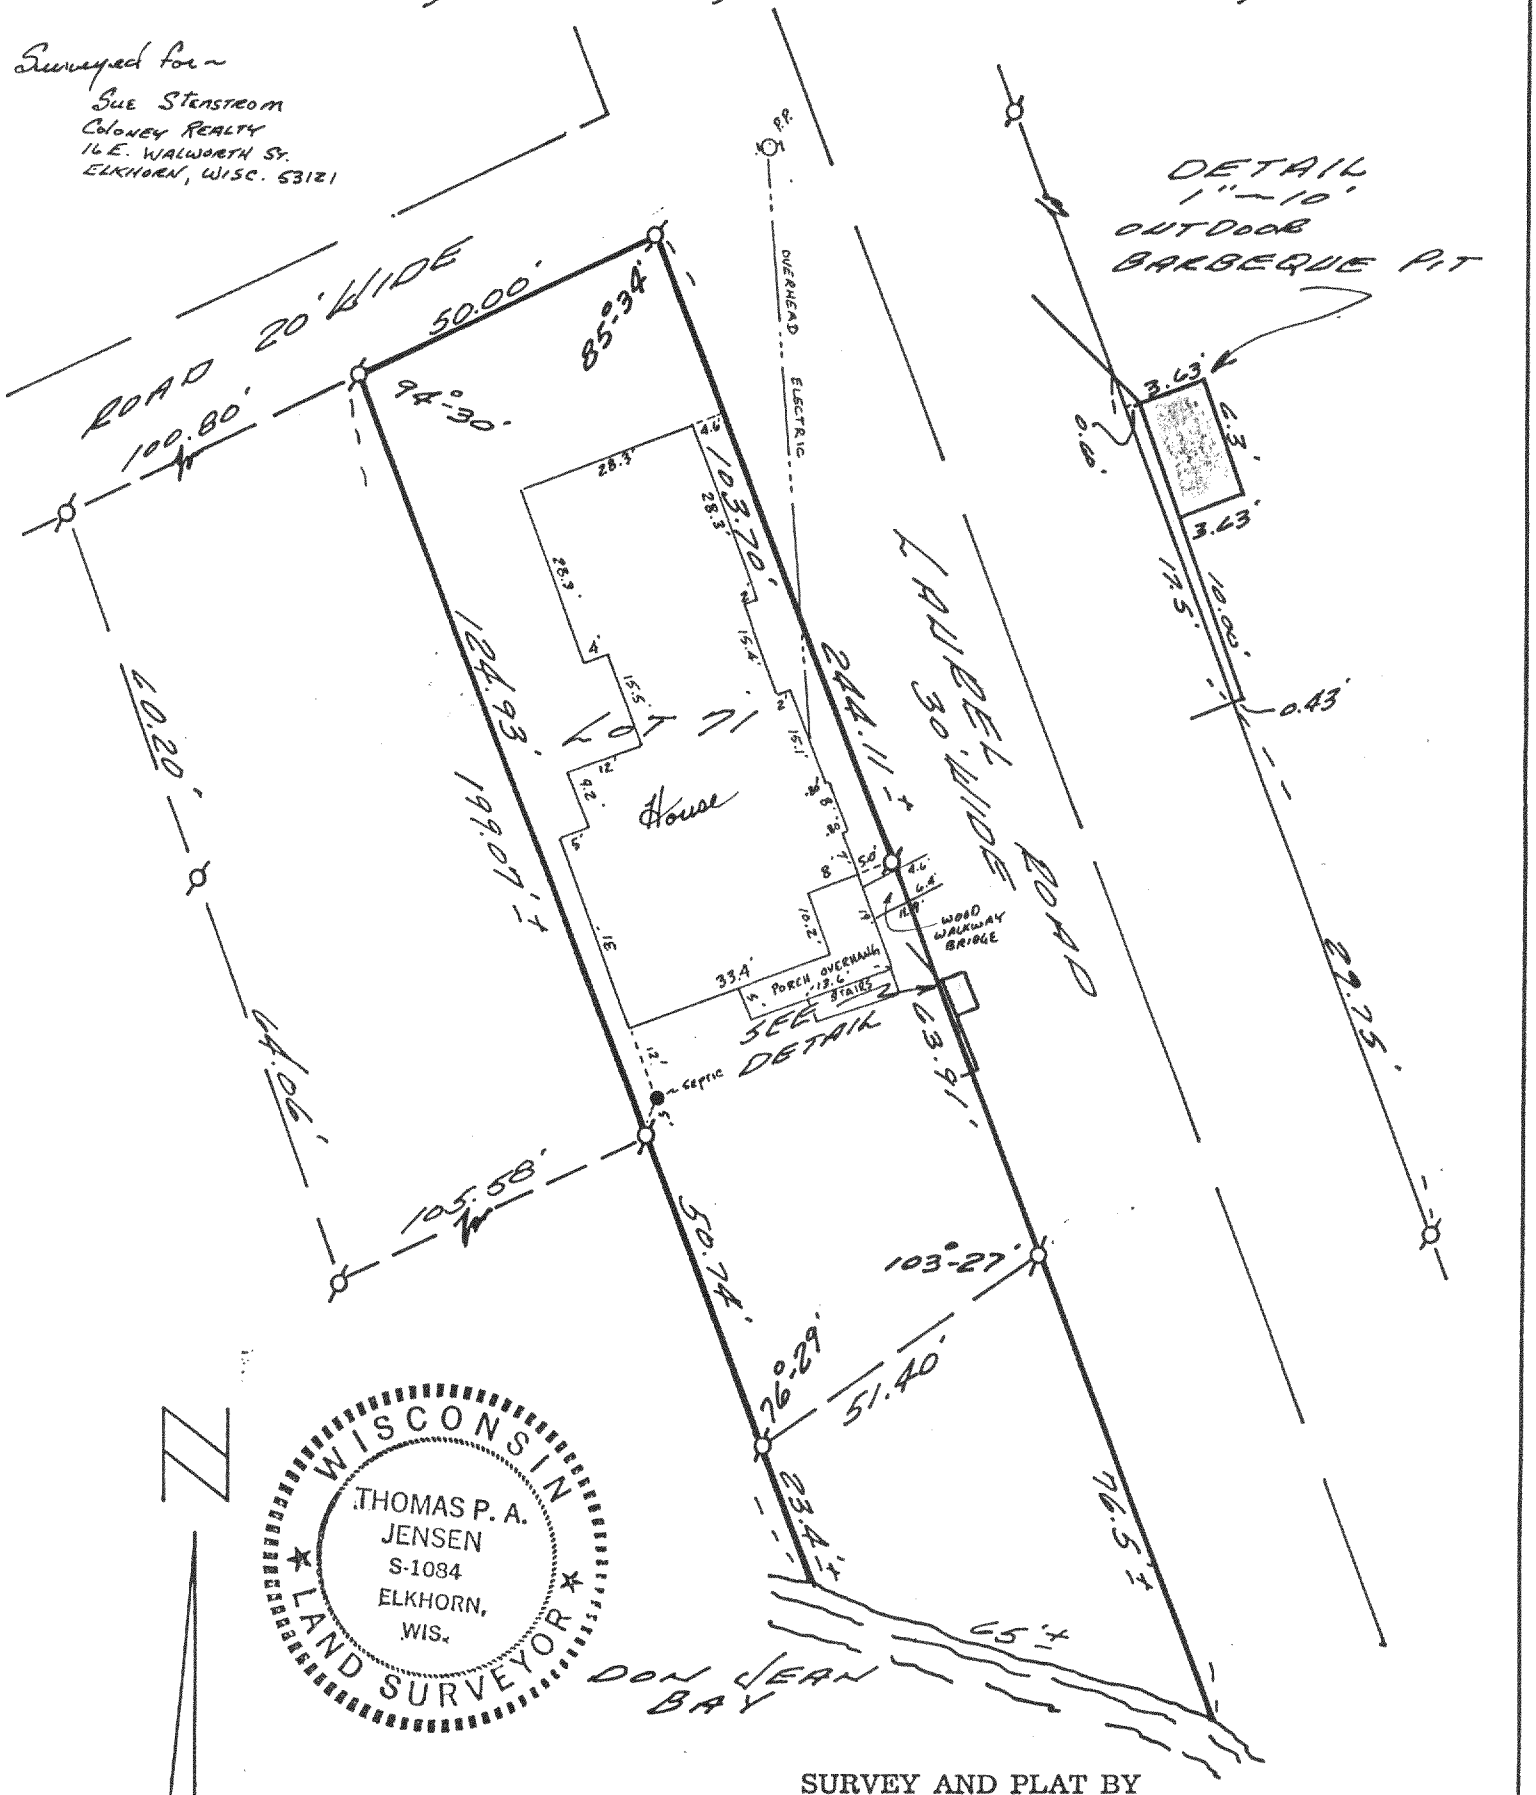

WISCONSIN
THOMAS P. A. JENSEN
S-1084
ELKHORN, WIS.
LAND SURVEYOR

SURVEY AND PLAT BY

JENSEN SURVEYING & MAPPING S.C.

P.O. BOX 322 — 45 S. WISCONSIN ST.

Elkhorn, Wisconsin 53121

LEGEND

O — Iron Pipe SET

● — Concrete Monument

Scale 1" = 30'

Ø — IRON PIPE FOUND

WE CERTIFY: That we have surveyed the above described property and that the plat shown hereon is an accurate survey and a true representation thereof and correctly shows the exterior boundary lines and all divisions of said property, ALL BUILDING HEREON.

Date AUGUST 20, 1985

Thomas P. A. Jensen [redacted],

Wisconsin Registered Land Surveyor, S-1084

PLSS 178H

RECEIVED
NOV 14 1985

1985.070

416-361

HL 4-30