
PLAT OF SURVEY
of

Part of Lots 21, 22, and 23 of Green Island, located in Section 26, Town 4 North, Range 16 East, Walworth County, Wisconsin. Recorded under Tax key # HGI-00004B2 at the Walworth County Courthouse.

Surveyed for: Cal Hansen
7100 Grand Parkway
Wauwatosa, WI. 53213

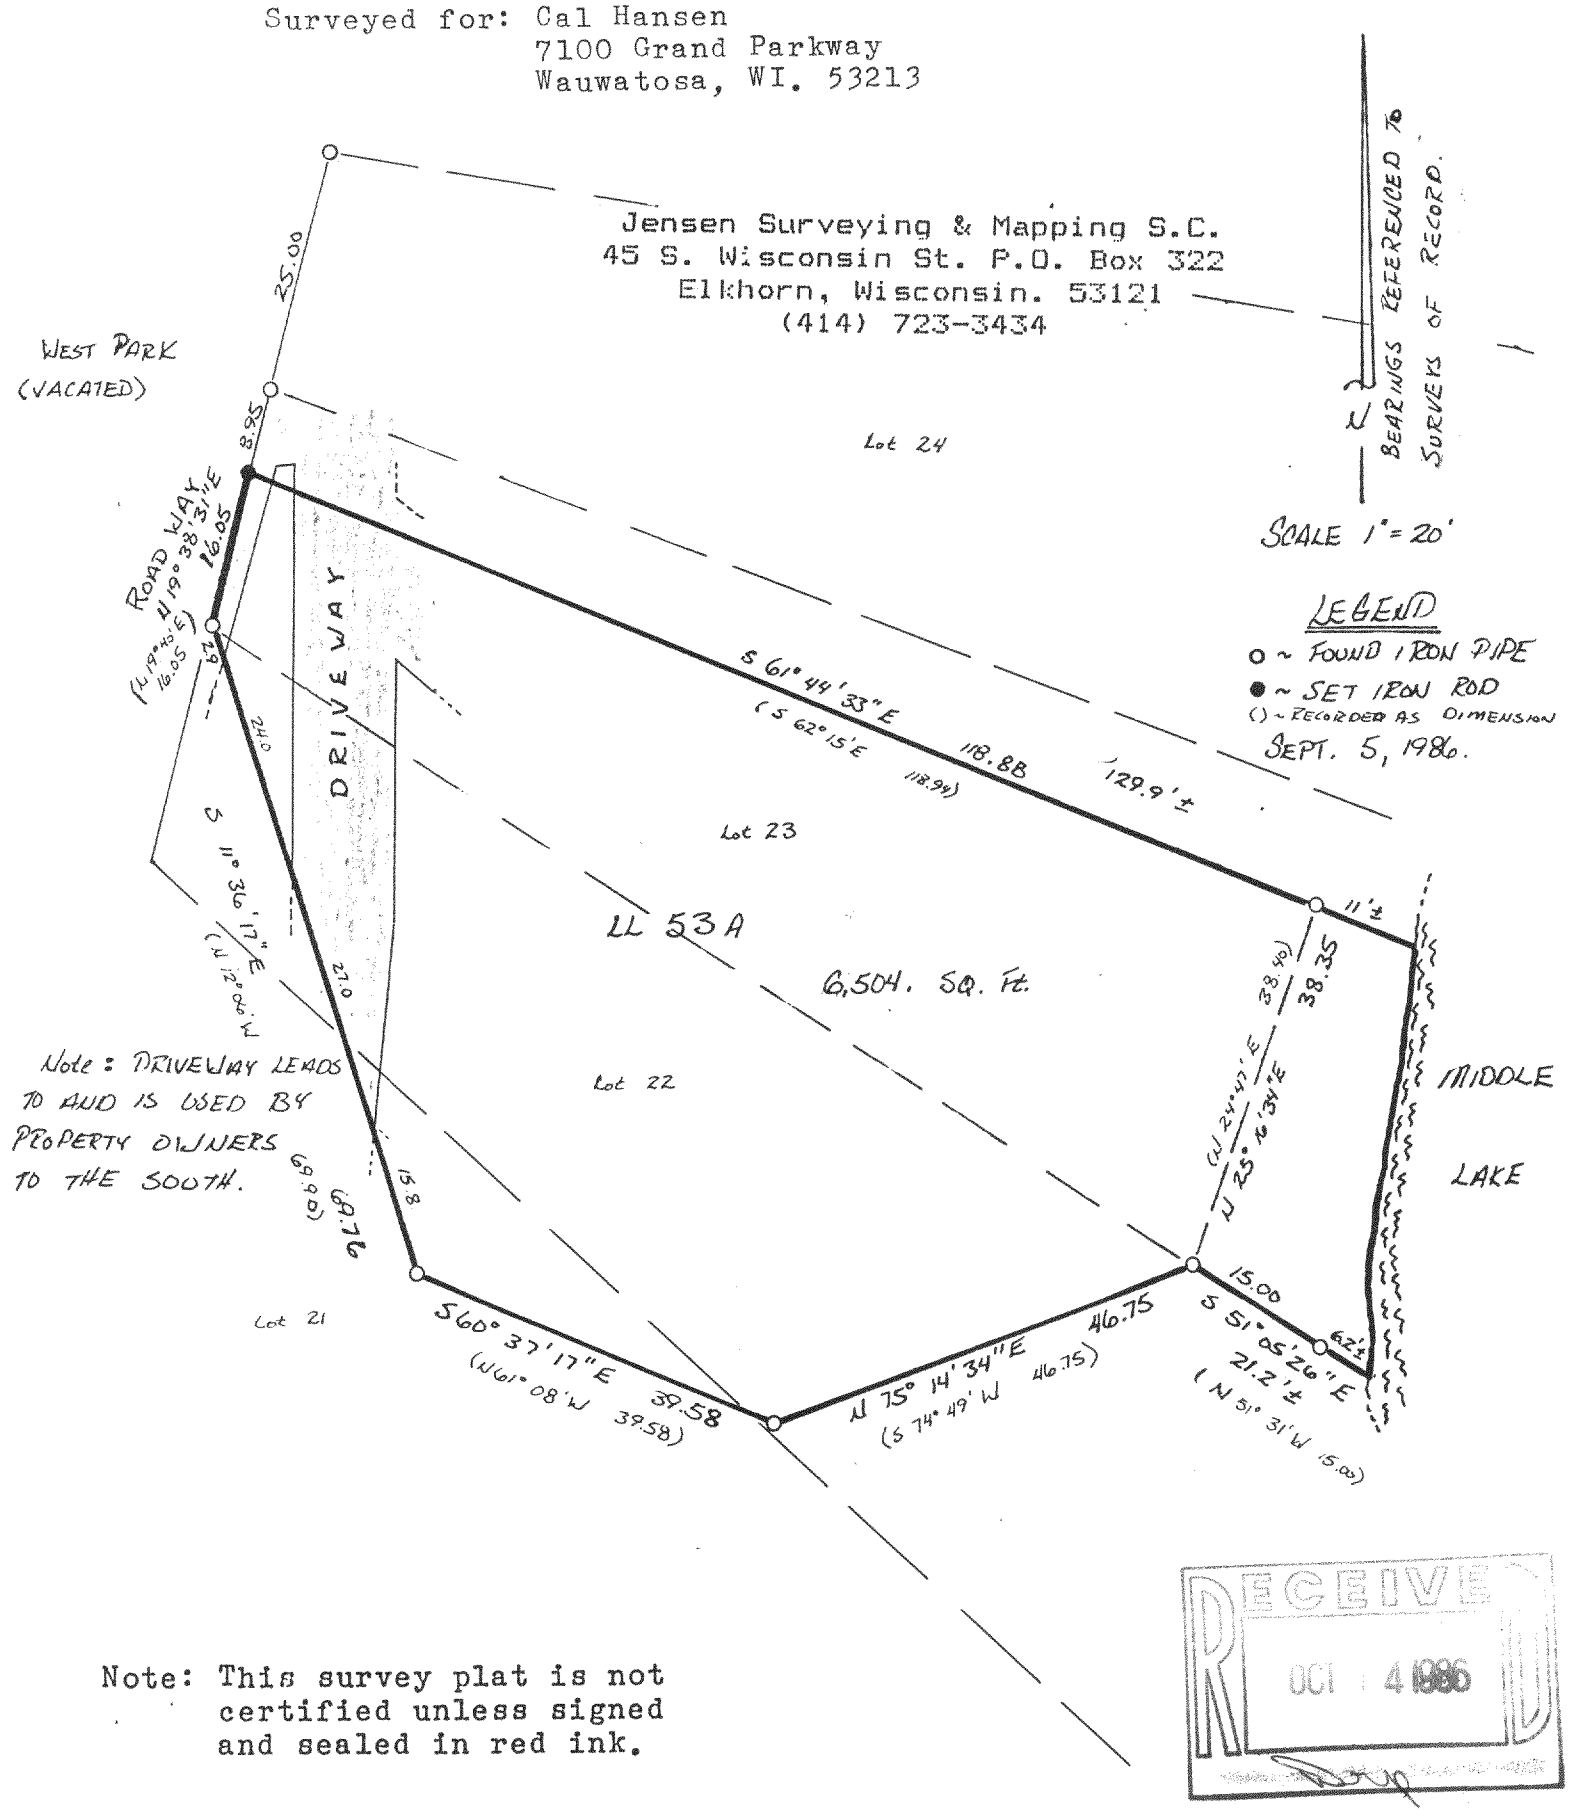

RECEIVED
OCT 14 1986

Note: This survey plat is not certified unless signed and sealed in red ink.

I, Thomas P.A. Jensen, Wisconsin Registered Land Surveyor, do hereby certify that this survey was performed by me, or under my direction, in full compliance with the owner's/agent's instructions and chapter A-E 5 of the Wisconsin Administrative Code "Minimum Standards For Property Surveys"; and that this map is an accurate representation thereof to the best of my knowledge and belief.

Thomas P.A. Jensen S-1084
Jensen Surveying & Mapping S.C.

1986.087 X

416-402