RECEIVED
MAR 10


D.D. COOPER & CO. INC.
Route 4 Box 508B
Elkhorn WI 53121
Phone-414-723-6265

Plat of survey of lot 16 Arrowhead Park addition number 1
being in the Town of Lagrange Walworth County Wisconsin

Survey ordered by Lauderdale Lakes Realty

Bearing reference:Northerly line
of parcel assumed to bear N46°00'E

Also part of the road in Arrowhead Park Addition #1, Described as beginning at the Southwest corner of lot 16 of said Subdivision: thence S81°01'E 93.93 feet: thence S46°00'W 82.66 feet; thence N81°01'W 93.33 feet; thence N46°00';E 82.66 feet to the point of beginning.

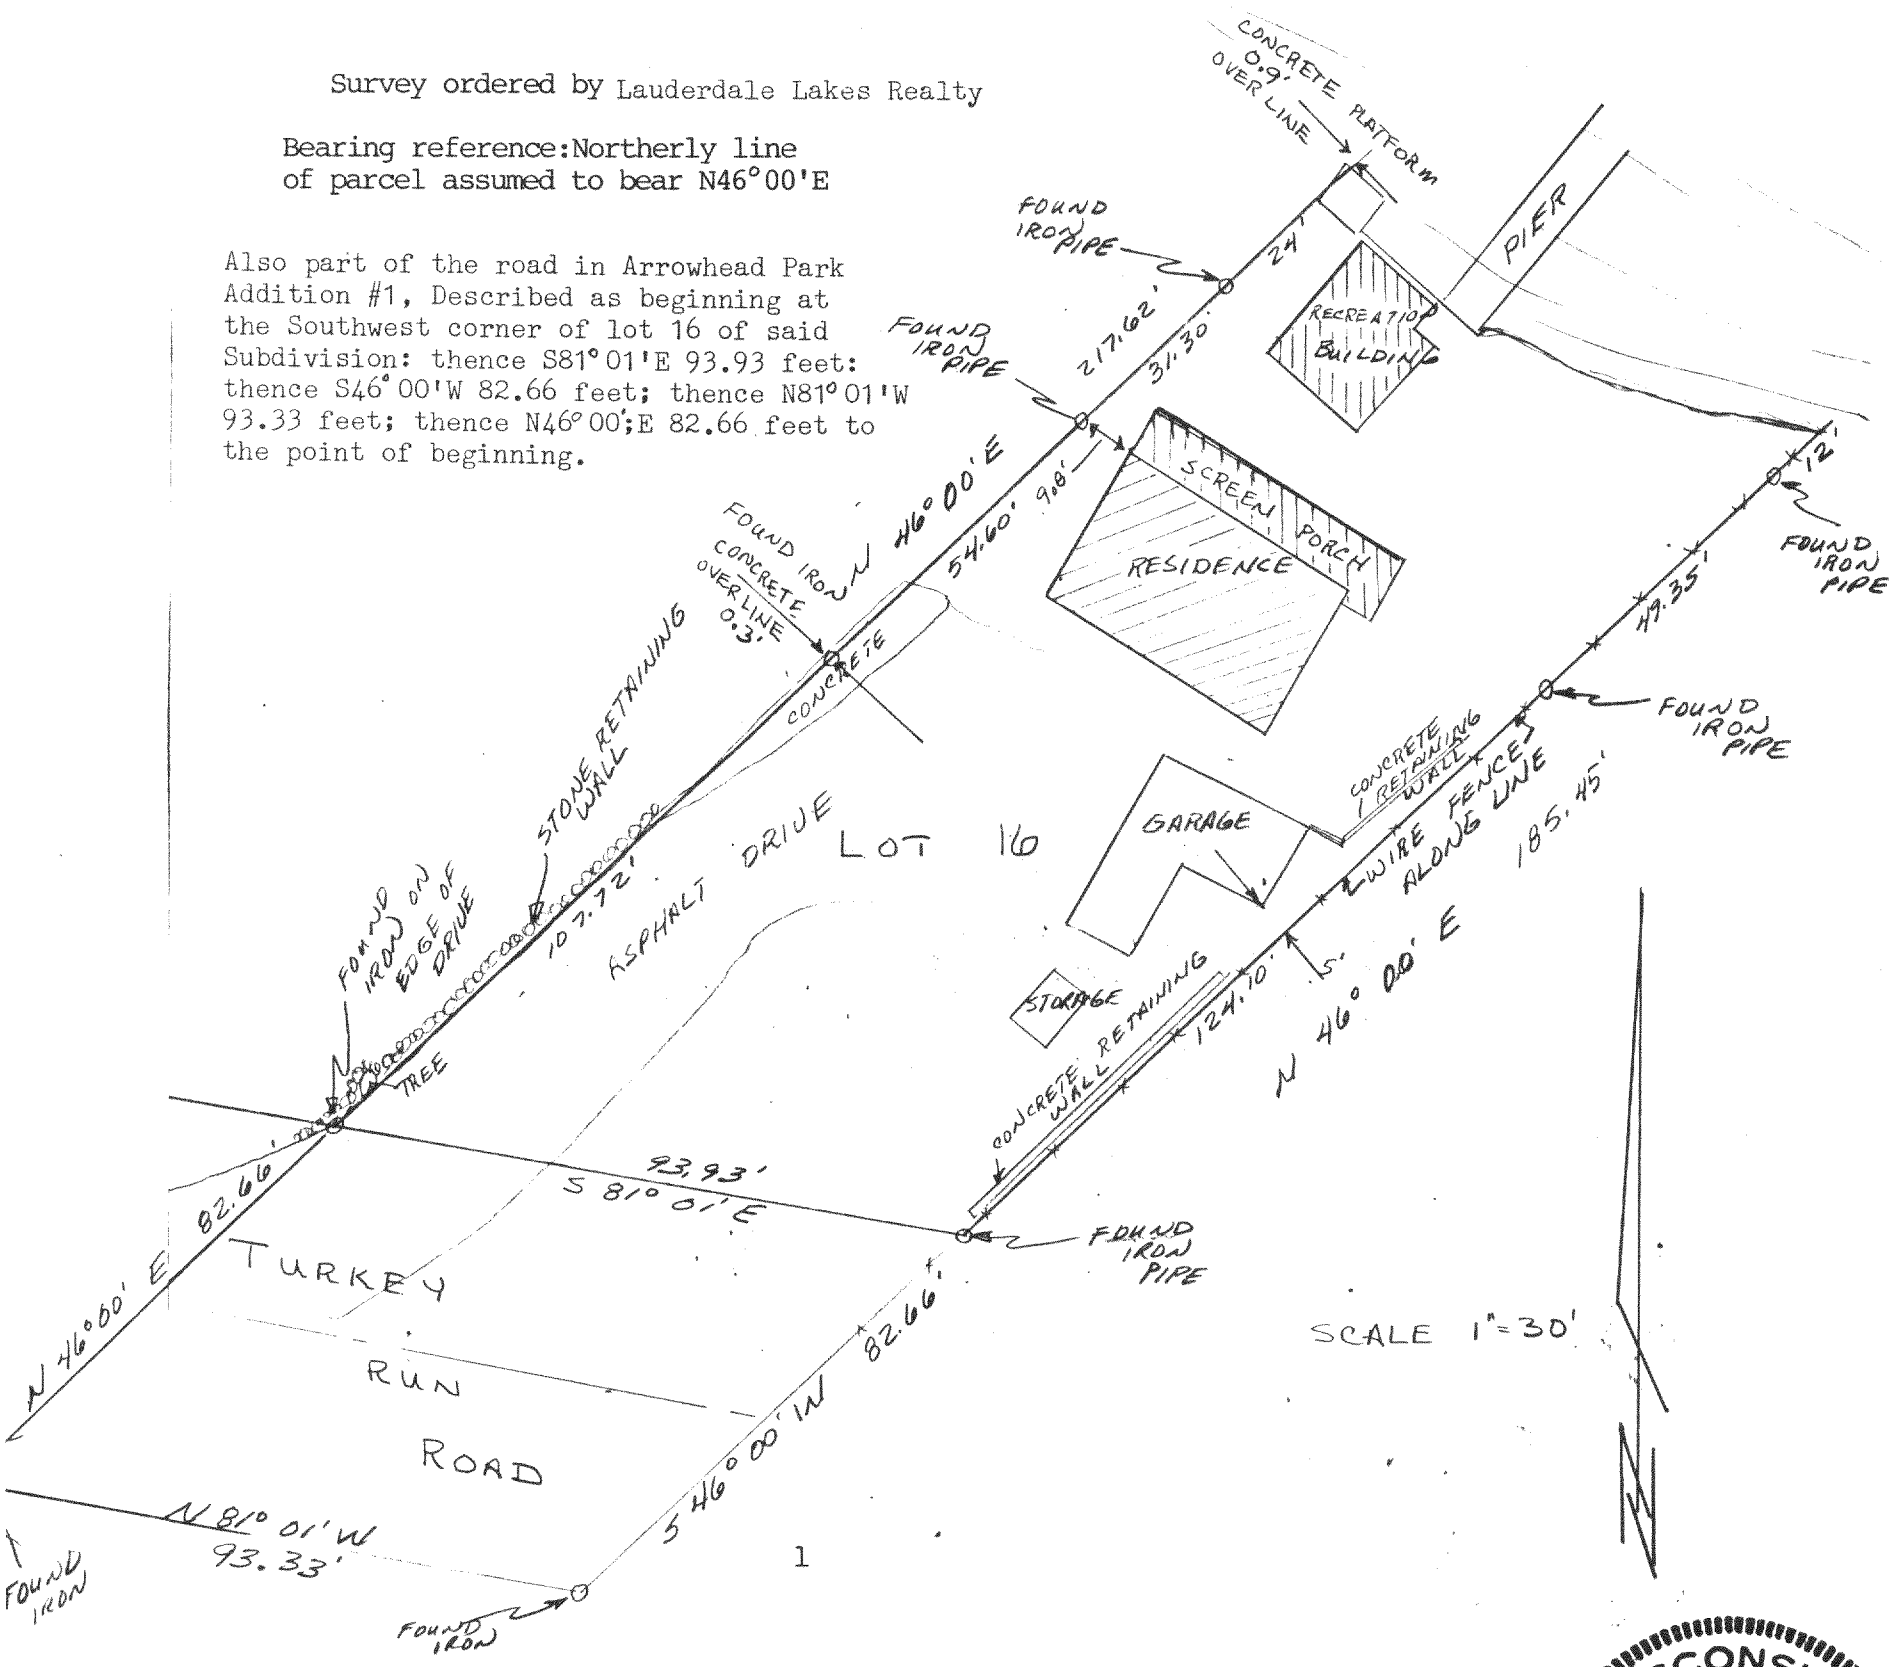

I, Daniel D. Cooper, Registered Land Surveyor do hereby certify that I have surveyed the property described hereon and that the map shown hereon is a true and accurate representation thereof to the best of my professional knowledge and belief.

Dated this 8TH day of July 1986

Daniel D Cooper
Daniel D. Cooper, RLS NO. S-1464

WISCONSIN
DANIEL D. COOPER
S-1464
EAST TROY, WIS.
LAND SURVEYOR

DRAWING NO 2256-5-36

HAPA 00006

416-420