RECEIVED
JUN 19 1987

FARRIS, HANSEN & ASSOCIATES, INC.
7 RIDGEWAY COURT, P.O. BOX 487, ELKHORN, WISCONSIN TEL. 414-723-2098

LOCATION: LOT 1 OF BLOCK 1 OF COOL HILL PARK
LOCATED IN SECTION 35, T.4N., R.16 E.
WALWORTH COUNTY, WISCONSIN
WORK ORDERED BY: COLONY REALTY - ELKHORN, WI.

10 0 10 20 30 40 50 60 70 80 90 100
MAP SCALE IN FEET

MAP LEGEND
Ø = IRON PIPE STAKE FOUND
= IRON PIPE STAKE SET
Ø = IRON ROD STAKE FOUND
= IRON ROD STAKE SET
= CONCRETE MONUMENT FOUND
((XXXX) = RECORD DIMENSION

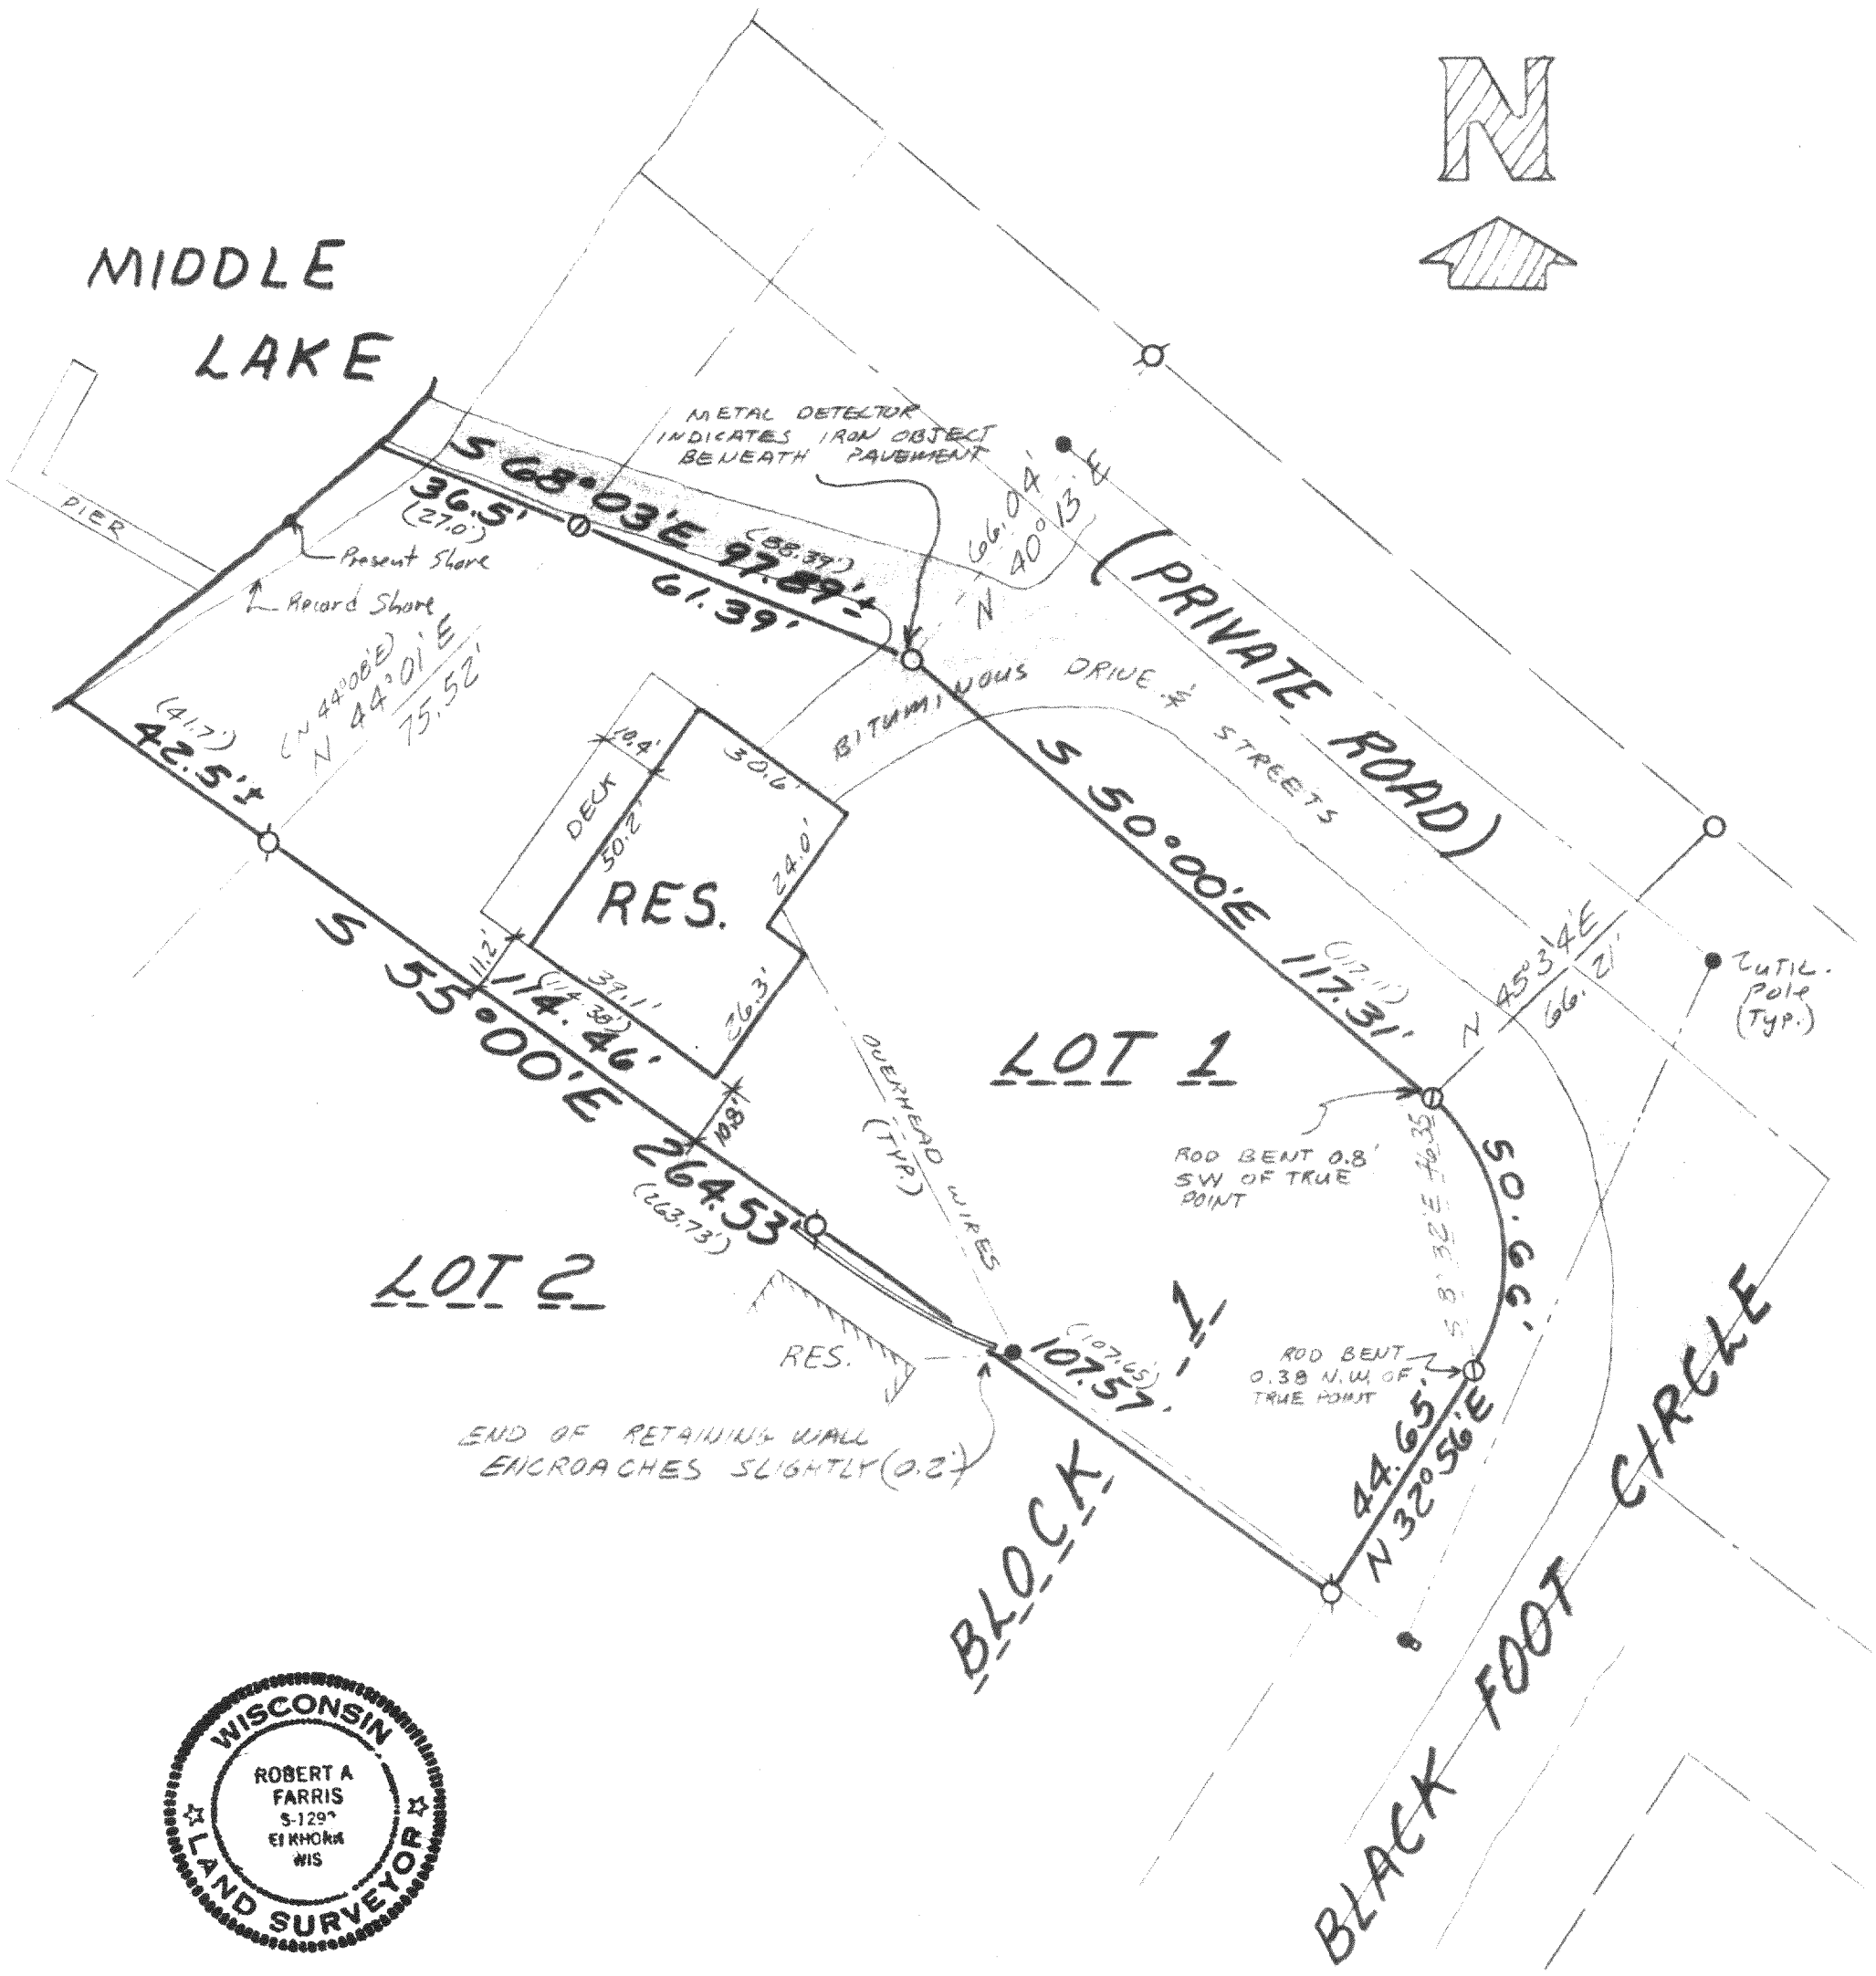

WISCONSIN
ROBERT A FARRIS
S-1297
ELKHORN WIS
LAND SURVEYOR

I hereby certify that the above described property has been surveyed under my direction and that the above map is a true representation thereof and shows the size and location of the property, its exterior boundaries, the location of all visible structures and dimensions of all principal buildings thereon, boundary fences, apparent easements, roadways and visible encroachments, if any. This survey is made for the use of the present owners of the property, and also those who purchase, mortgage, or guarantee the title thereto within one year from the date hereof.

DATED MAY 18, 1987 Robert A. Farris PROJ. NO. 5806

HCH-1 416-439