
D D Cooper & CO., INC
Rt 4 Box 508B * Elkhorn WI 53121

RECEIVED
JUN 30

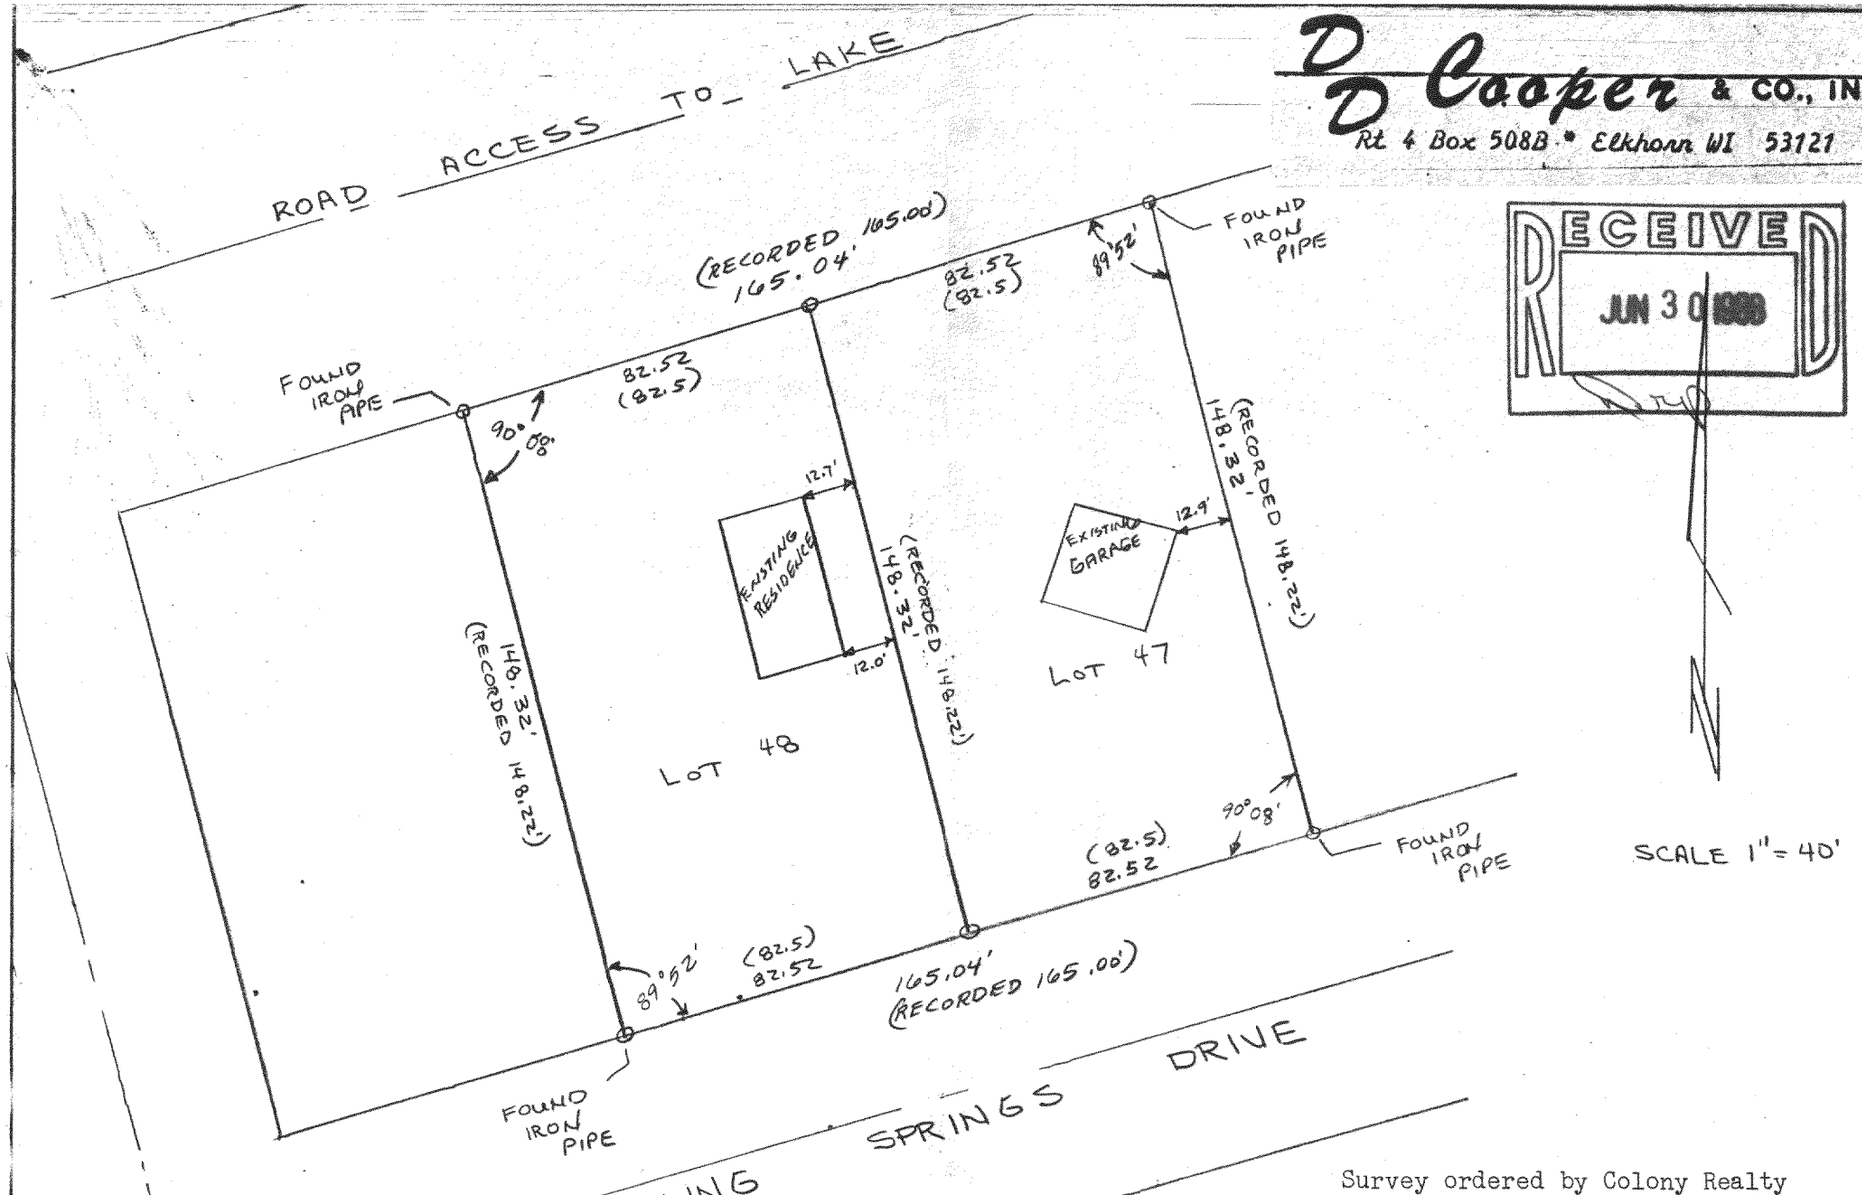

Survey ordered by Colony Realty

Plat of Survey of Lots 47 and 48 Bubbling Springs Subdivision, 1st Addition, Walworth County, Wis.

WISCONSIN
DANIEL D. COOPER
S-1464
WIS.
LAND SURVEYOR

I hereby certify that I have surveyed the property described hereon and that the map shown hereon is a true and accurate representation thereof to the best of my professional knowledge and belief.

Dated this _____ day of _____, _____

Daniel D. Cooper, RLS No. S-1464

DRAWING NO. 3250-11-55

416-506

#851-16,17